

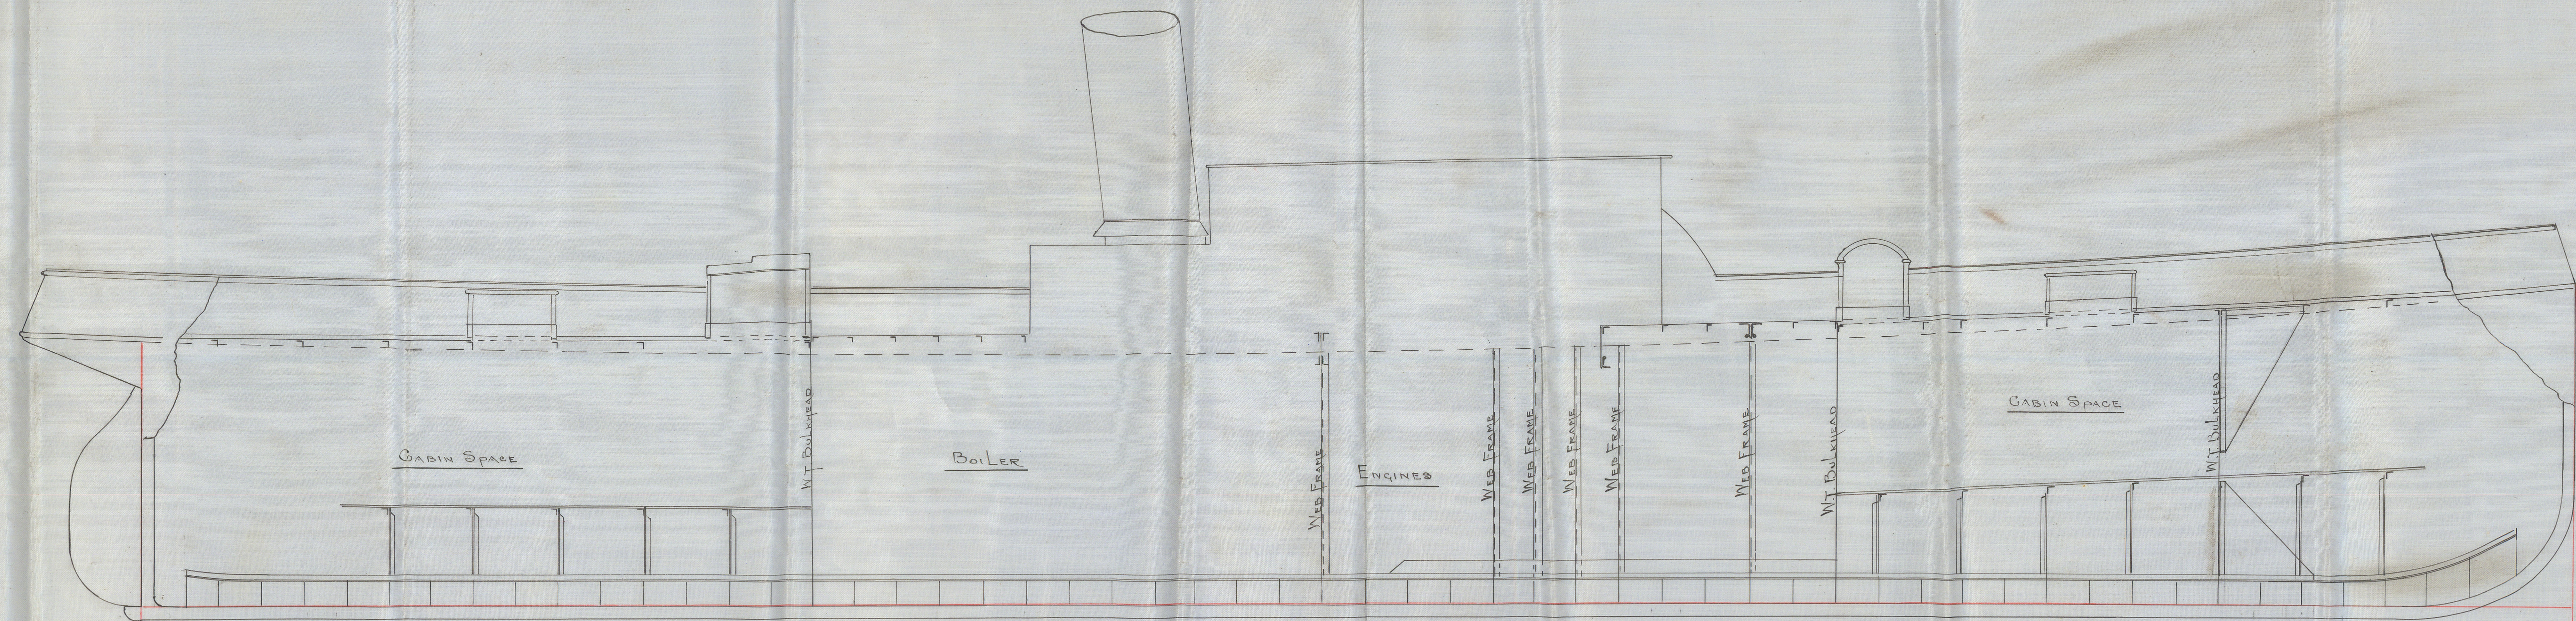


1005 REGISTER OF  
SHIPS  
1880-1890  
15-3-03

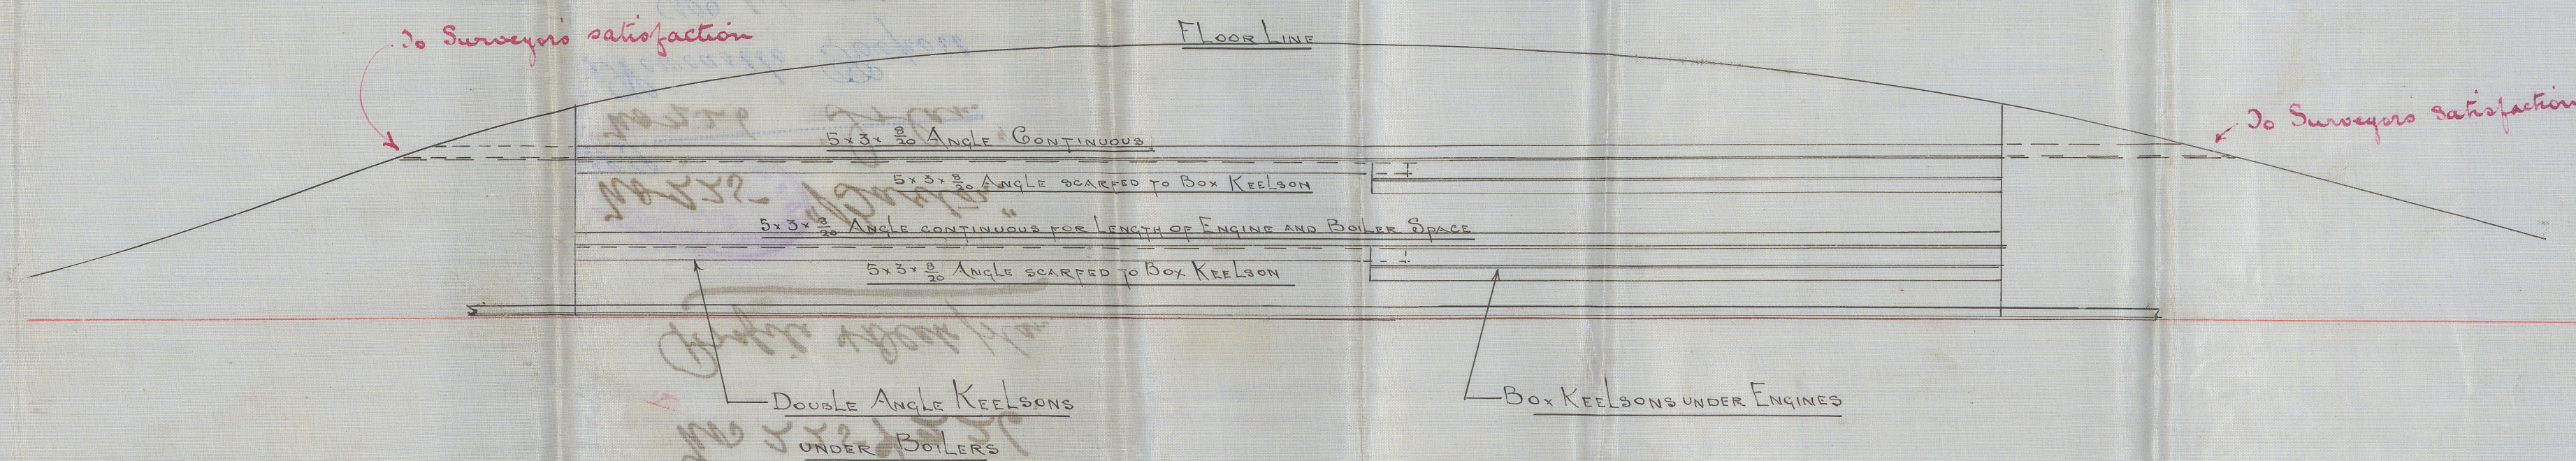

— RENOLDSON'S N<sup>OS</sup> 225 AND 226 —  
— PROFILE AND DECK PLAN —  
— STEEL RADDLE TUG —  
— DIMENSIONS 100 x 20'6" x 10'4" MLO —  
— SCALE 1/4" = 1'00" —

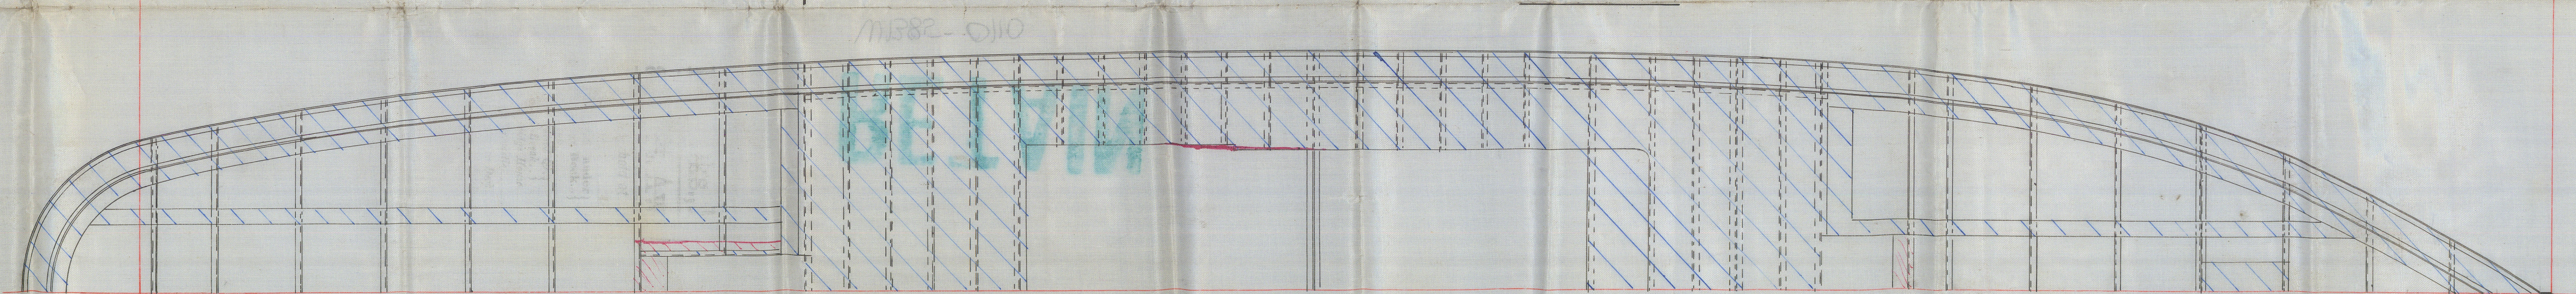

C.B.  
24.3.03

W1385-0110



Miss Rensselaer,

No 225 & 226.

Profile & Deck plan.

No 225 "Barton."

J.S. No 226 "Irlan."

Newcastle Report

No 46.001

J.S. Irlan

Newcastle Report

No 46.192

LR

© 2021

Lloyd's Register  
Foundation

W1385-0110