
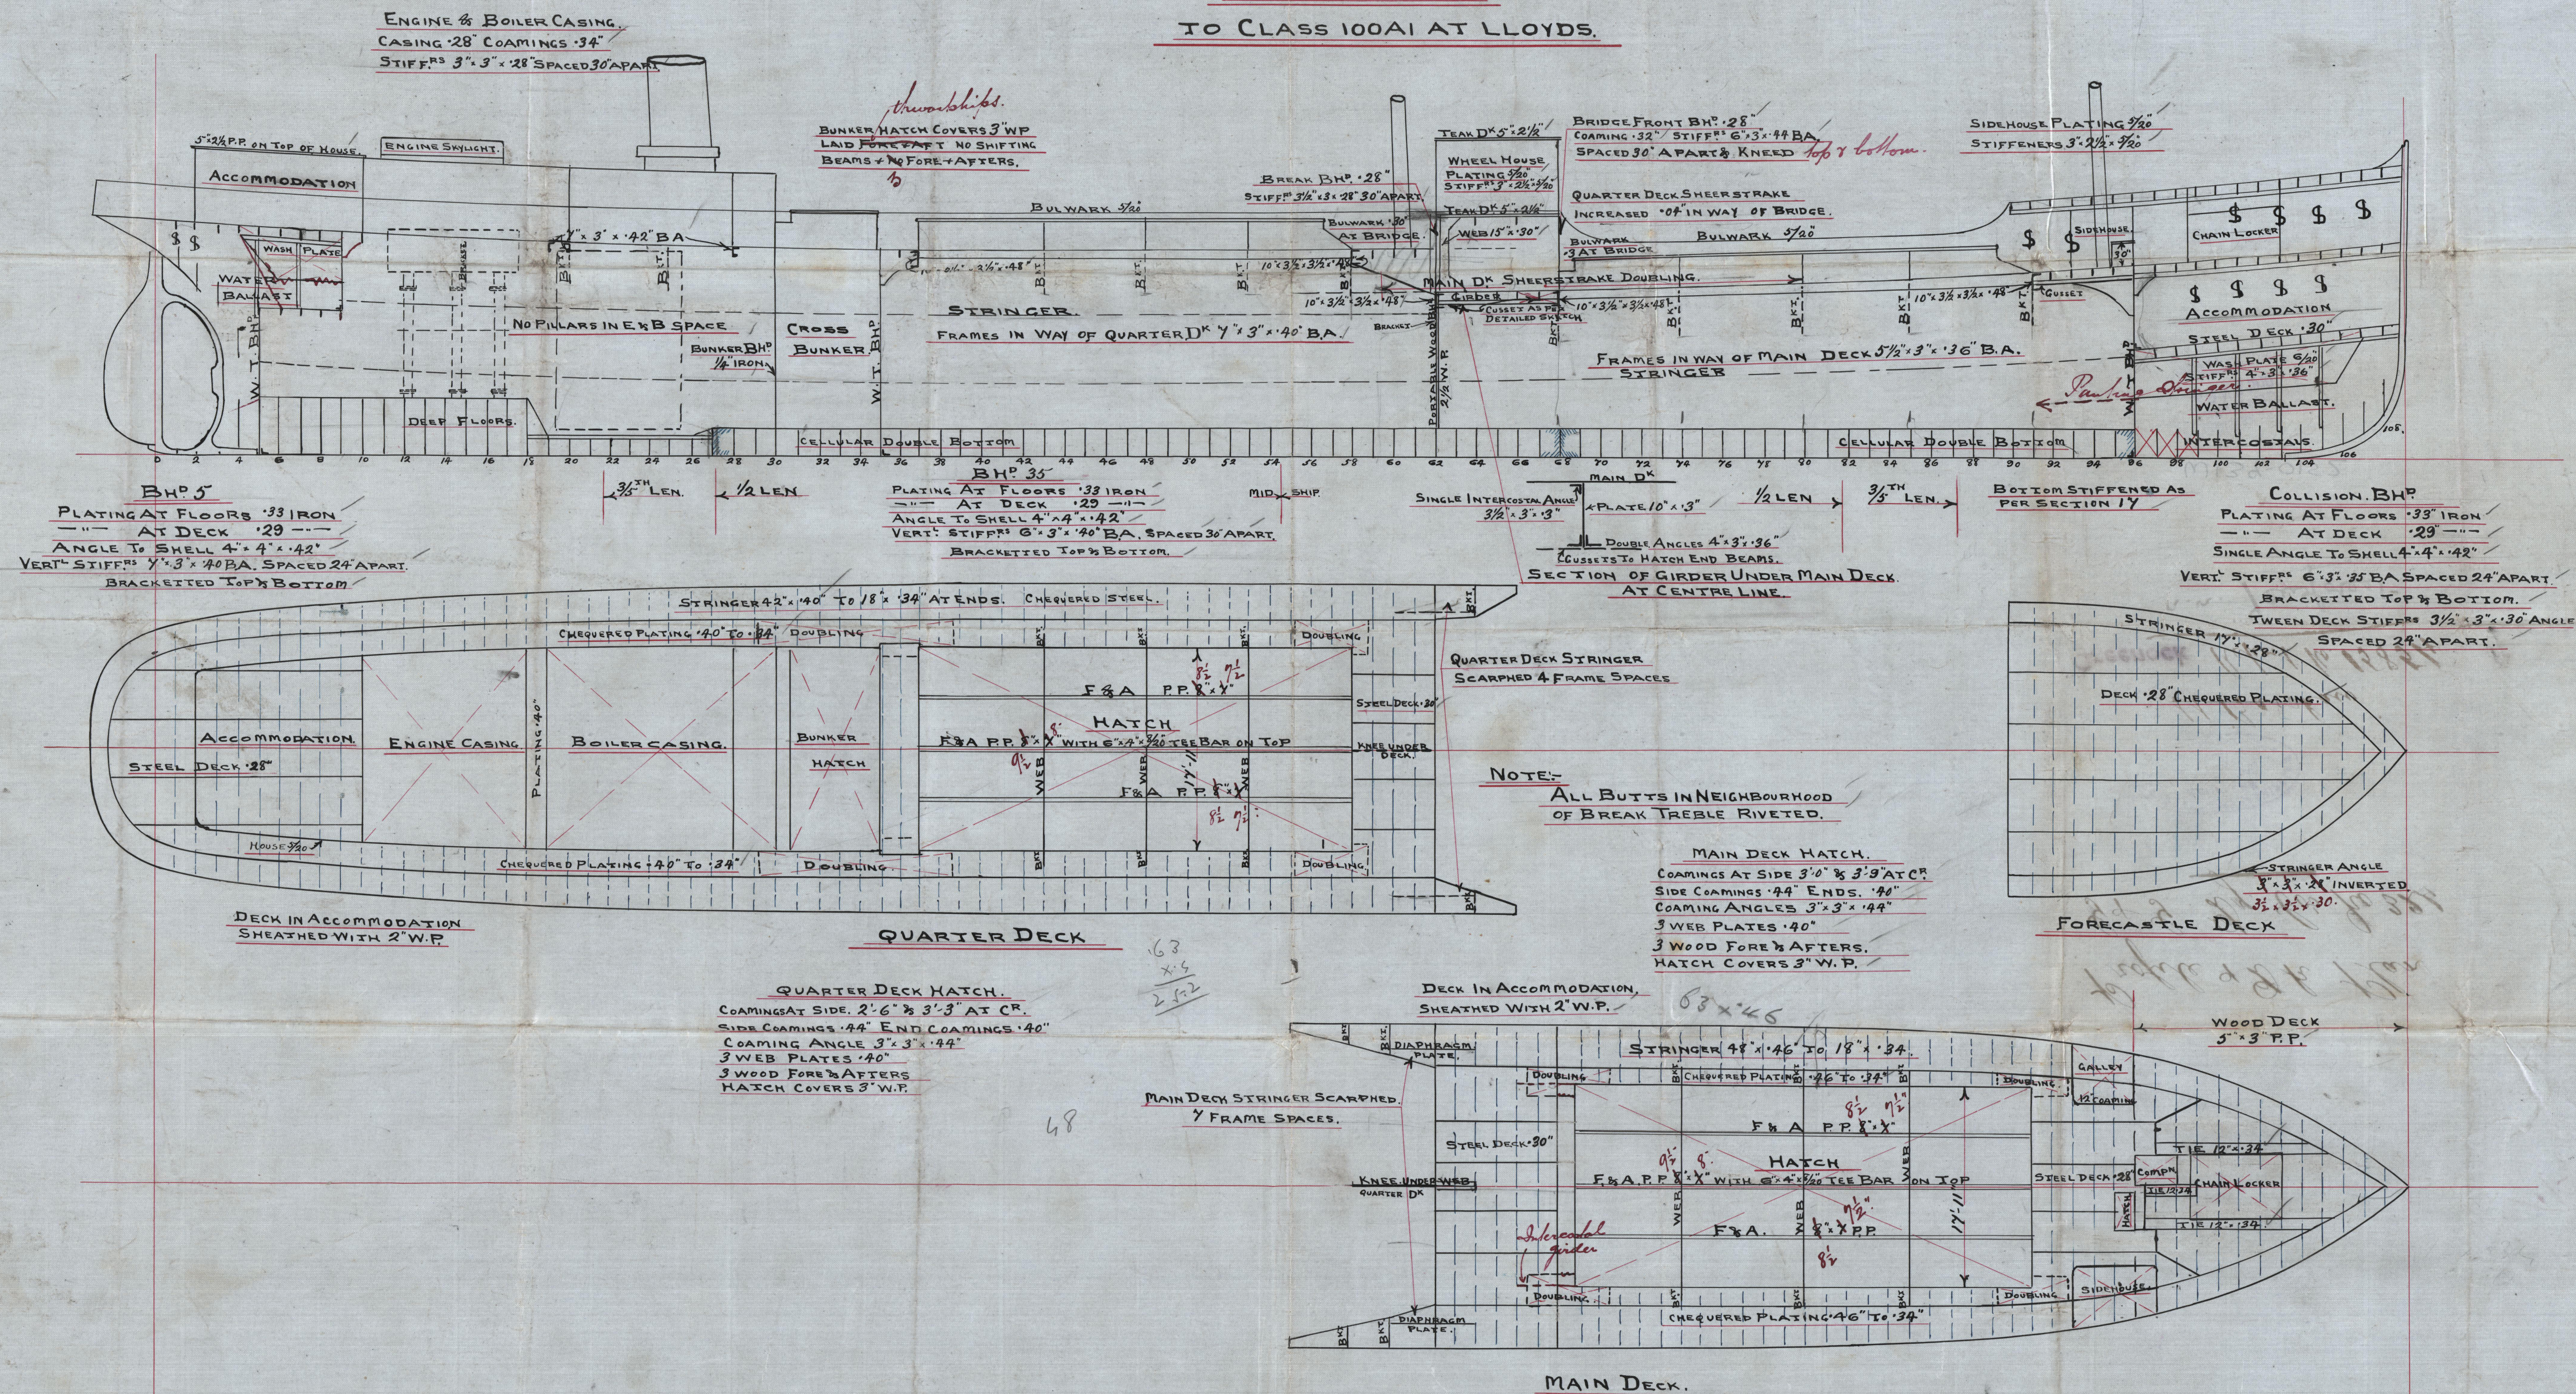


TO CLASS 100A1 AT LLOYDS.


14. 2. 10
21. 2. 10
5. 3. 10

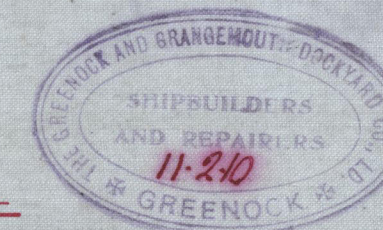

C.7.
14/2/10

Profile & Dk Plan

G & G Dy. Co's No 324

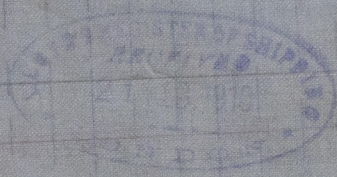

U. B. Arkhau

Greenock Report No. 15854

n.n. "Yewforest"

W139-0152



©2021

Lloyd's Register
Foundation