

S.S. N° 324

MIDSHIP SECTION

SCALE 1/2 inch = 1 Foot.

EQUIPMENT

(30+14.33) x 199.83 =	8858
QUARTER DECK 11.5 x 4.25	482
BRIDGE 11 x 7.00 x 7.5	57
FORECASTLE 35 x 6.75 x 7.5	177
Houses & E&B (ASING 55 x 6.5 x 50)	178
9752 N° FOR EQUIPMENT.	

- 2 BOWER ANCHORS @ 2 1/4 (WTS. STOCKLESS.)
- 1 " " " " @ 18 " " " "
- 1 STREAM " " @ 5 3/4 " " EX. STOCK.
- 1 KEDGE " " @ 2 3/4 " " " "
- 210 FATHOMS 1 1/16" STUO CHAIN CABLE.
- 60 " " 1 1/16" STREAM CHAIN OR 3/4" STEEL WIRE.
- 3 @ 90 FATHOMS 2 1/4" STEEL WIRE.
- 3 @ 90 " " 2 1/4 " " " "
- 90 FATHOMS 6" MANILLA.
- 4 SPRINGS 12" GIR EACH 7 FATHOMS.

DIMENSIONS.

199' 10" B.P. x 30' 0" MLD. x 14' 4" MLD TO MAIN DECK.
18' 7" MLD TO QUARTER DECK.
TO CLASS 100A1 AT LLOYDS.

NUMERALS.

$$30 + 14.33 = 44.33 \text{ TRANSVERSE N°}$$



$$d = 11.75$$

$$199.83 \times 44.33 = 8858 \text{ LONGITUDINAL N°}$$

$$\frac{L}{D \text{ TO MAIN DECK}} = \frac{199.83}{14.33} = 13.934$$

$$\frac{L}{D \text{ TO QUARTER DECK}} = \frac{199.83}{18.58} = 10.75$$

$$d = 16.00 \text{ IN WAY OF QUARTER DECK.}$$

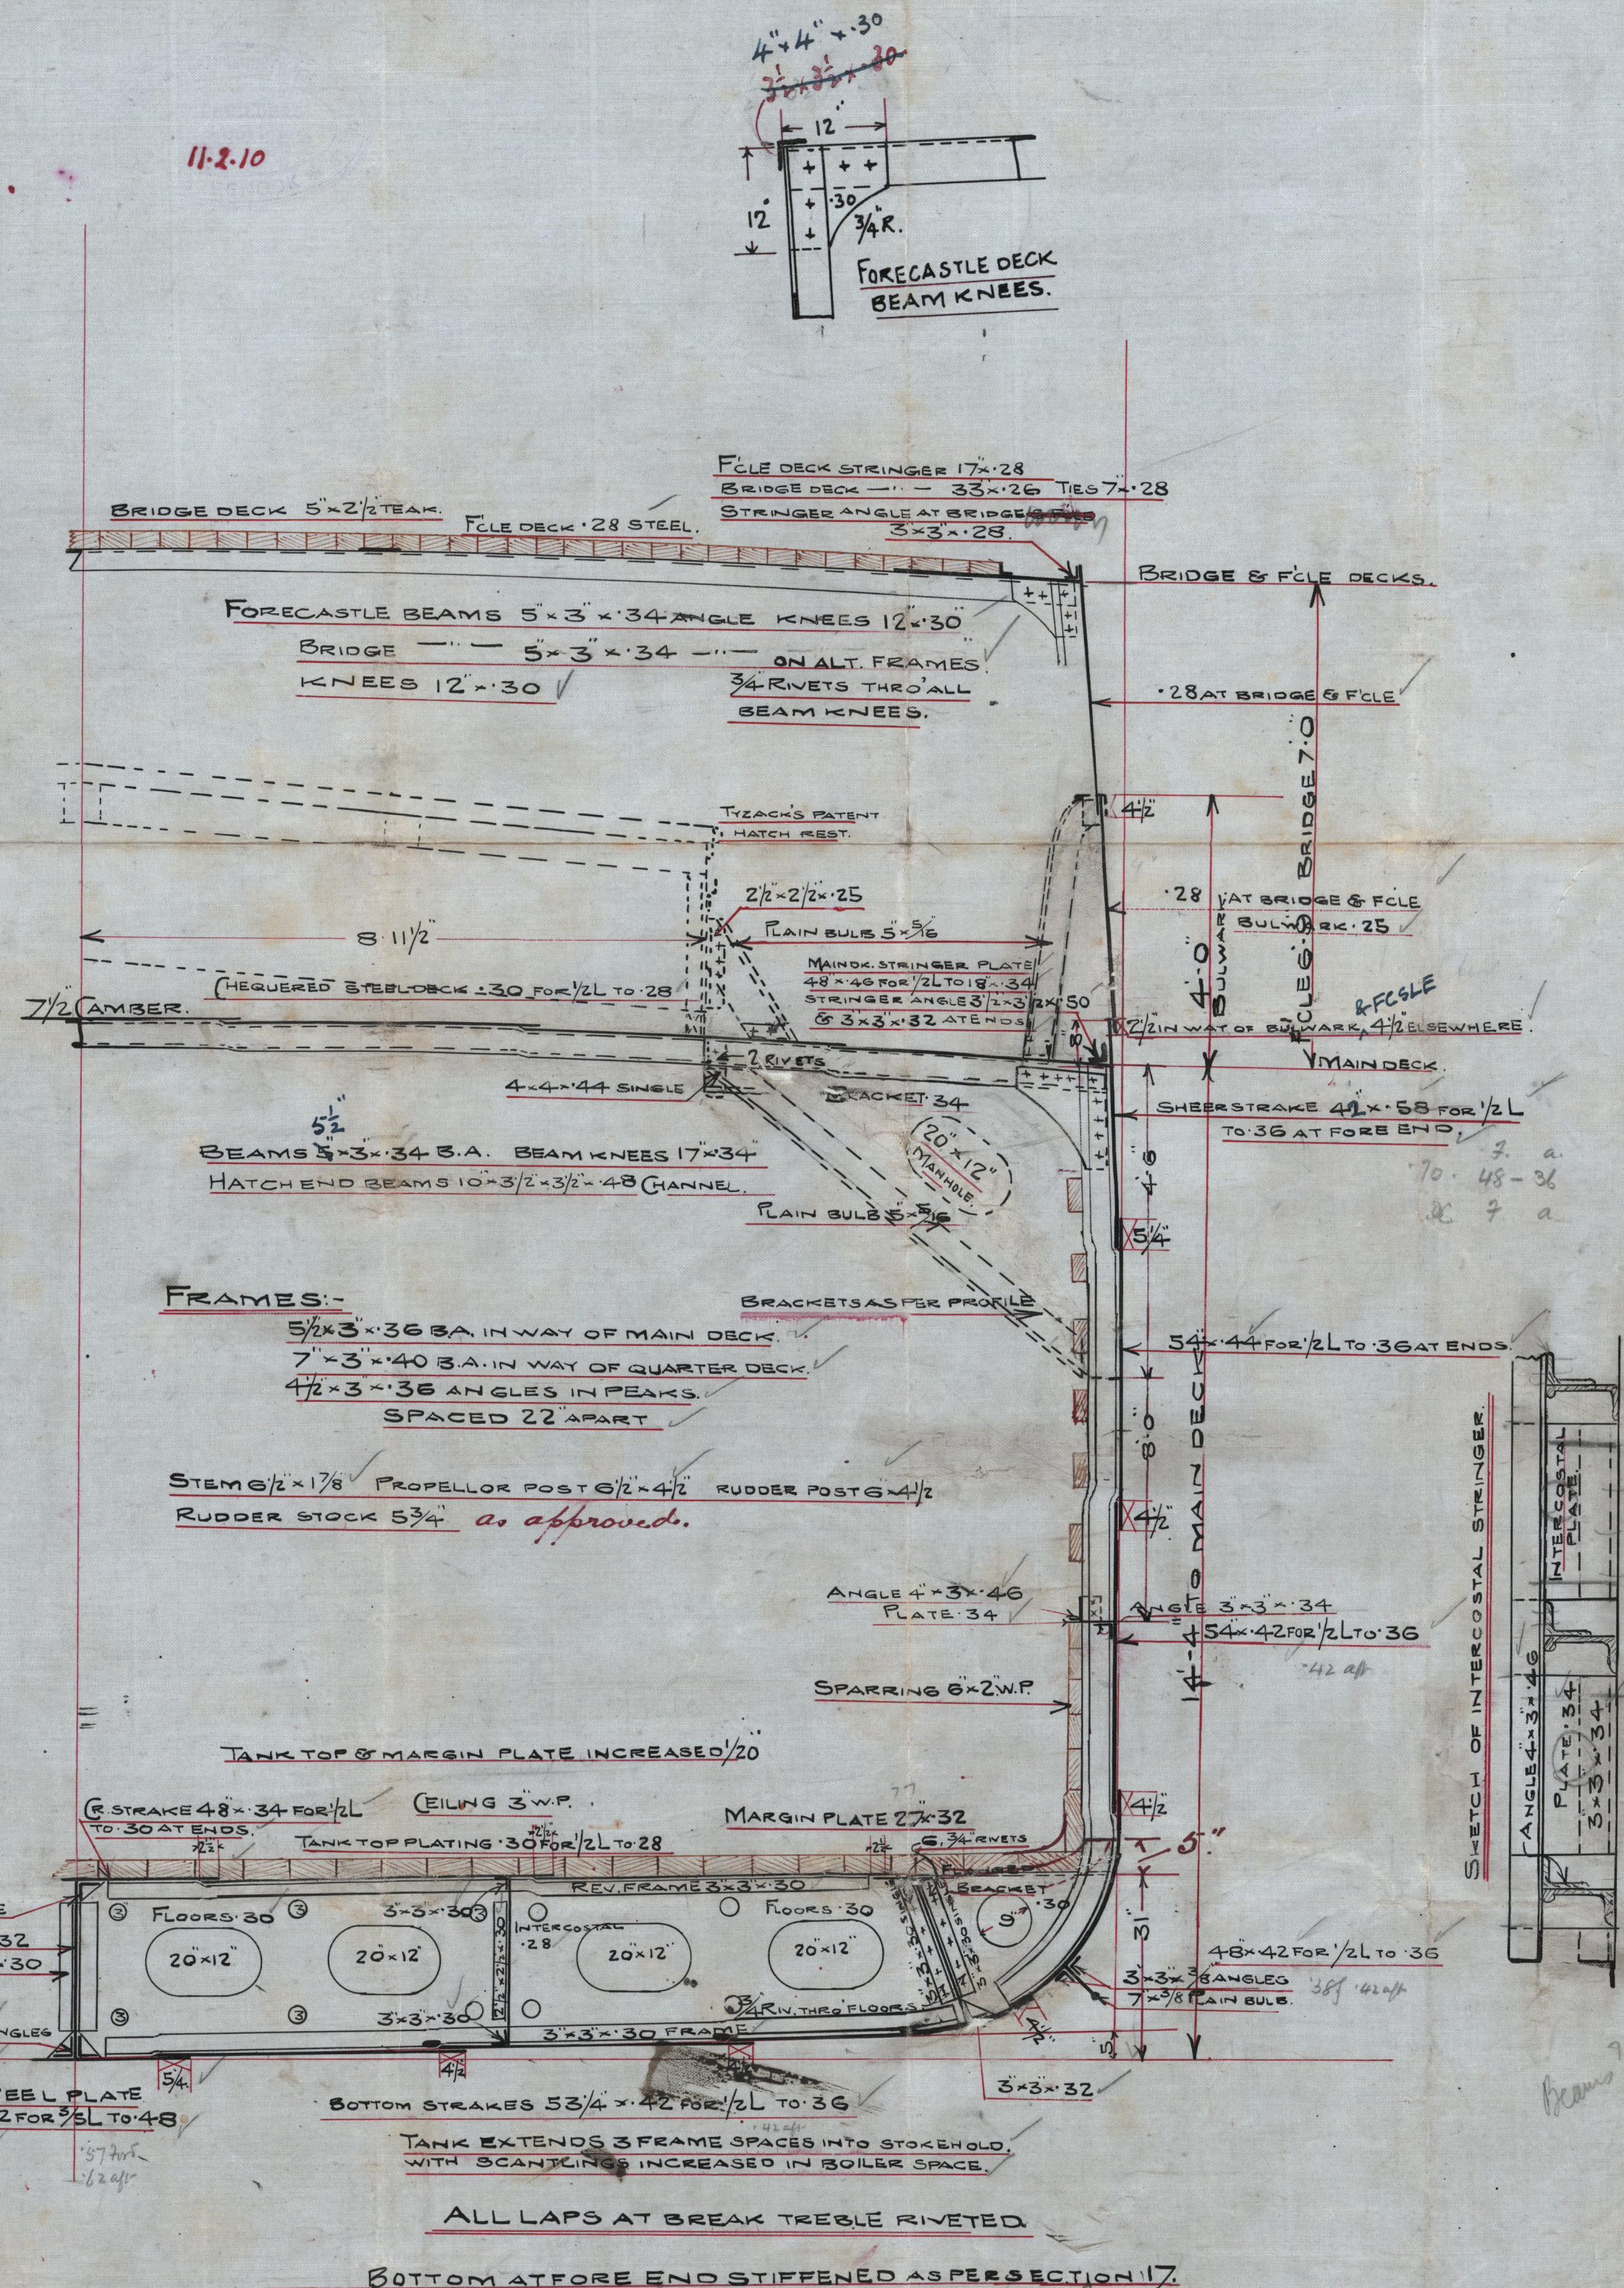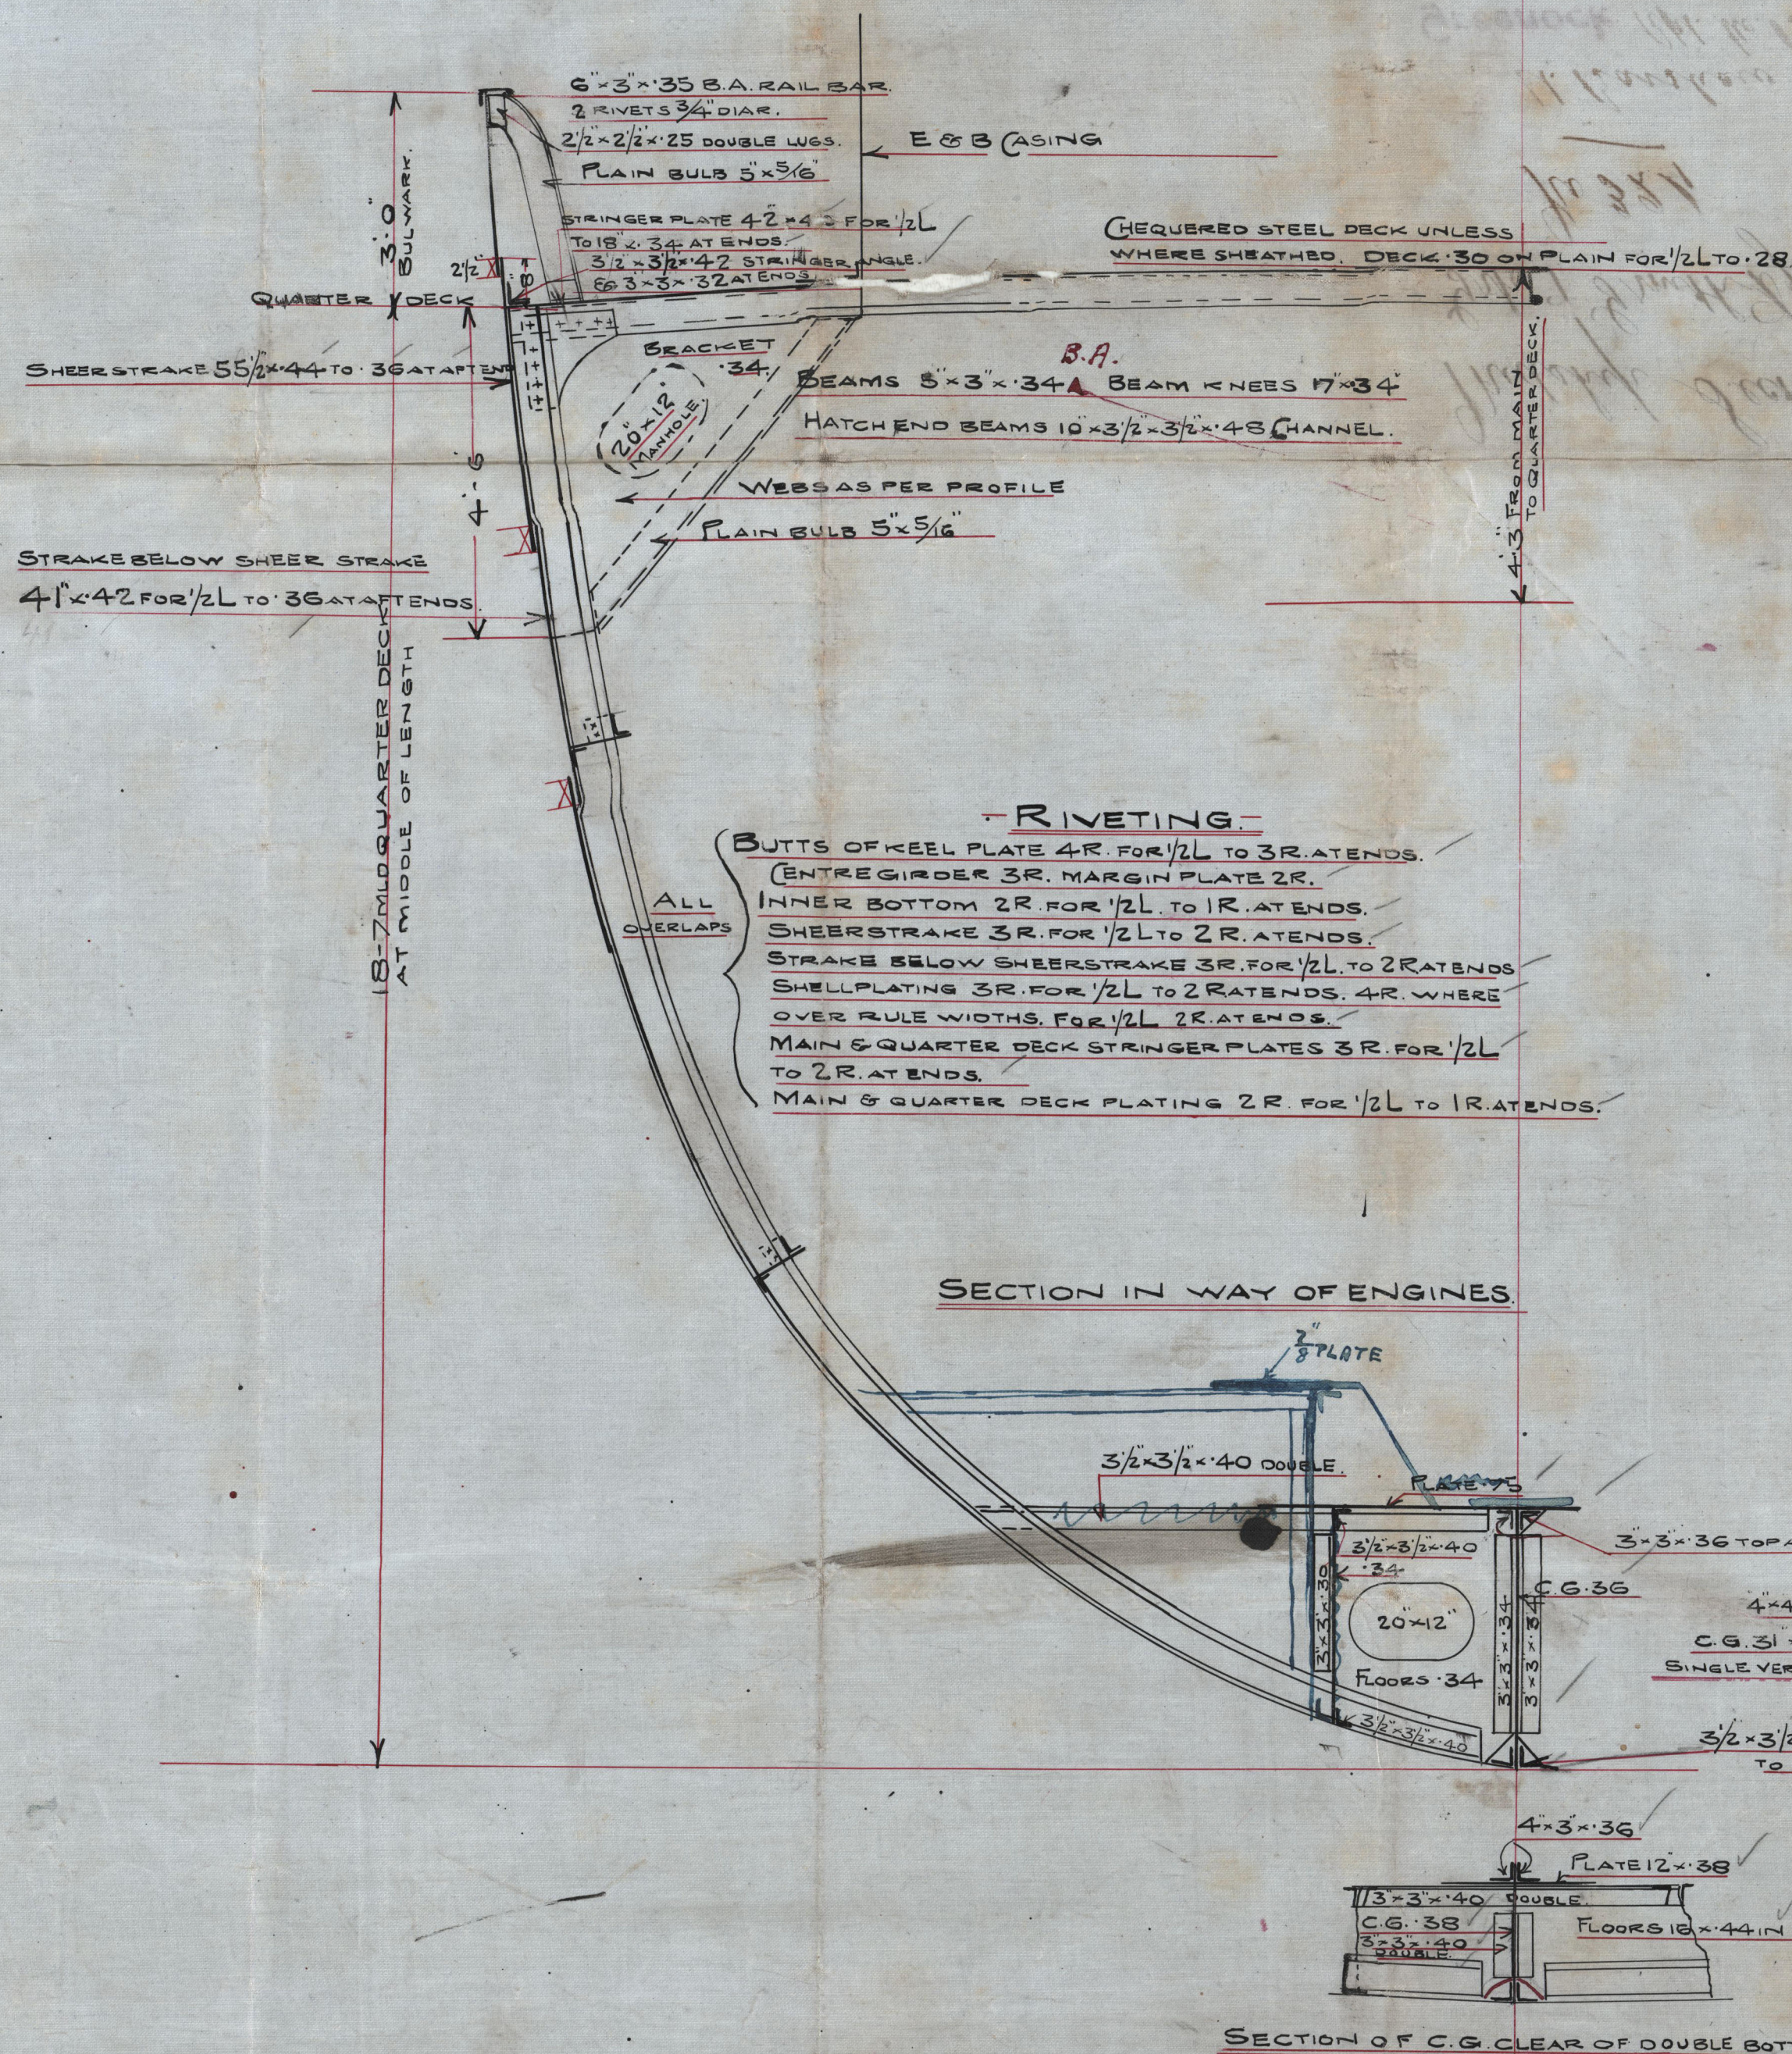


W139-0153

Midship Section
Grk 7 Growth Dy Cos
No 324

U. Barshaw
Greenock Rpt. No. 15856

n.n. Newforest
21 FEB. 1910

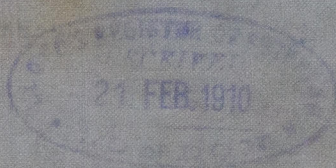

W139-0153

TO CIVIL 100

100-081-2000

DIR

2000



Lloyd's Register
Foundation