

*Midship Section
No. 478
15-9-10*


MIDSHIP SECTION.

Nº 478.

DIMS 115'-0" x 21'-6" EX x 12'-3" MHD
SCALE 1/2" = ONE FOOT

PLAN No. 9617
FOR ENCLOSURE TO
Merino Lloyd's Register
FROM
COCHRANE & SONS,
SHIPBUILDERS,
DATE 12/9/10 *RR*

- TO CLASS 100 A1 AT LLOYDS FOR FISHING PURPOSES.
- DECK PLATED OVER IN WAY OF MACHINERY SPACE.
- ENGINE & BOILER CASING AS PREVIOUSLY APPROVED.

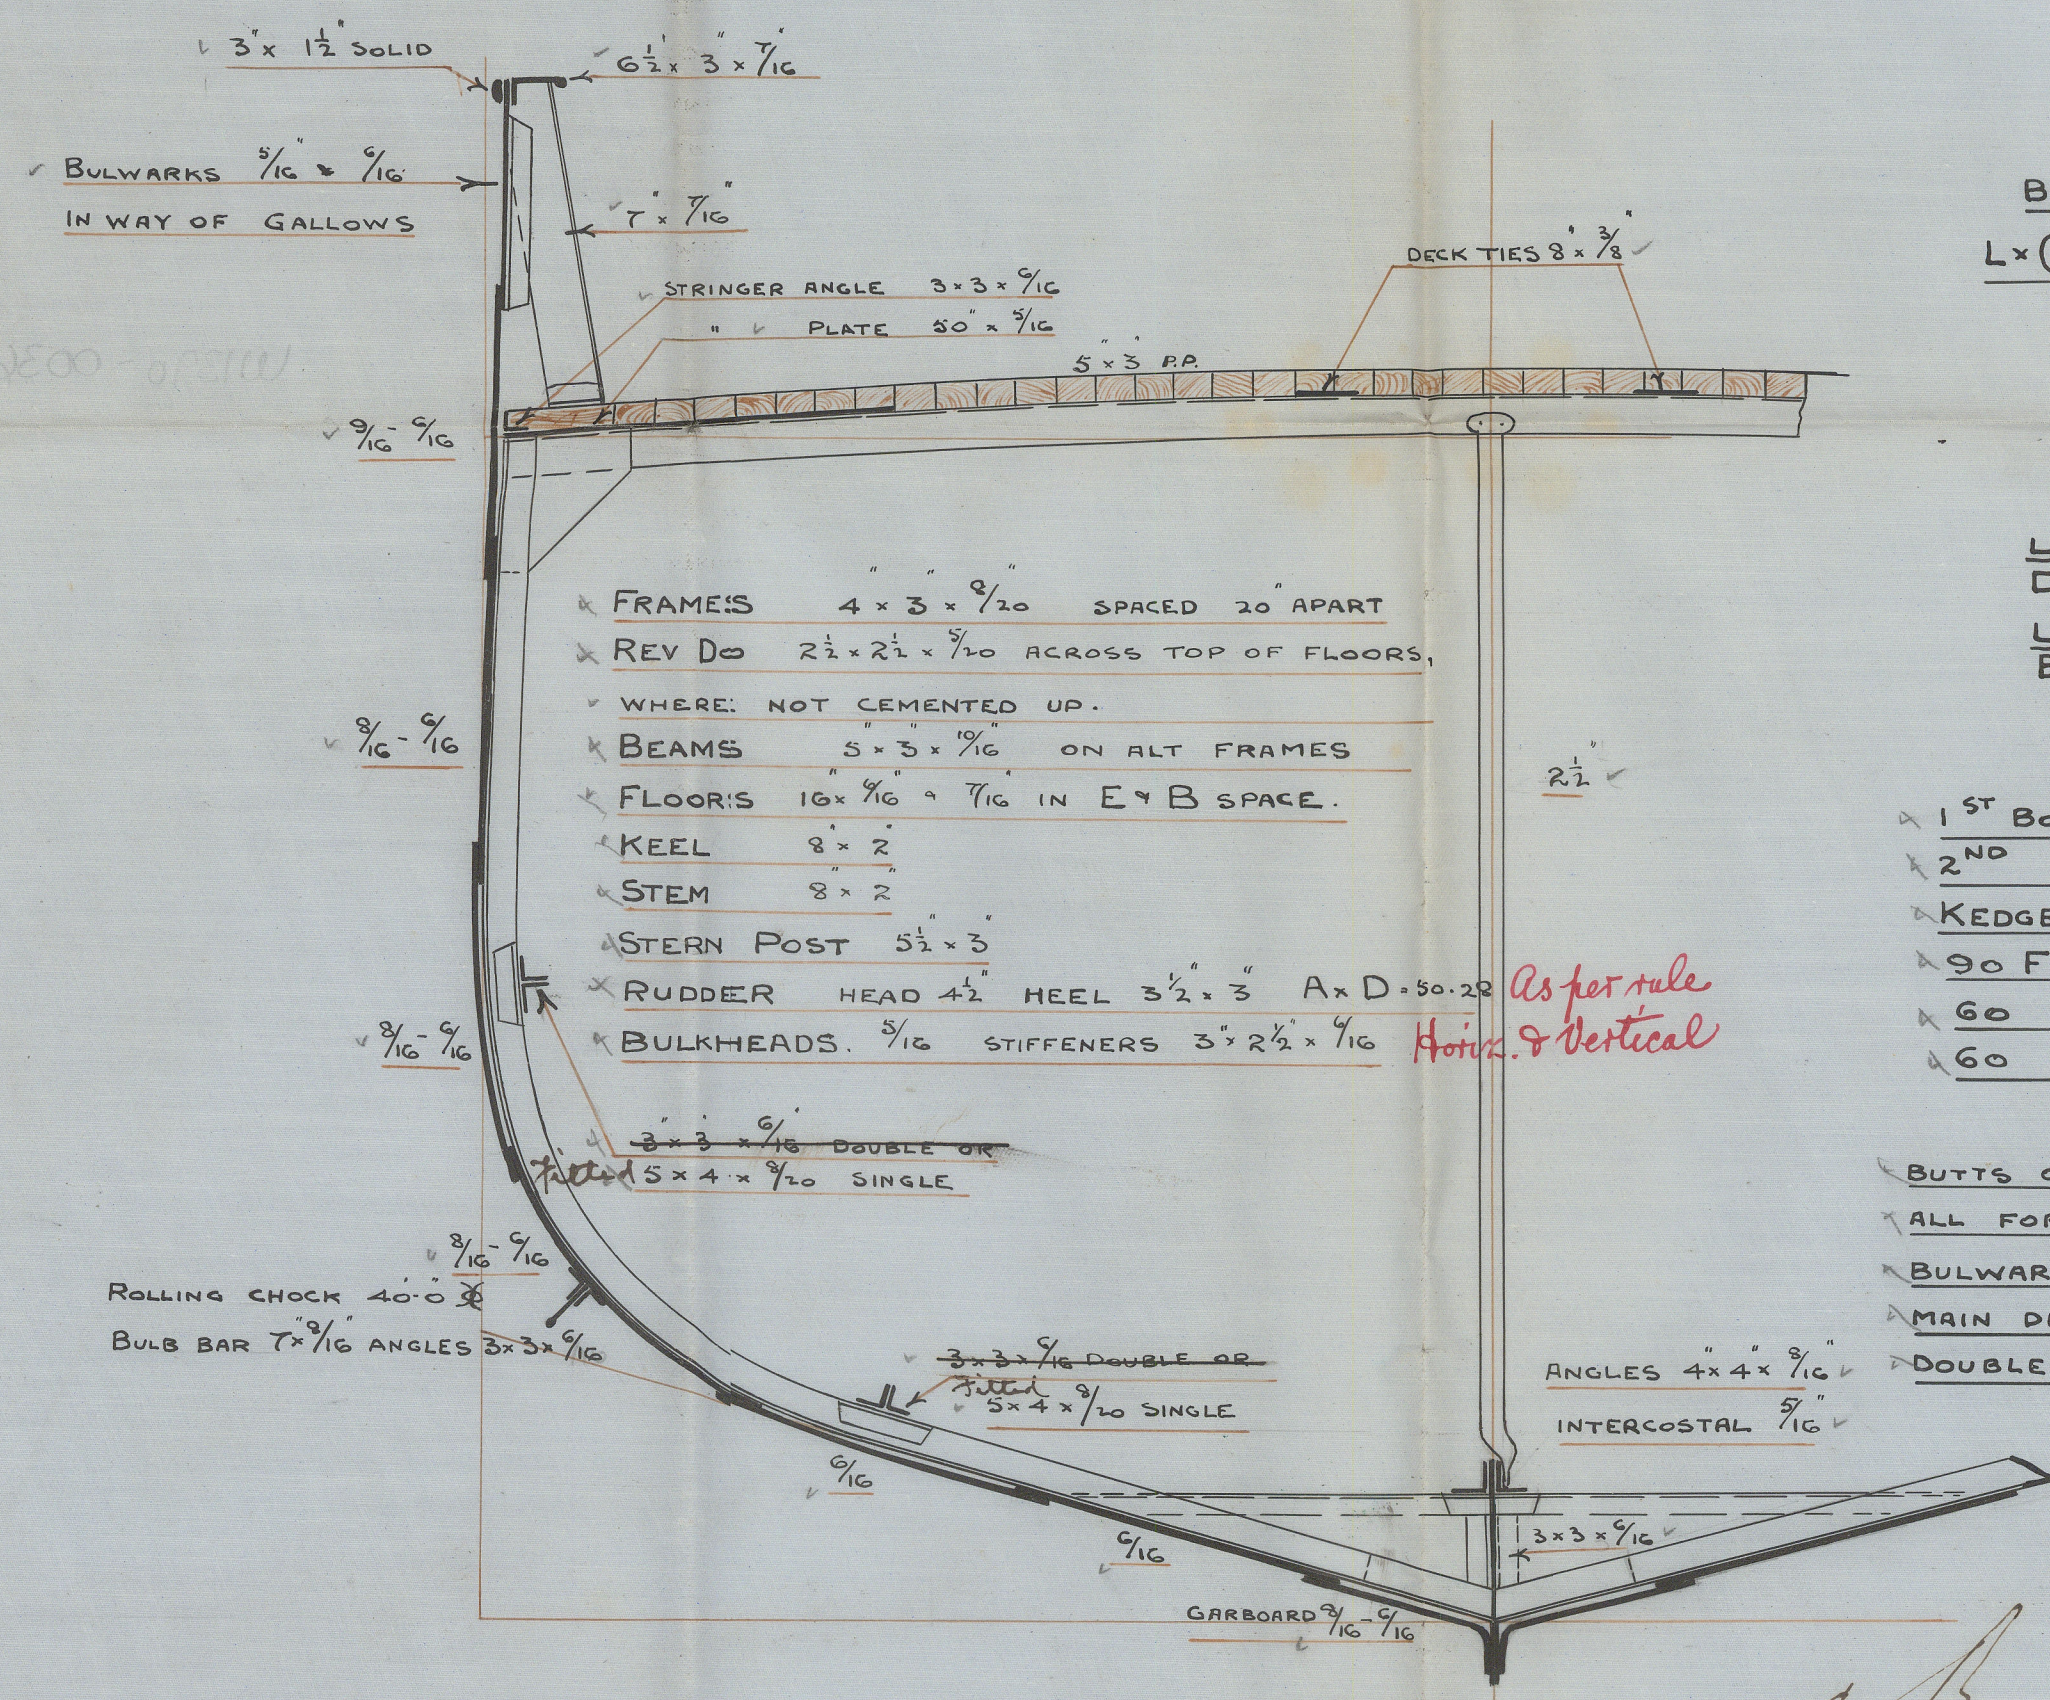

NUMERALS.

B + D = 33.62
L x (B + D) = 3866.30

PROPORTIONS

L/D = 9.38
L/B = 5.38

EQUIPMENT

1 ST BOWER ANCHOR	5 CWT'S EX STOCK
2 ND " "	4 1/2 " " "
KEDGE ANCHOR	2 1/2 "
90 FATHOMS	1" CABLE
60 " "	5 1/2 " HAWSER
60 " "	4' WARP

RIVETING

- BUTTS OF SHELL STRAPPED & DOUBLE RIVETED
- ALL FORE & AFT. LANDINGS DOUBLE RIVETED.
- BULWARK BUTTS & LANDING SINGLE RIVETED.
- MAIN DECK STRINGER BUTTS OVERLAPPED & DOUBLE RIVETED.

LLOYD'S REGISTER
OF SHIPPING.
13 SEP. 1910
+ HULL +

14.9.10

13-9-10


Midship Section

Cochran & Sons

— 1/2 No. 478 —

1/2 Bern

Hull Report No. 23447

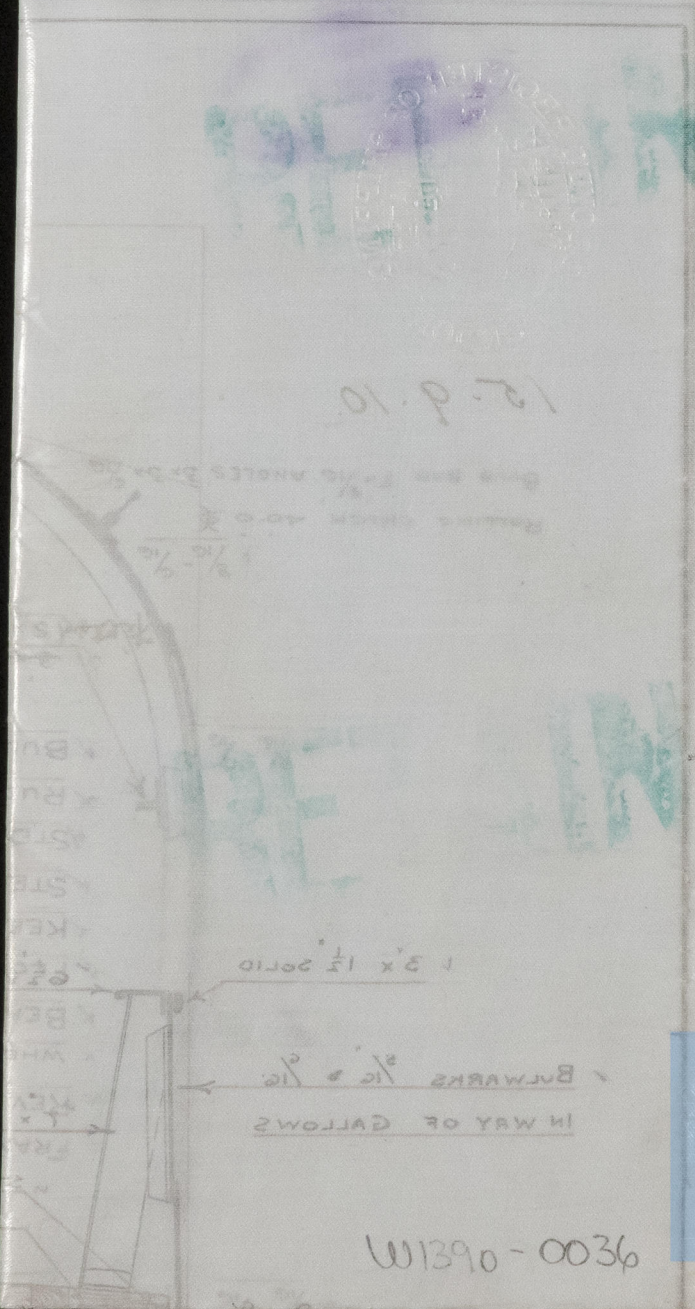

W1390-0036



© 2021

Lloyd's Register
Foundation