

SS N^o ~~207~~²¹³ BRADFORD CITY

TYPE B

CLASS 100 ALLIYDS

<u>DIMENSIONS</u>	
<u>LENGTH</u> B.P.	400'-0"
<u>BREADTH</u> M ⁴⁰	52'-0"
<u>DEPTH</u> M ⁴⁰ TO UPPER D ⁸	31'-0"
<u>DEPTH</u> M ⁴⁰ TO LOWER "	22'-0"

EQUIPMENT

Messrs Craig & Taylor H^{rs} &
No 213

Mid: Sec:

St. Bradford City


Indb report N^o 10343.

RETAIN

RETAIN

W1394-0028

W1394-0028

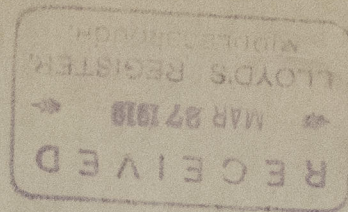

© 2021

Lloyd's Register
Foundation