

4.5.09.  
29.6.09.  
6.7.09.

PROPOSED TWIN SCREW STEAMER


40 x 54.6 x 34.0

PROFILE

Scale 3/32" = 1 foot



See Machinery Section for size of Mains fitted.

 

9 1/2 x 3 1/2 B.A. fitted  
4 x 3 1/2 on all frames  
reduced at ends as per rule.

Sketch showing arrangement at this point to be submitted

Painting Storage





J. Brown & Co

No 392

Profile

"Healandea"

GLASGOW REPORT No. 28871.

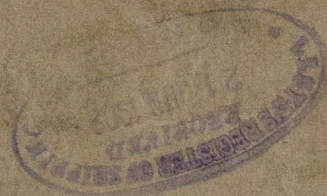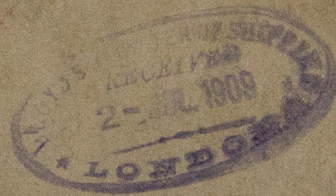

W140-0013



© 2021

Lloyd's Register  
Foundation