

No 106

S.S. No 106

# MIDSHIP SECTION.

## STEEL SCREW FLEETERS.

11.5.07 NUMERALS

|             |          |
|-------------|----------|
| 1/2 GIRTH   | 19.16    |
| DEPTH       | 13.00    |
| 1/2 BREADTH | 10.75    |
| 1ST NO      | 42.31    |
| LENGTH      | 108.875  |
| 2ND NO      | 4671.826 |

DIMS 110.08 x 21.6 x 12.6 M

SCALE 1/4" = 1 FOOT

TO CLASS 100 A.1 AT LLOYDS.

EQUIPMENT No 4671


|         |                      |
|---------|----------------------|
| ANCHOR  | 4 3/4 CWTs EX STOCK  |
| 1       | 4 1/4                |
| 2       | 2 1/2                |
| 30 FTMS | 5/16 STUD LINK CHAIN |
| 40      | 5/2 HAWSER           |
| 60      | 4 WARP               |

L/B = 5.06

L/D = 8.37

24/10/07  
A.M.  
VICTORIA SHIPYARD CO. LTD.

8/5/07  
A.M.

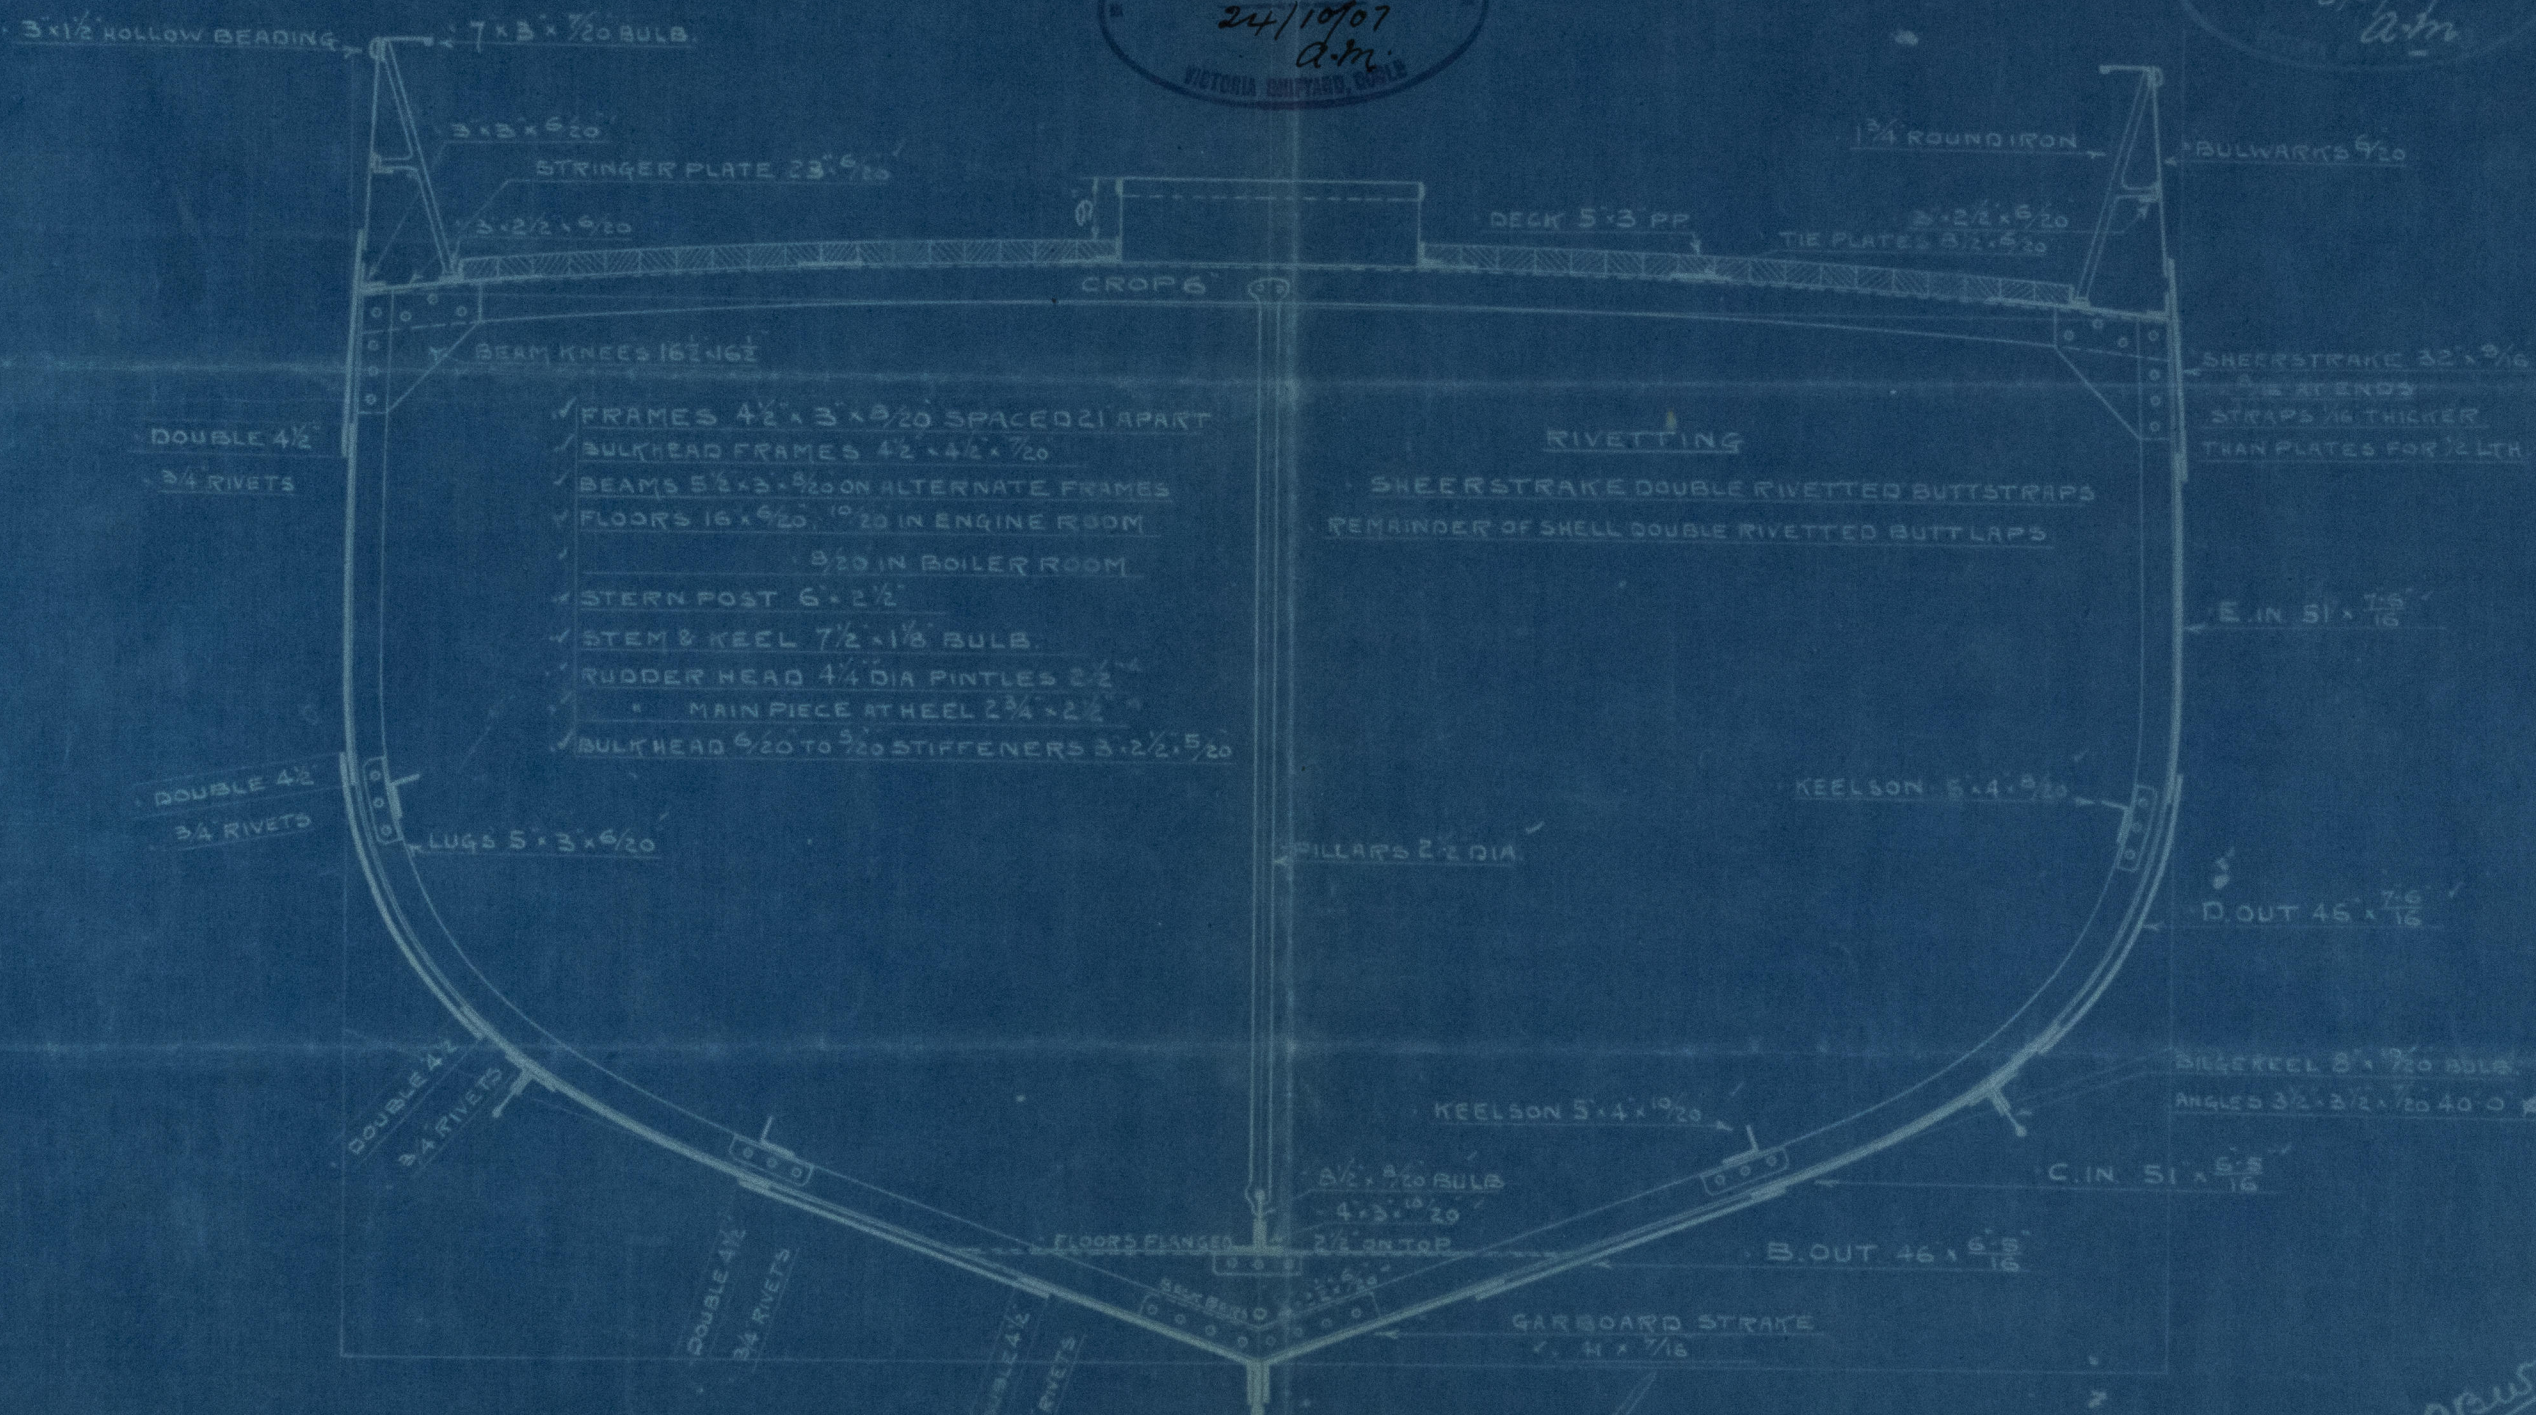

LR

0355  
9.5.07

Lloyd's Register  
Foundation



Boole S. & R. Co.

Midship Section.  
(Duplicate.)

Nº 99.101, 106, 7.8-9-10 + 11

Nº 106 "Buggard".

Hull Report No. 19680

RETAIN

