
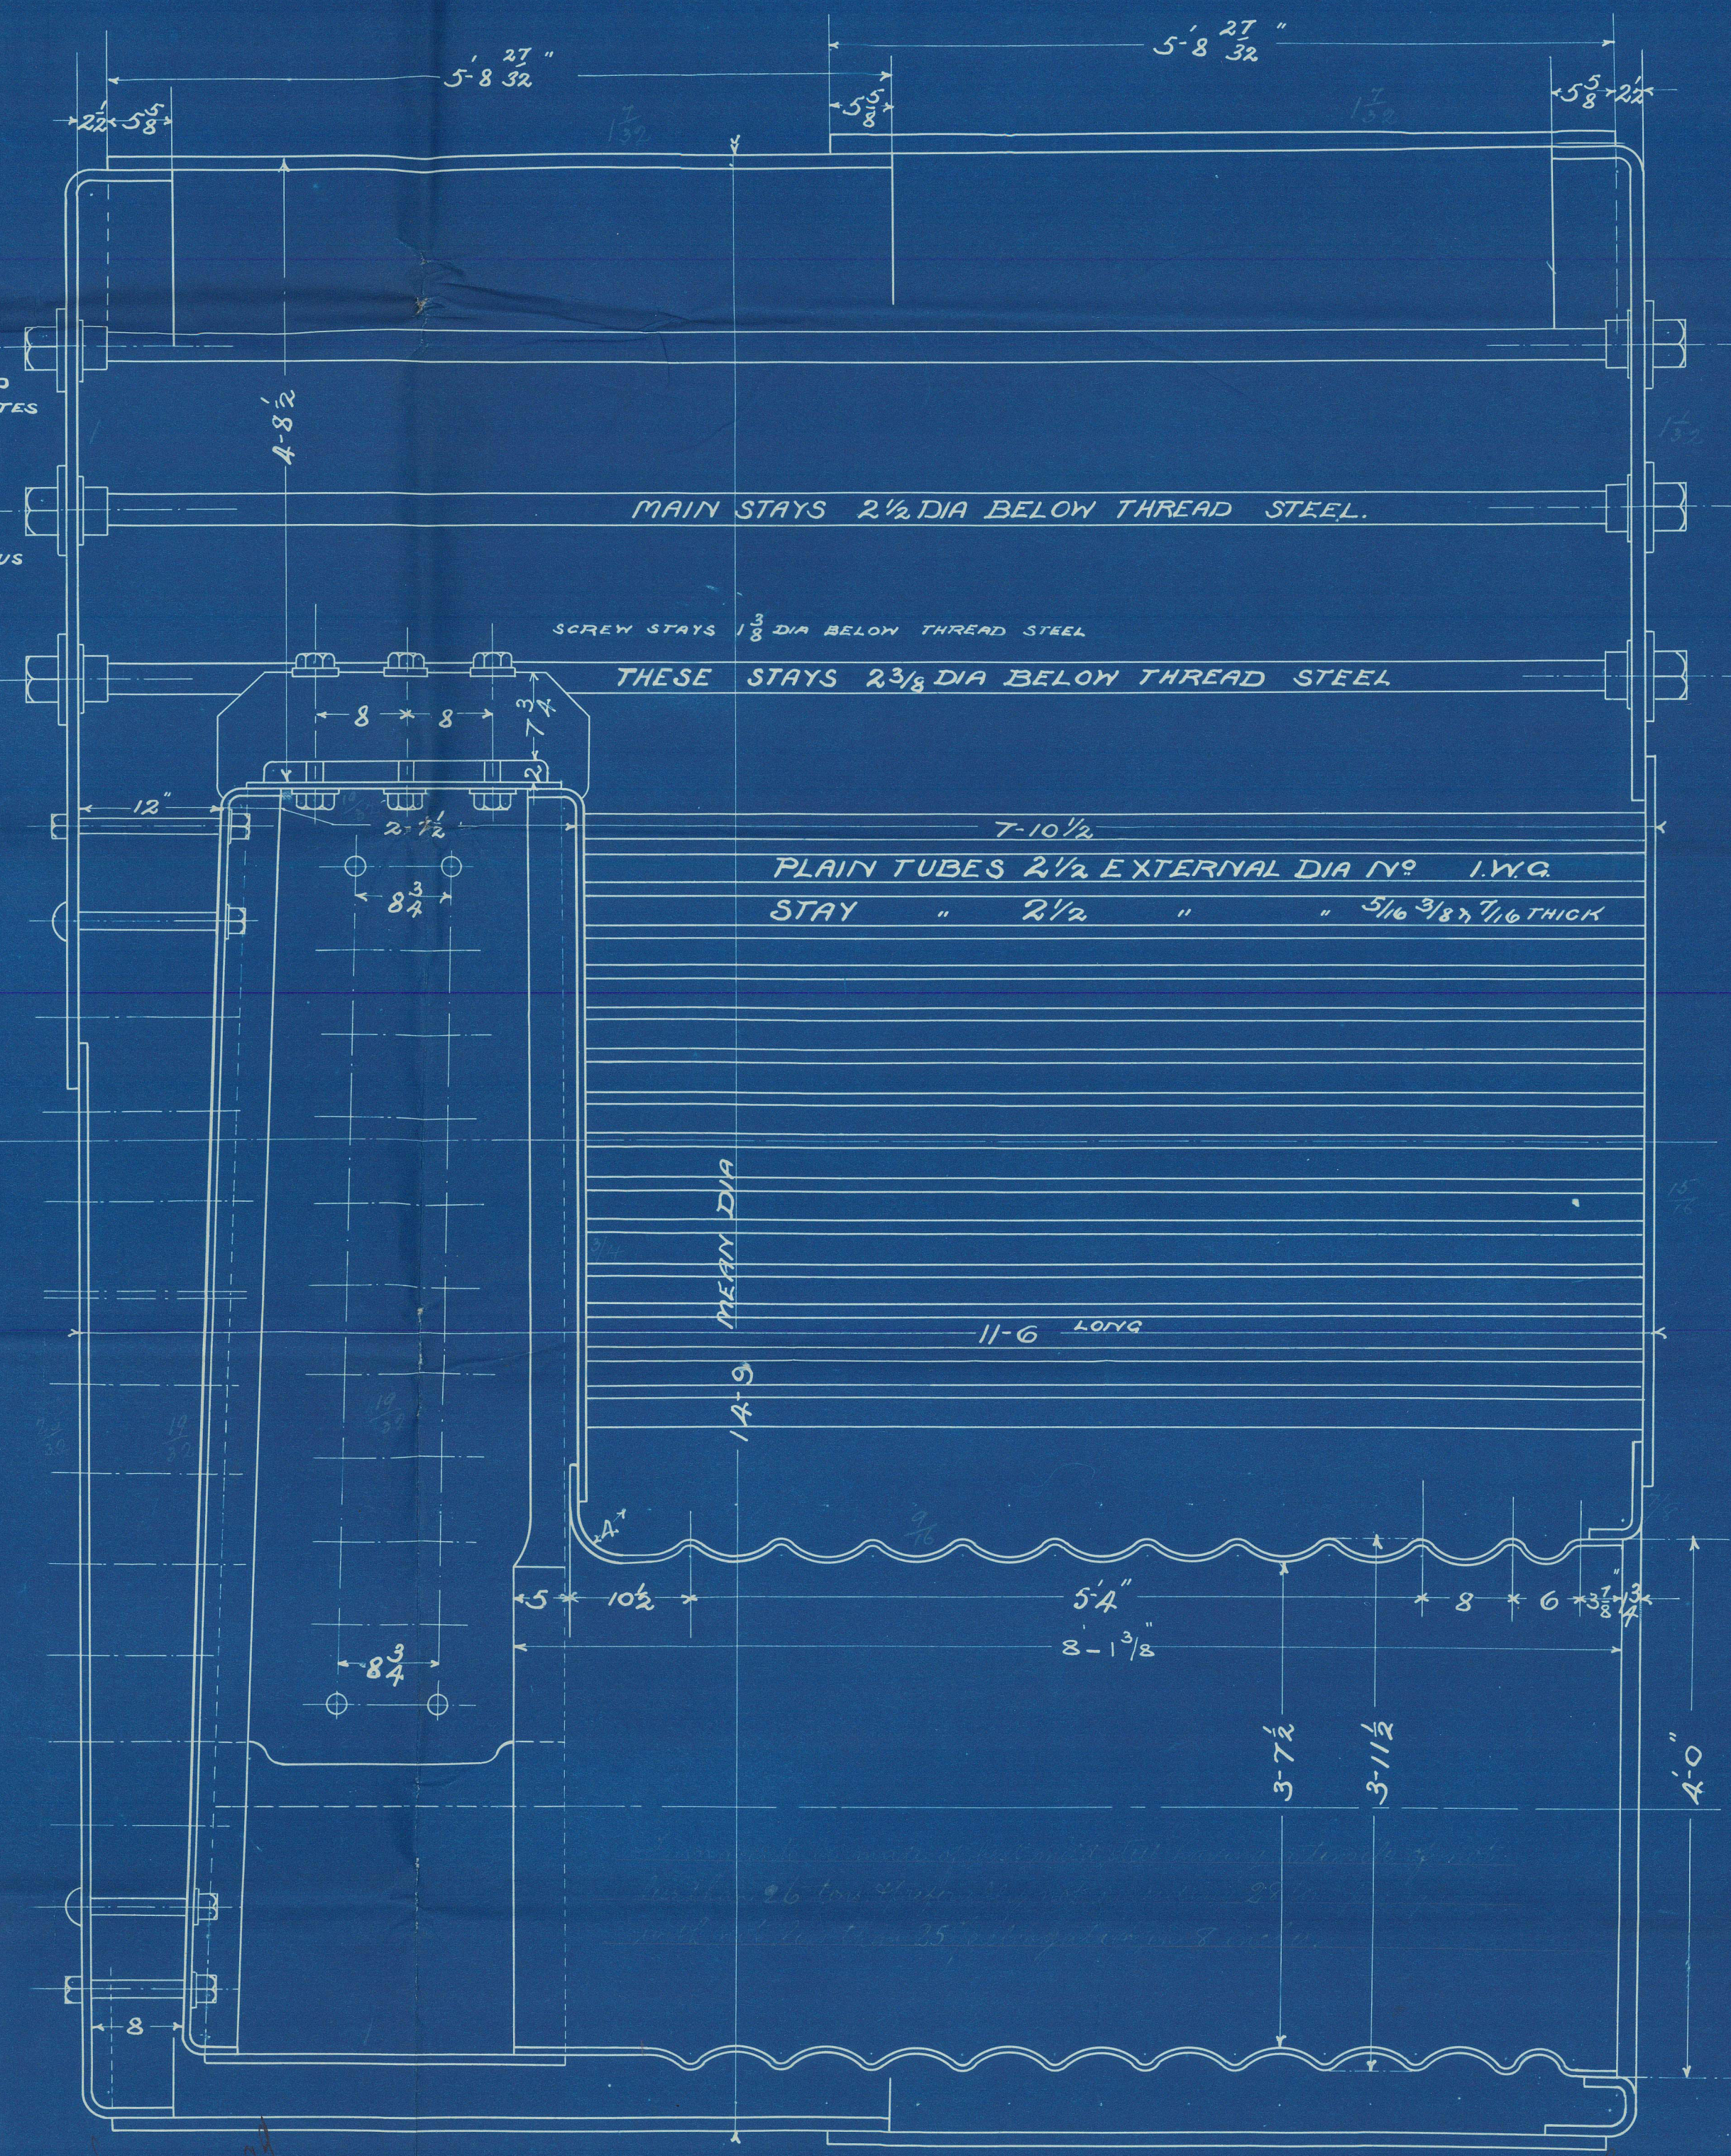
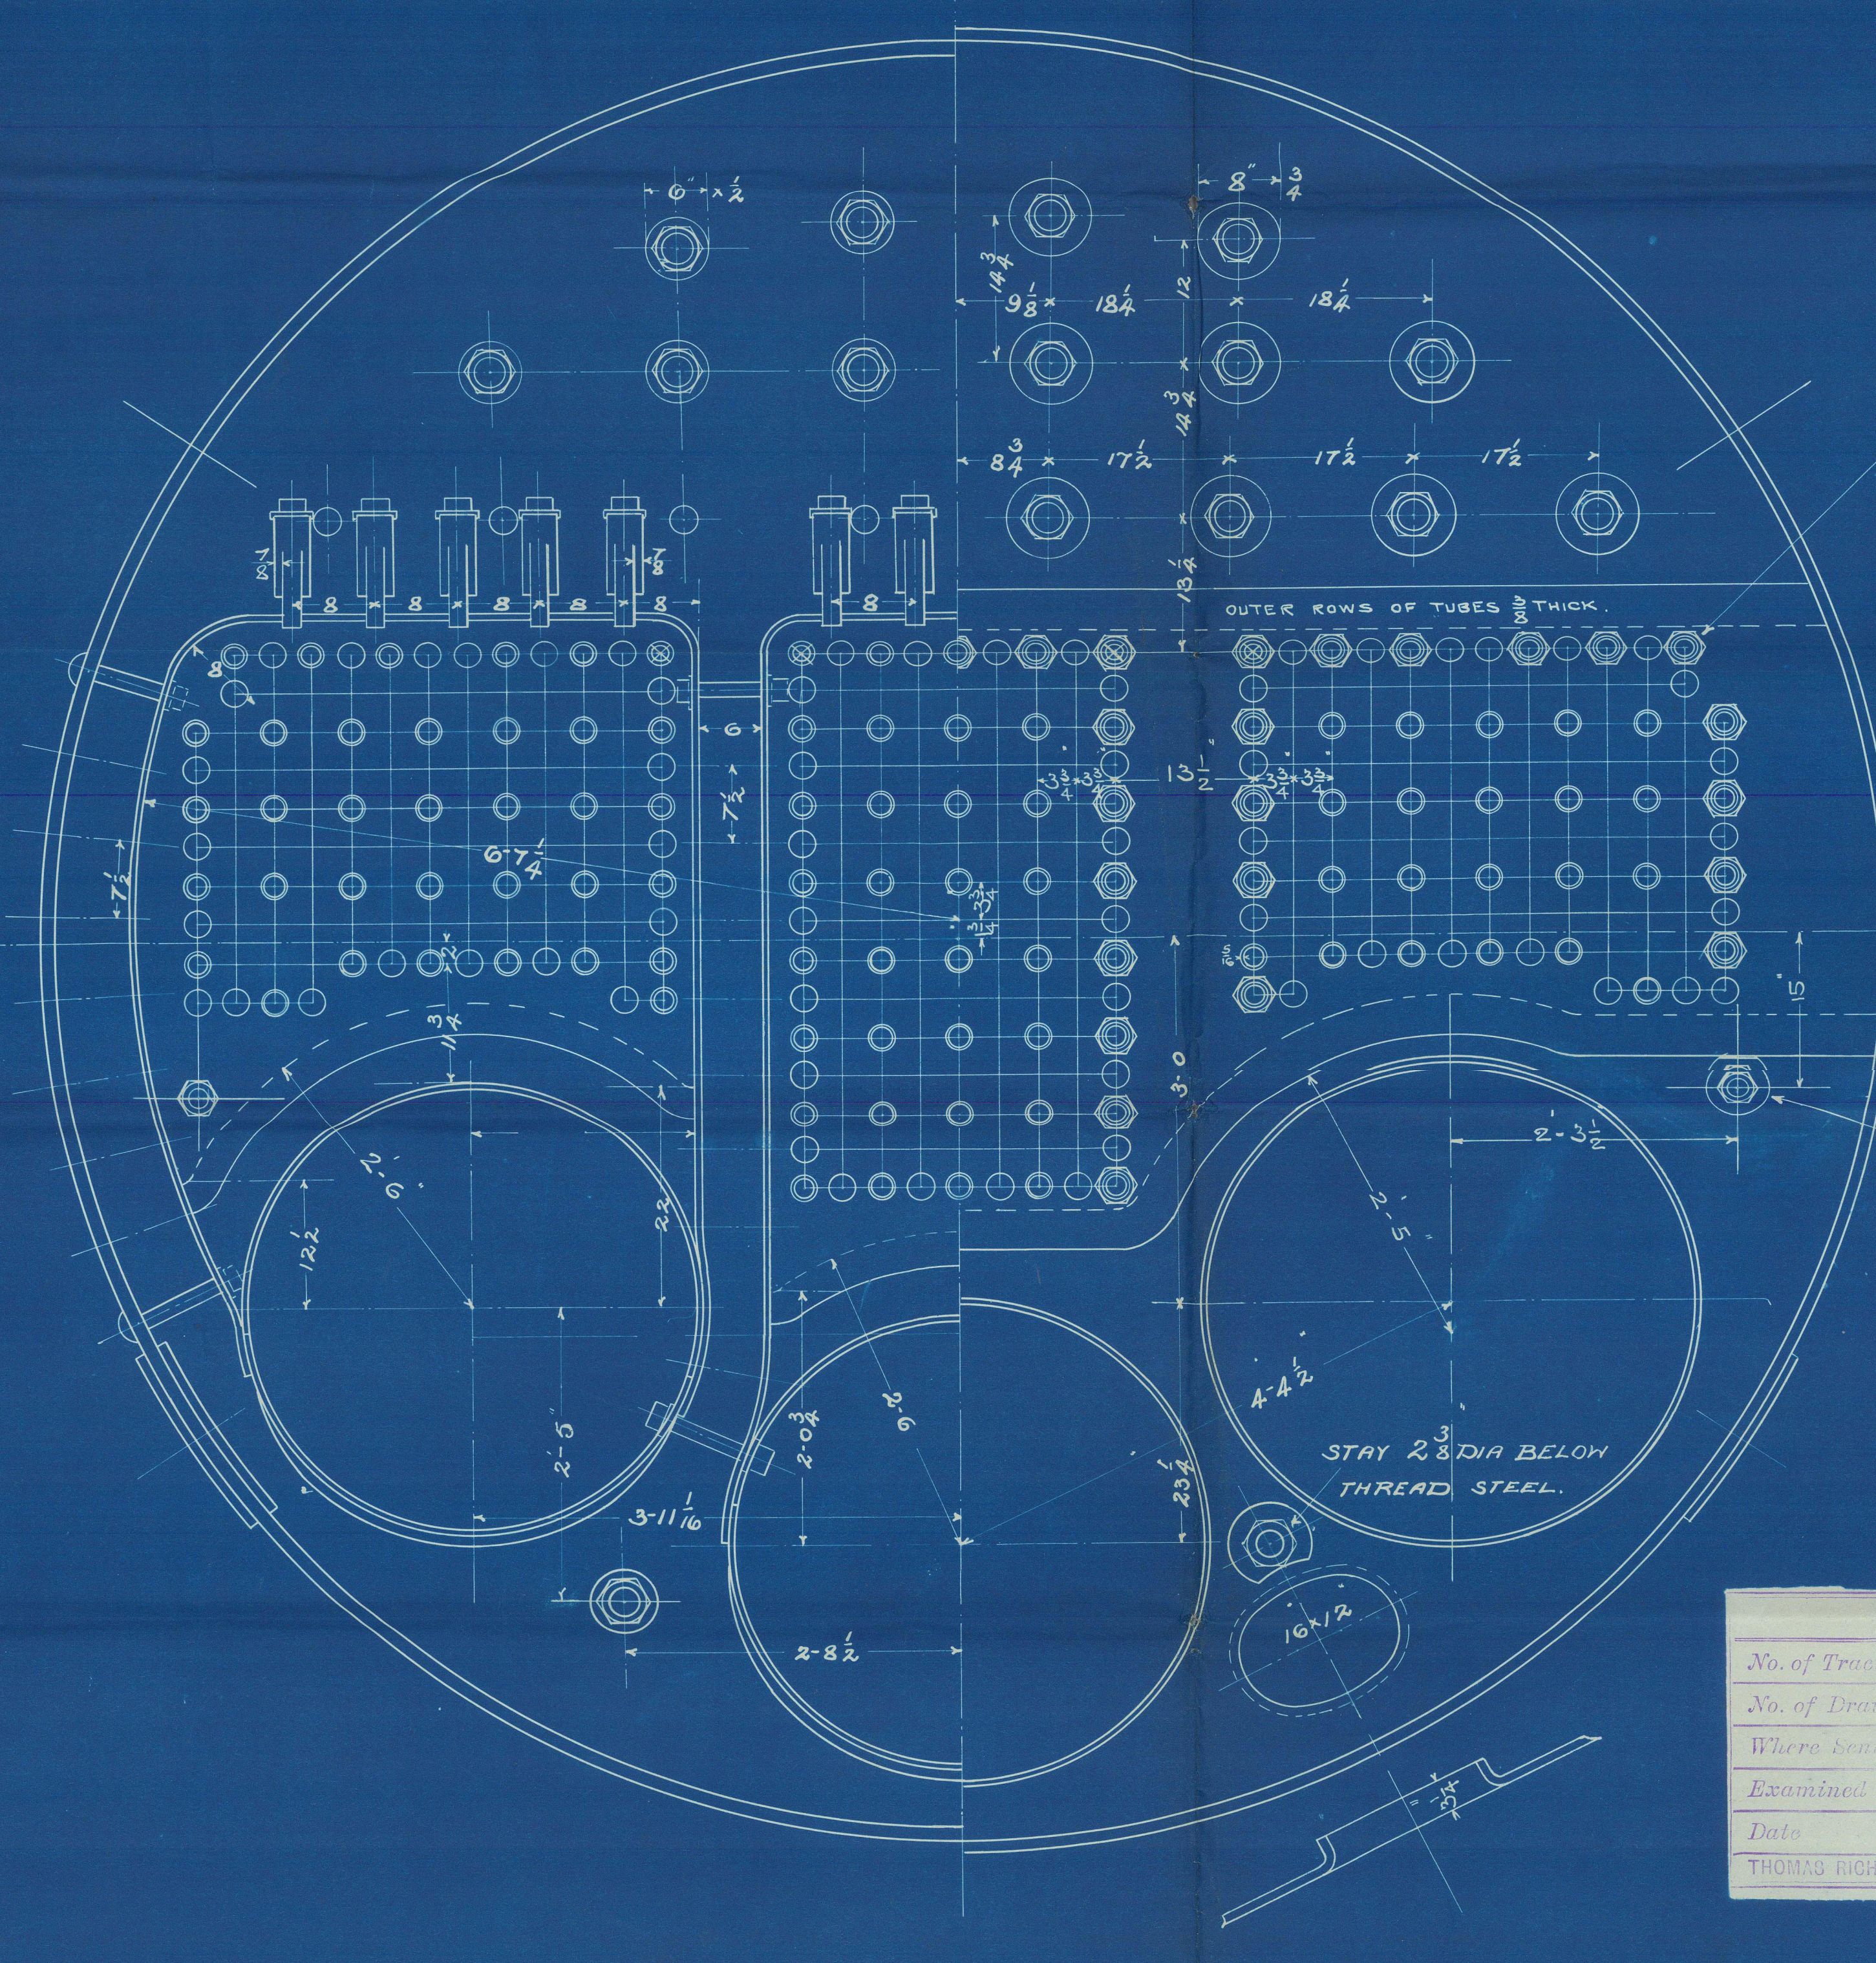


2 BOILERS N° 1091-2.

TO BE FITTED TO MESSRS HOFER MANAIKA & CO S.S. N° 7 & 9.
TO PASS LLOYDS AND REGISTRO ITALIANO FOR A WORKING PRESS OF 180 LBS PER IN.
TO BE TESTED IN THE PRESENCE OF LLOYDS, REGISTRO ITALIANO & OWNERS SURVEYORS
TO BE FITTED WITH MESSRS J HOWNEN'S SYSTEM OF FORCED DRAUGHT.

TENSILE PLATES = 22 TONS PER IN.
SCREW STAYS 10 THREADS PER IN.

SCALE 1 IN = 1 FOOT.

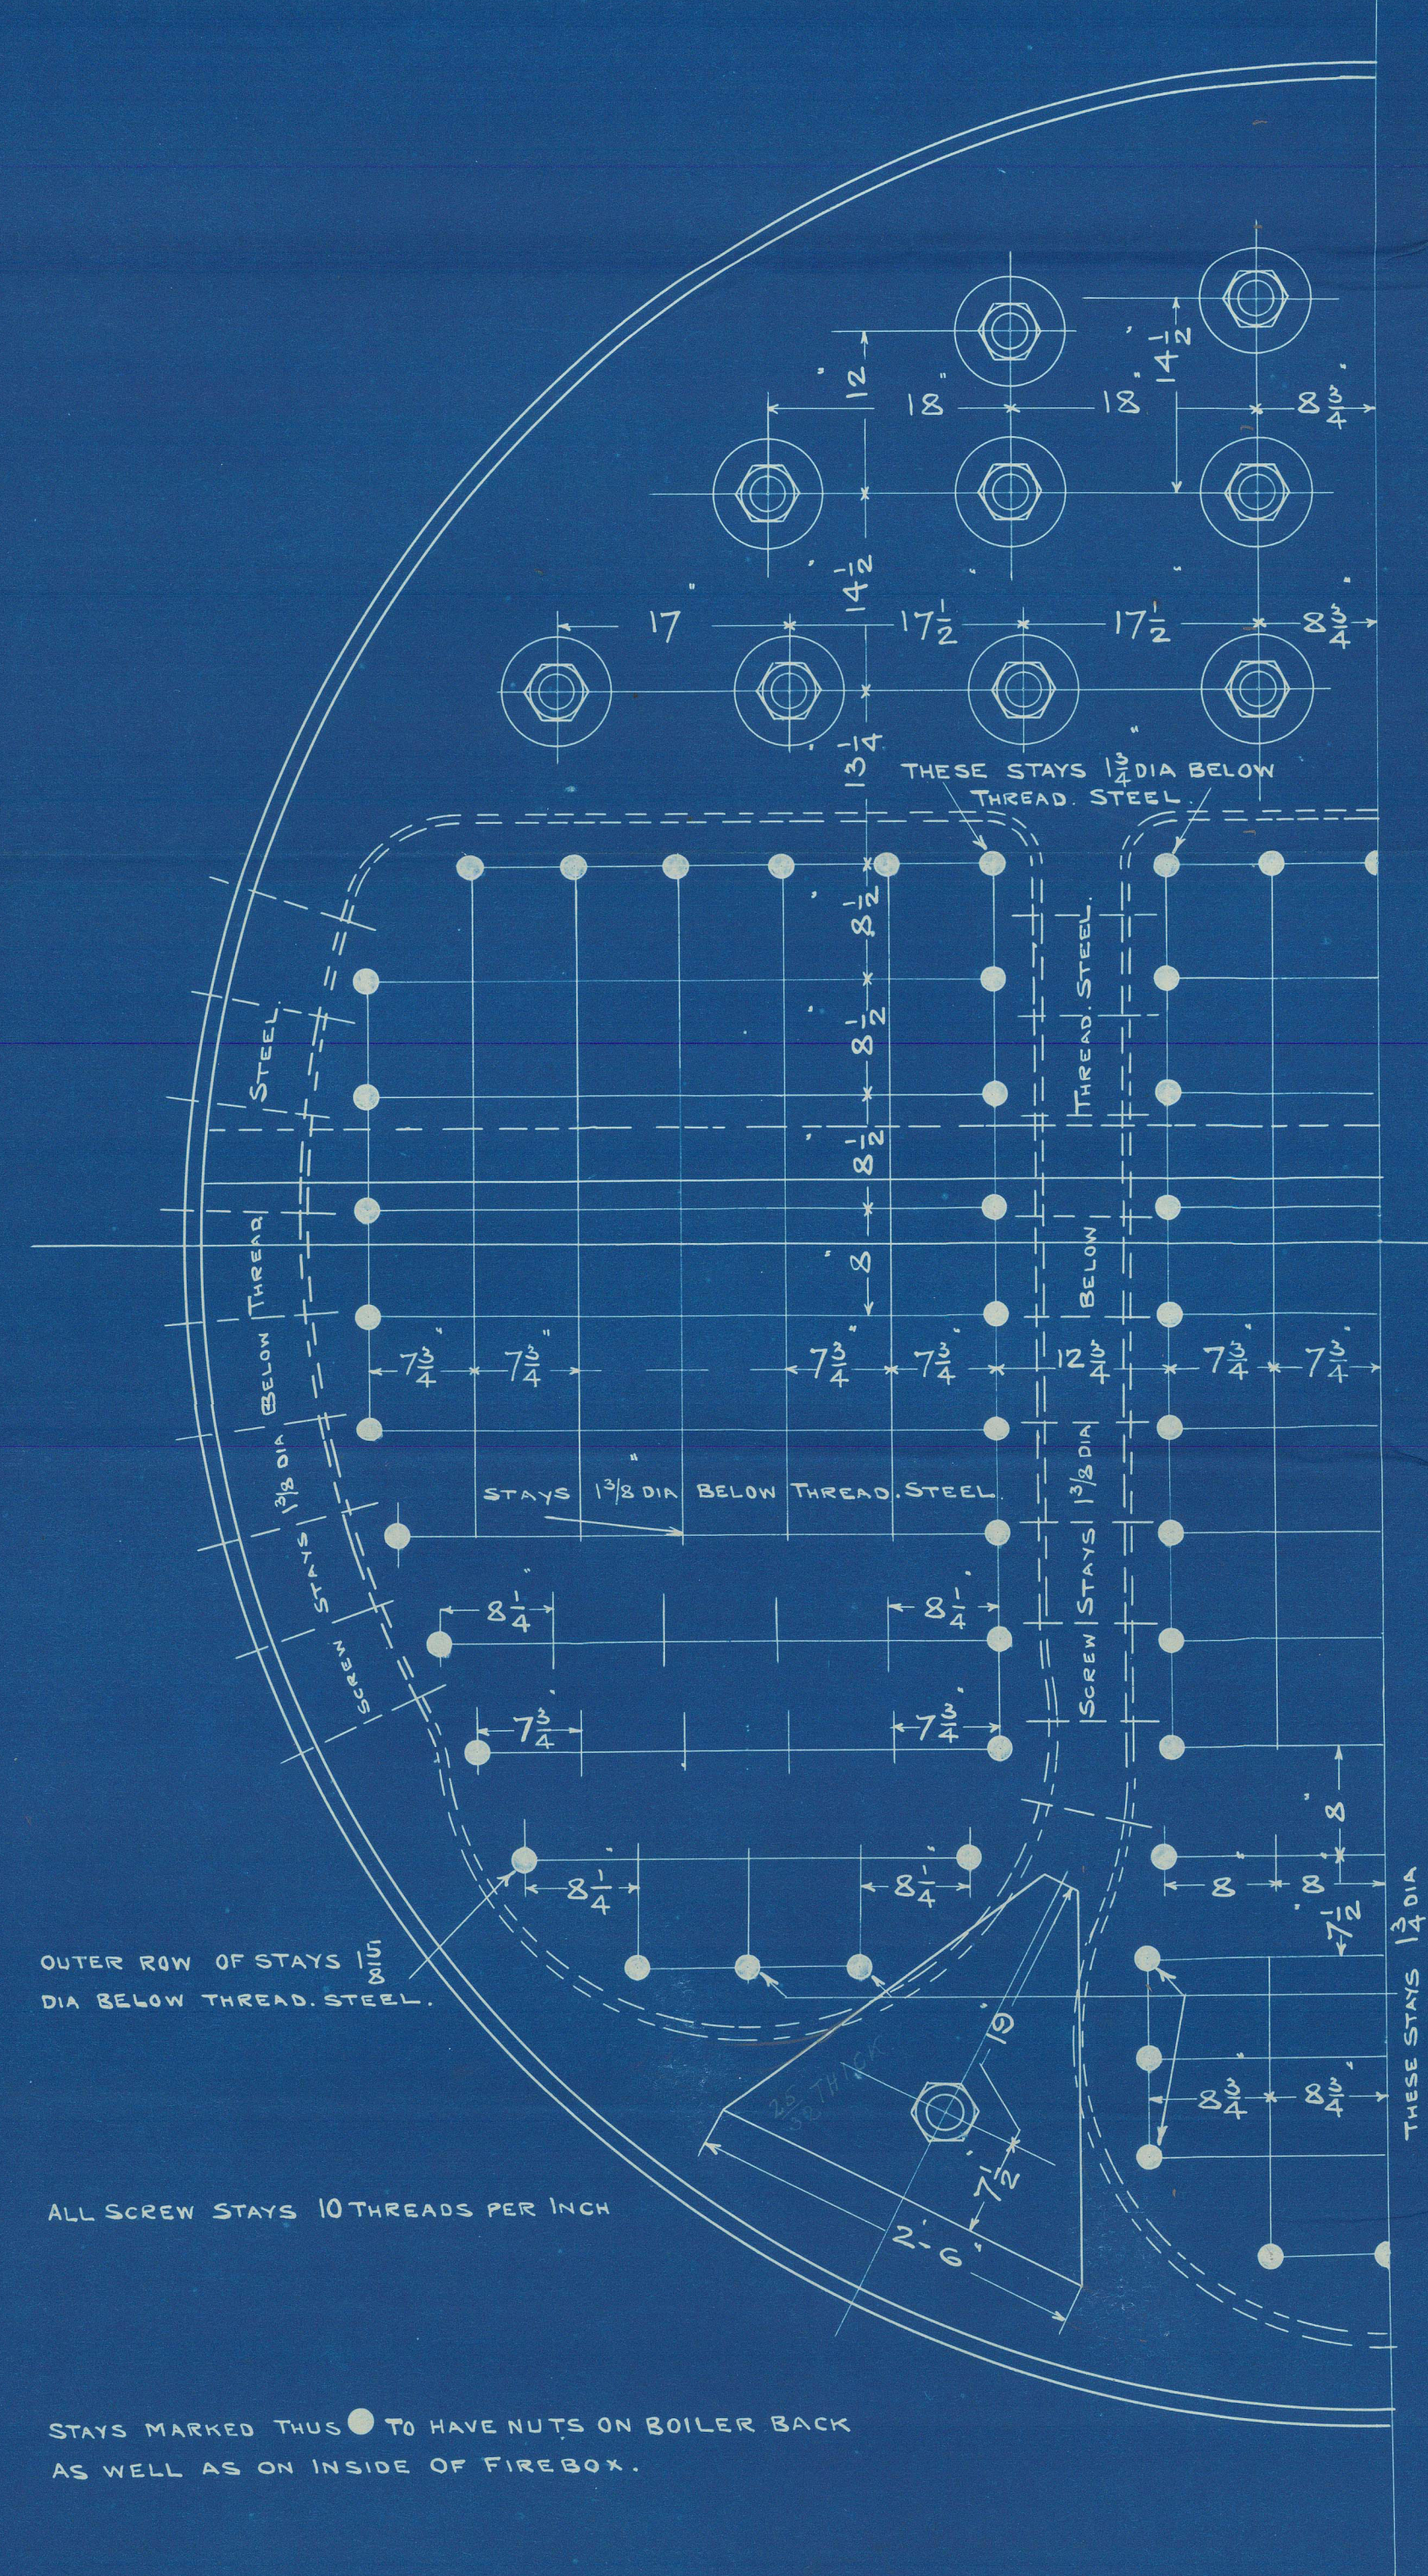

No. of Tracing	9417
No. of Drawing	B1091-2
Where Sent	Lloyds
Examined by	J. H. H.
Date	1914-99
THOMAS RICHARDSON & SONS, Limited	

W1404-0072

Main Boilers

Loper Manaira & Co
uoli Gentire navale di Muggiano
N. ~~up~~ ~~up~~ Vessel

Richardson 1091 & ~~1091~~

180 lbs

"bera"

Hpl Report no. 11229



© 2021
TAIN

loy's Register
Foundation

W4