

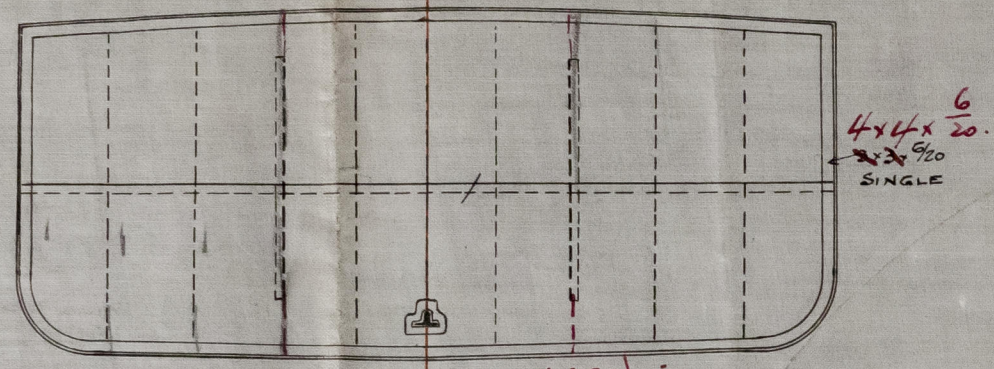
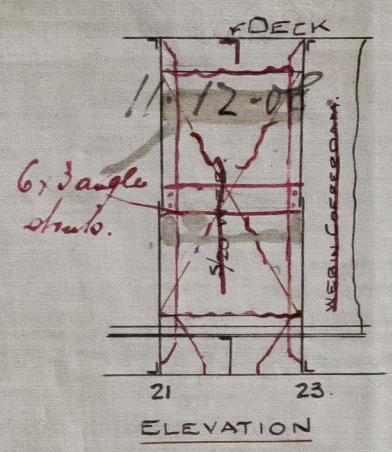
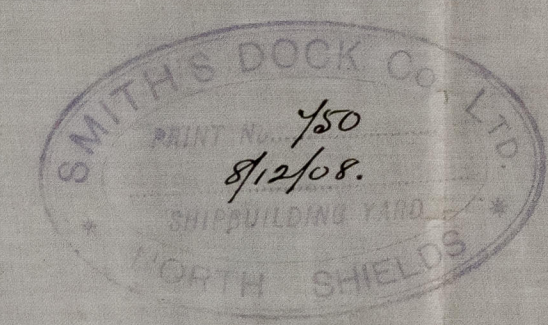
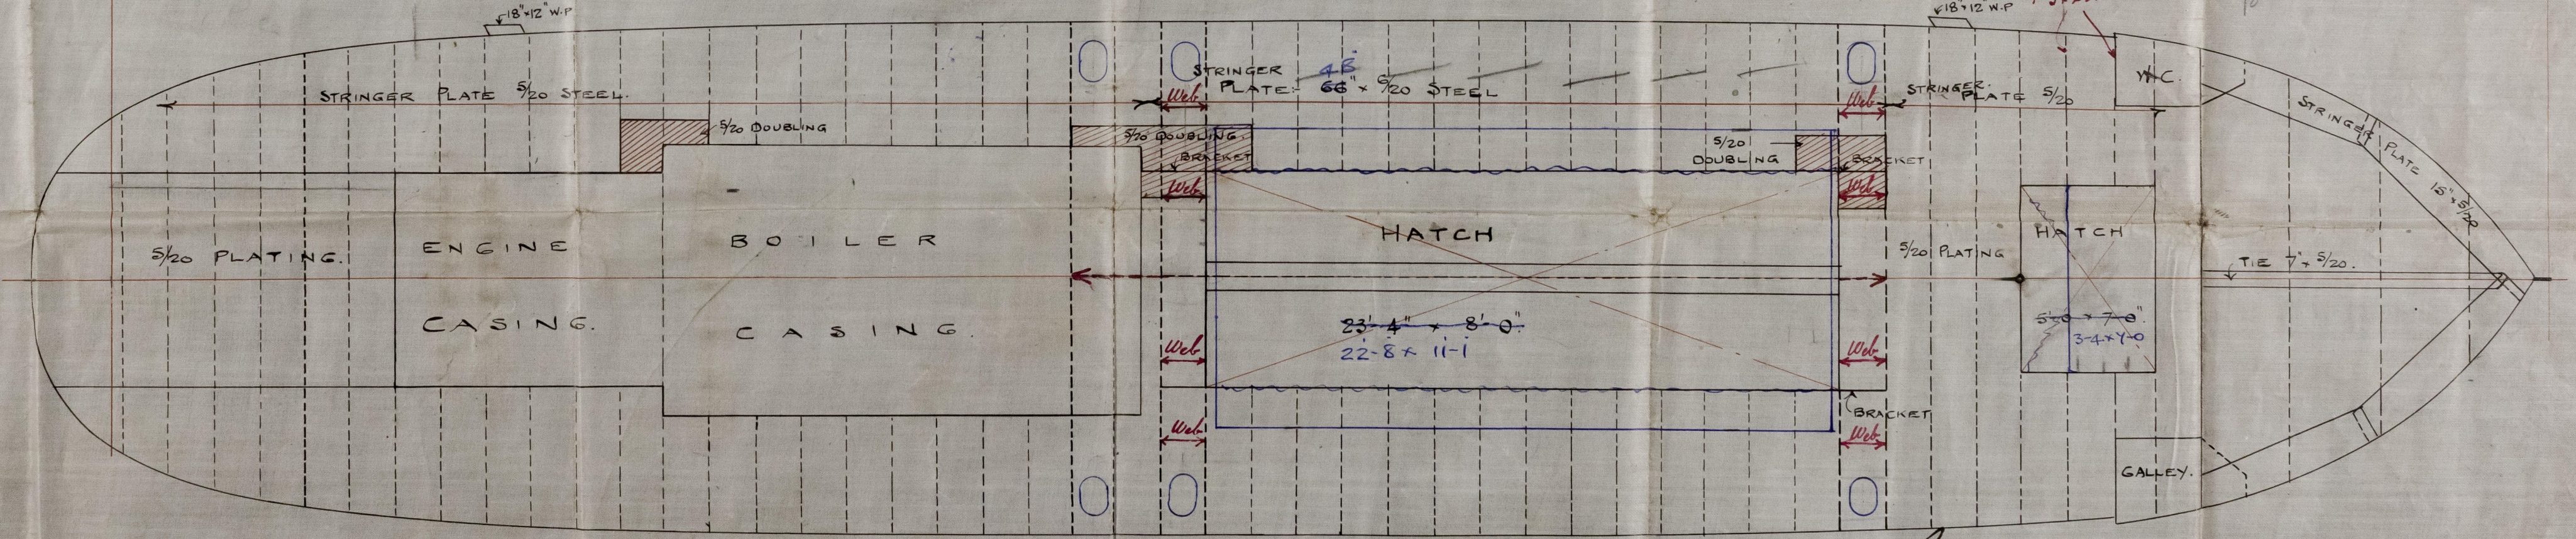


# N<sup>o</sup> 403 - S.S. "Chiara" PROFILE & DECK PLAN. TO CLASS 100A1. LLOYDS SCALE 1/4 INCH.

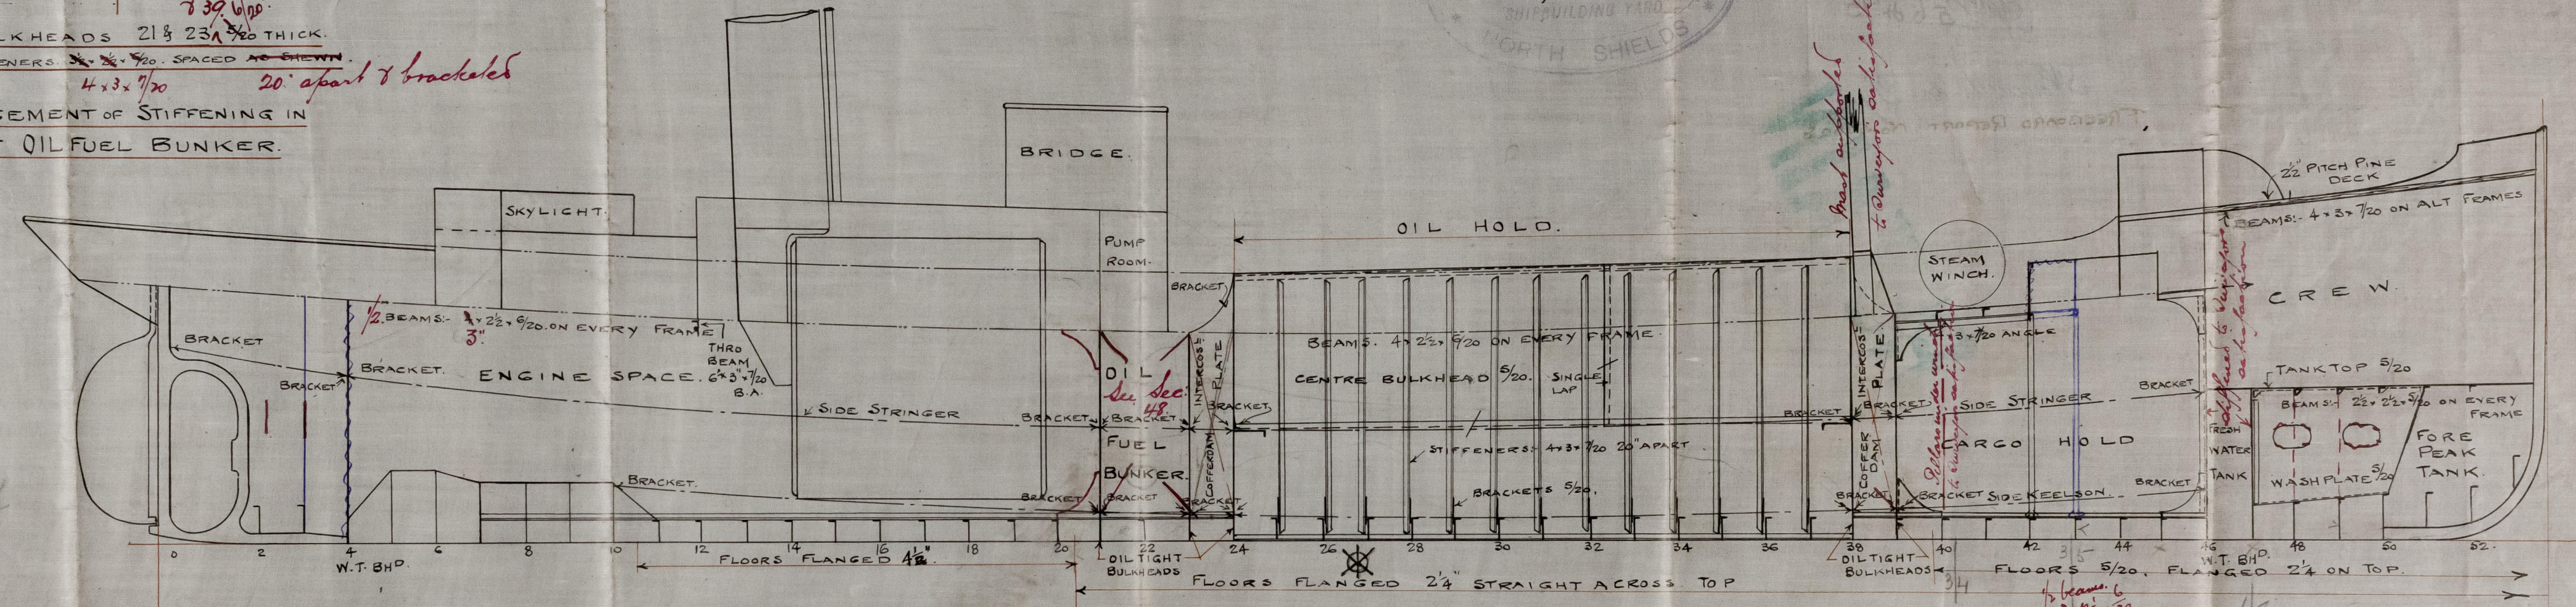

BULKHEADS 21 & 23 5/20 THICK.  
 STIFFENERS 4x3x7/20 20' apart & bracketed  
 ARRANGEMENT OF STIFFENING IN  
 WAY OF OIL FUEL BUNKER.

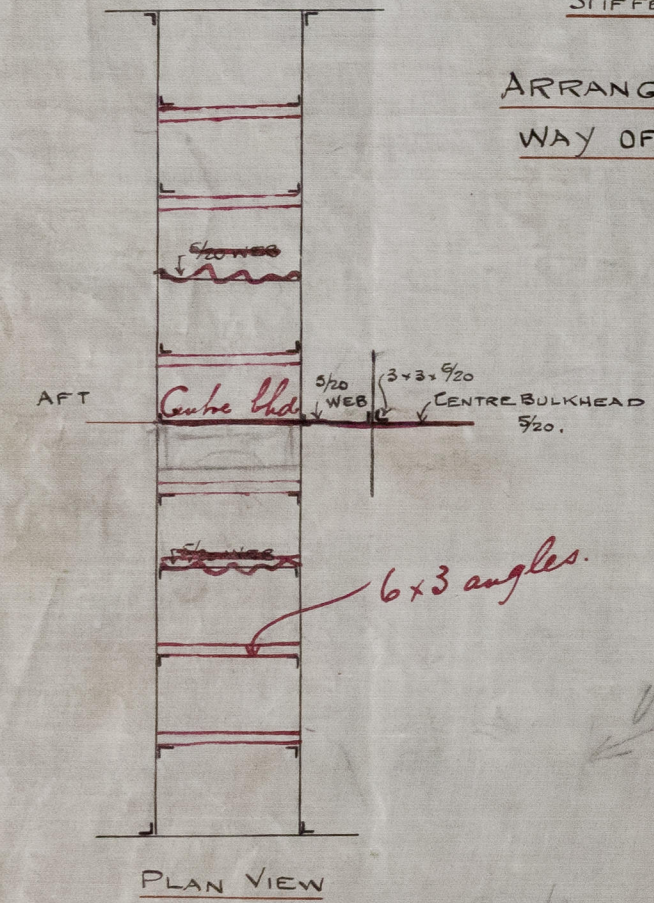

22-6  
 11-5

C.B.  
 11.12.08.



Profile of Decks  
Smith's Dock Co's No. 403  
S.S. "CHIRA"


S.S. "CHIRA"

Newcastle Report

No 56475

Newcastle-on-Tyne

FREEBOARD REPORT No 56328

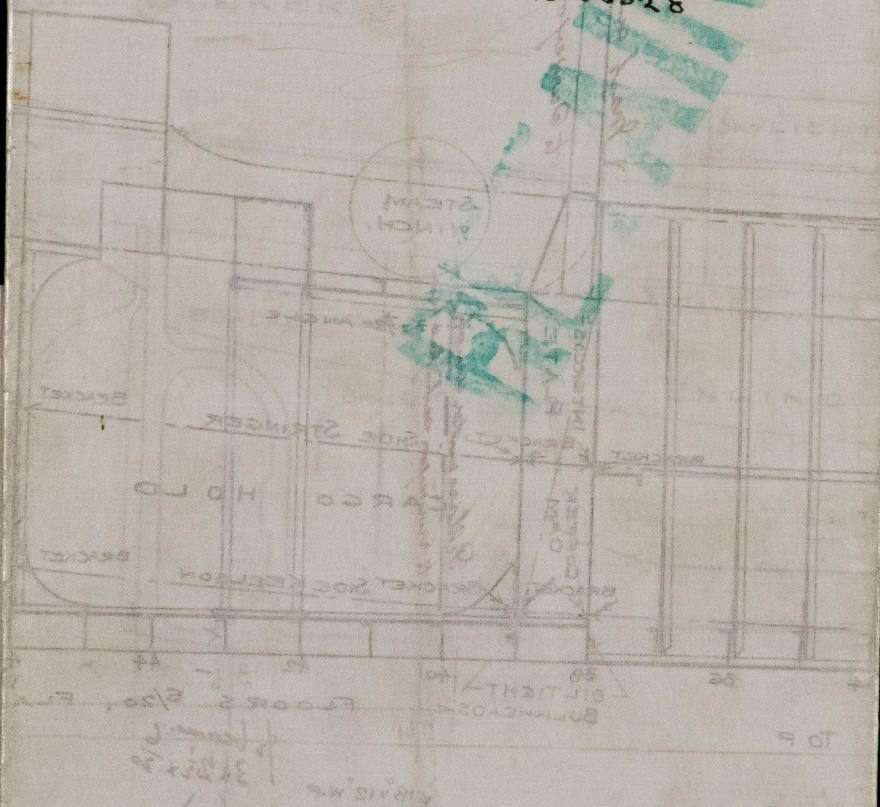

© 2021

Lloyd's Register  
Foundation

W1406-0083