



HEATING ^{IN} GRATE SURFACE		
HEATING SURFACE IN 304 TUBES =	1851	sq. ft.
" " " C CHAMBERS =	281	" "
" " " FURNACES =	145	" "
TOTAL H.S. IN ONE BOILER	2277	" "
" " " 3 " "	6831	" "
GRATE SURFACE IN ONE BOILER 55-59 sq. ft.		
" " " 3 BOILERS	166-78	sq. ft.
RATIO - G.S. H.S. - 1: 42-5		
FIREBARS 5'-0" LONG IN TWO LENGTHS		
2- 34" DIA ^S SAFETY VALVES PER BOILER		



18th JAN^y. 1917.

L

13644

W141-0059

Amended Plan.

At Craig c.c. 594-9


Gravel W.P. 180th 20.1.17

North of Inland. S.S. c.c.

Londonderry


S.S. "Assault"
n.h. S.S. "Amarylis"

Bel 8055.

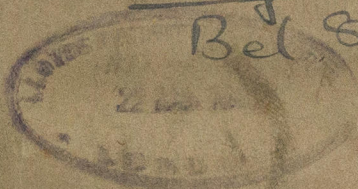

594 No 14211 LLOYDSTEST 360th W.G.M. 8-4-18	595 No 14226 LLOYDSTEST 360th W.G.M. 16-4-18	596 No 14259 LLOYDSTEST 360th W.G.M. 6-5-18
---	--	---

GLASGOW REPORT No. 37749.

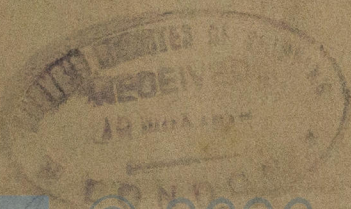

© 2020



Lloyd's Register
Foundation