

N^os 70-1 MIDSHIP SECTION.

DIMENSIONS:- 370'-0" B.P. x 51'-0" MLD x 28'-2" MLD

TO CLASS 100 A.I. LLOYDS.

SCALE 1/2" = 1' FOOT.

NUMERALS

BREADTH MLD	51'-00"
DEPTH	28'-16"
TRANSVERSE N ^o	79-16
LENGTH B.P.	370'-00"
LONGITUDINAL N ^o	29289-20

ERECTOR	
POOP	32.0 x 7.5 x 7.5
BRIDGE	217.5 x 8.0 x 7.5
FORECASTLE	33.0 x 7.5 x 7.5
CASING	8.5 x 7.5 x 5.0
HOUSE	22.5 x 7.5 x 5.0

EQUIPMENT N ^o	31287-95
--------------------------	----------


EQUIPMENT	See amended profile
2 BOWER ANCHORS	564 CTS STOCKLESS
1 " "	47 1/2 " "
1 STREAM " "	15 " " EX STOCK
1 KEDGE " "	63 " " " "
270 FATHOMS 2 1/2" STUD CHAIN CABLE	
30 " "	1 1/2" " " OR 4 1/2" WIRE (STREAM)
120 " "	4 1/2" WIRE (TOWLINE)
30 " "	2 OF 7" MANILLA HANSERS
90 " "	2 " 7" " " WARPS

40 To BRIDGE DECK	10-23
40 " UPPER " "	18-14 1/2
d	16-41

RIVETING

BRIDGE SHEERSTRAKE	QUADRUPLE RIV ^d OVERLAPS
STRAKE BELOW	" "
BRIDGE DECK STRINGER PLATE	TREBLE " "
UPPER DECK SHEERSTRAKE	QUADRUPLE TO TREBLE RIV ^d OVERLAPS
" " " "	" " IN WAY OF BRIDGE
STRAKE BELOW CLEAR OF BRIDGE	QUADRUPLE TO TREBLE " "
" " " "	" " IN WAY OF " "
UPPER DECK STRINGER PLATE	" " TO TREBLE RIV ^d OVERLAPS
UPPER TURN OF BILGE TO STRAKE	" " " "
BELOW SHEER STRAKE	" " " "
KEEL TO UPPER TURN OF BILGE	" " " "
KEEL PLATE	" " " "
CENTRE GIRDER	TREBLE RIVETED OVERLAPS
TANK MARGIN PLATE	" " TO DOUBLE RIV ^d OVERLAPS
TANK TOP CENTRE STRAKE	" " " "
" " PLATING	DOUBLE TO SINGLE " "
UPPER DECK PLATING IN WELLS NEXT HATCHWAYS	DOUBLE RIVETED OVERLAPS
" " " "	" " ELSEWHERE & BRIDGE DECK
SECOND " " " "	" " NEXT HATCHWAYS
" " " "	" " ELSEWHERE POOP & FLE DKS SINGLE
DECK PLATING	SINGLE RIVETED SEAMS
TANK TOP " "	CENTRE STRAKE DOUBLE; ELSEWHERE SINGLE RIV ^d SEAMS

CENTRE GIRDER	42" x 50" FOR 1/4" TO 40" x 60" N.B.S.
TOP BARS	3 1/2" x 3 1/2" x 50" " " " " 48" x 60" " "
BOTTOM BARS	4 1/2" x 4 1/2" x 40" " " " " 56" " "
VERTICAL " "	5" x 5" x 55" " " " " 3 1/2" x 3 1/2" x 40" x 56" N.B.S.
To SOLID FLOORS	Single 3 1/2" x 3 1/2" x 40" To SKELETON FLOORS

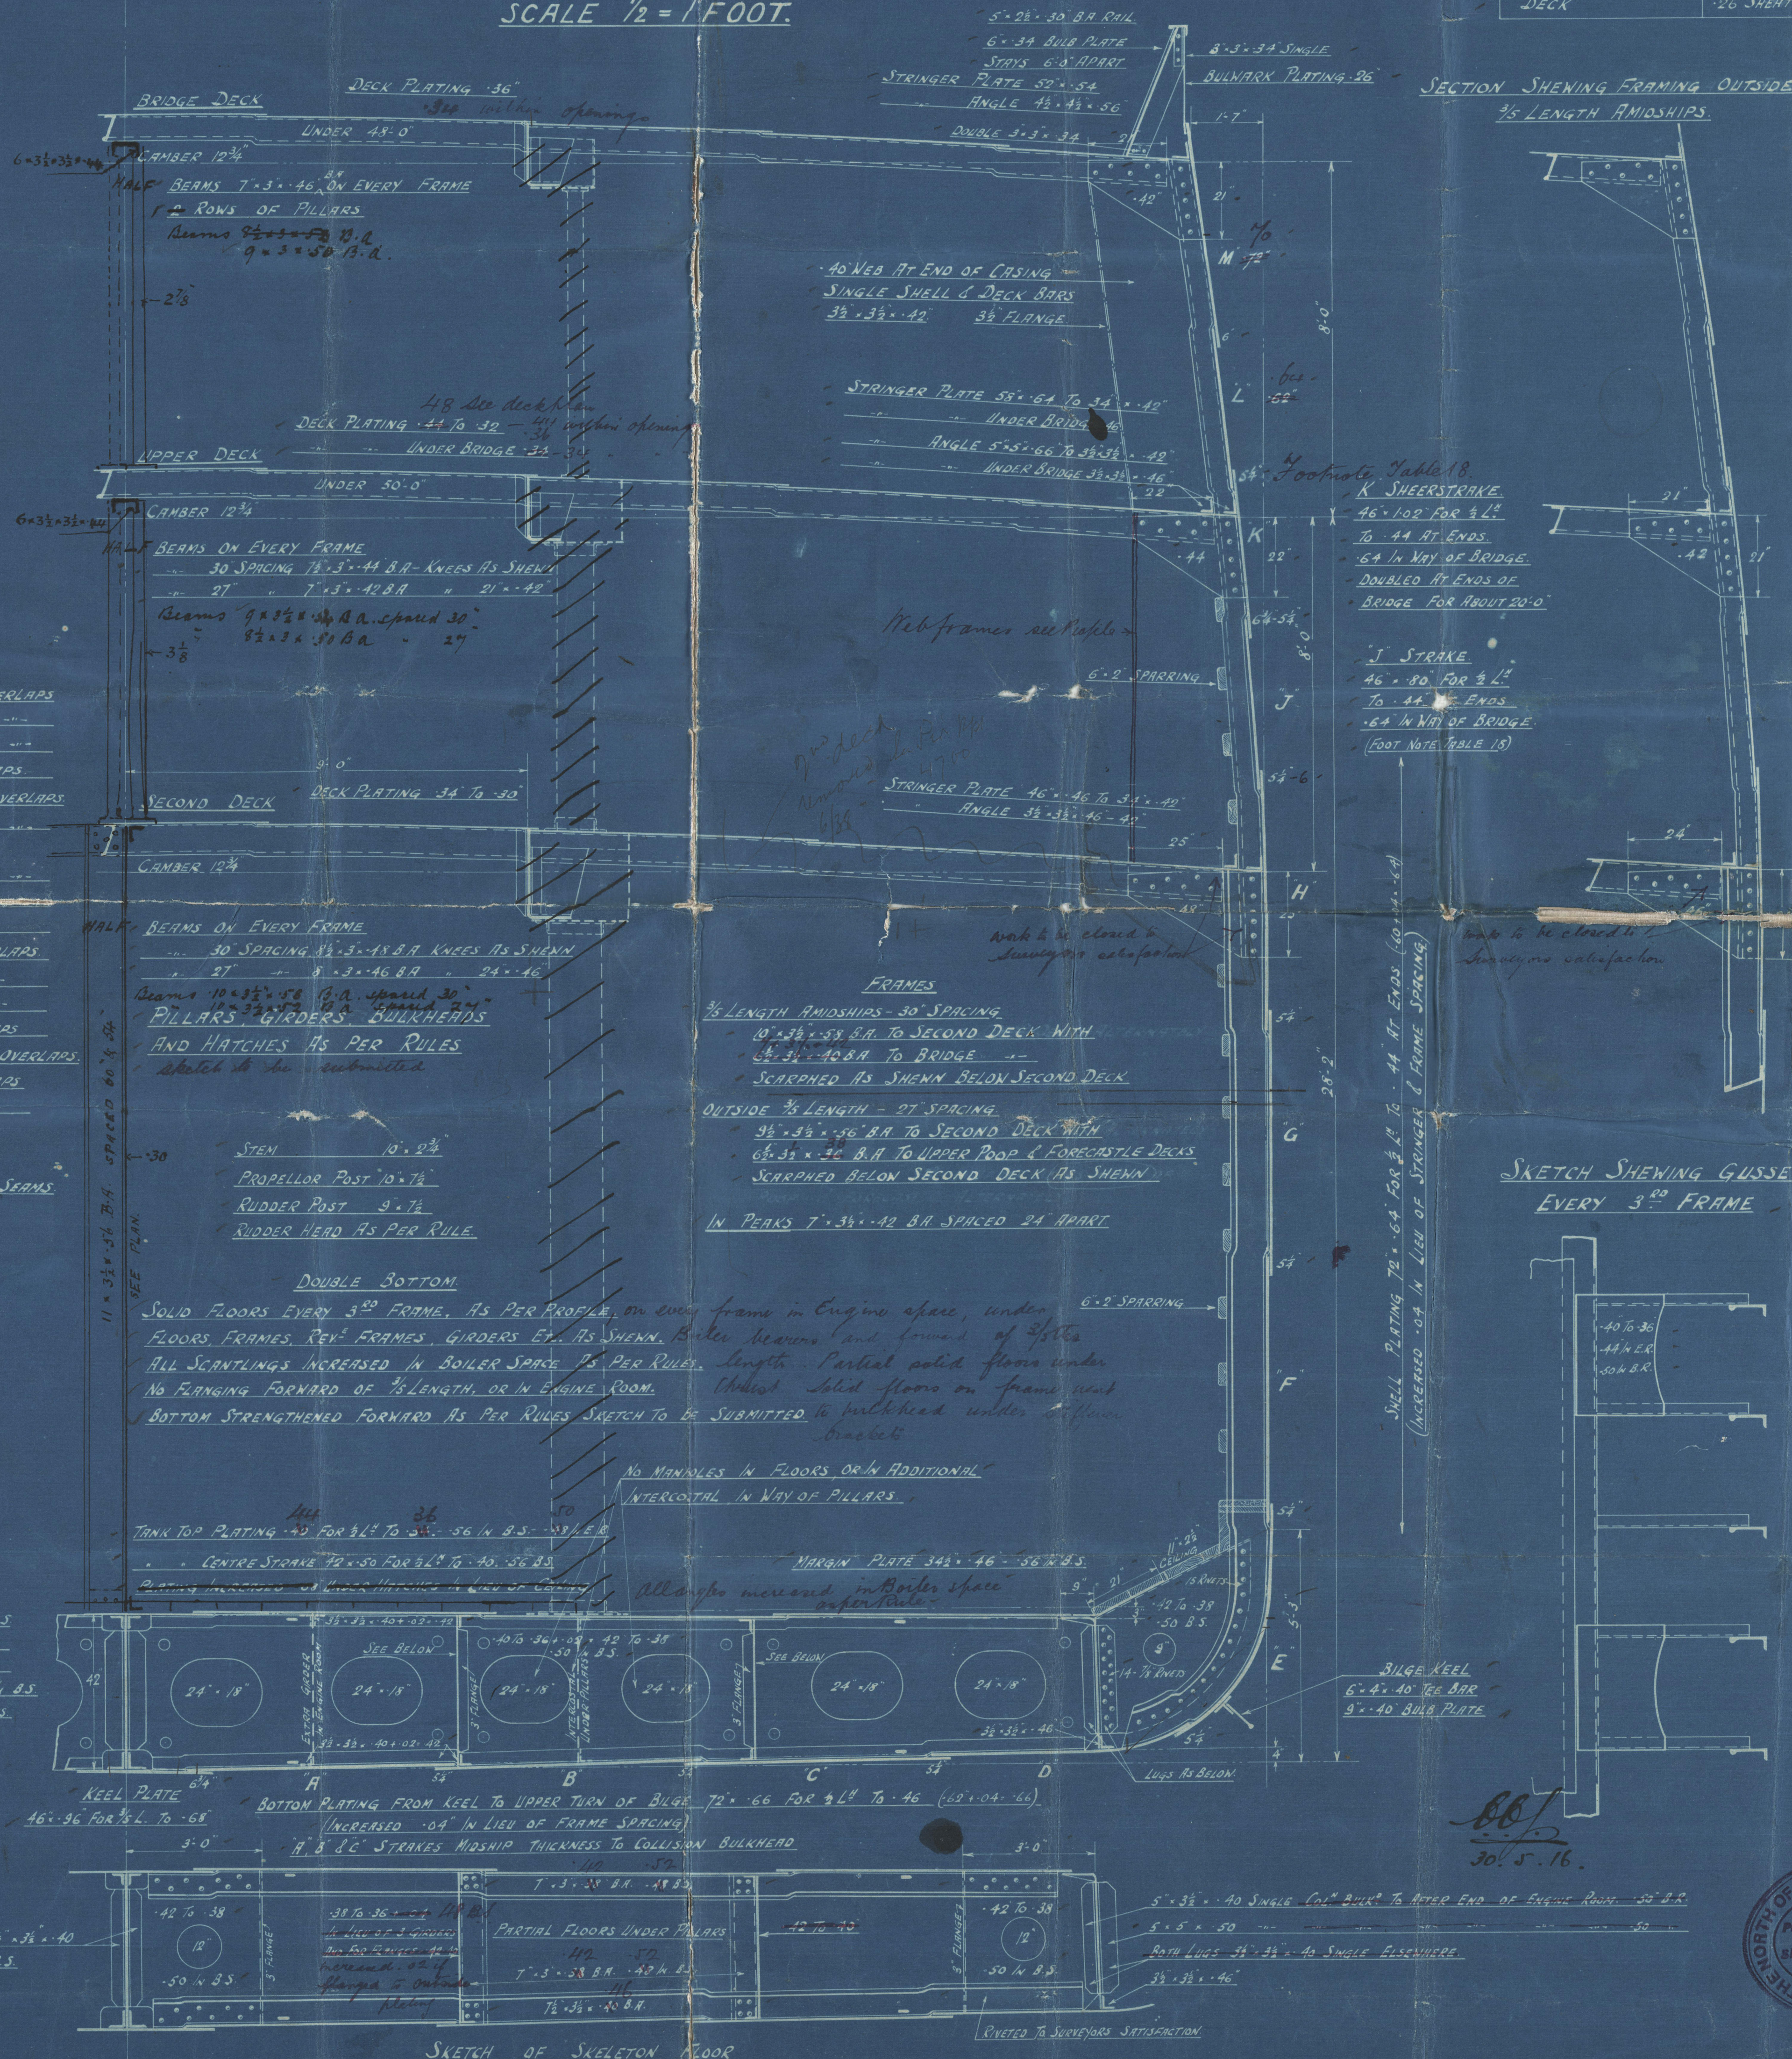


ITEM	POOP	FORECASTLE
SIDE PLATING	38	40
BEAMS	8" x 3" x 40" B.A. ON ALTERNATE FRAMES 2 ROWS OF PILLARS	7" x 3" x 40" B.A. ON EVERY FRAME 2 ROWS OF PILLARS
BEAM KNEES	22" x 44"	20" x 40"
STRINGER PLATE	34" x 34"	34" x 34"
STRINGER ANGLE	3 1/2" x 3 1/2" x 34"	3 1/2" x 3 1/2" x 34"
DECK	26 SHEATHED	34

SECTION SHEWING FRAMING OUTSIDE 1/5 LENGTH AMIDSHIPS.

SKETCH SHEWING GUSSET EVERY 3rd FRAME



W141-0060

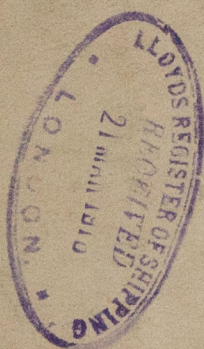

© 2020

Lloyd's Register
Foundation

The North of Ireland

SP. 60

N^o 70 and 71.

Midship Section.

* "Assault" - N^o 70.

W. H. Amarnyke Rel. 8055.

Amarna. 71.

Rel. 8100.

W. H. Amarnyke

Marsulin

£660.

Amarnyke



© 2020

Lloyd's Register
Foundation