


Plan showing coverings of hatchways with  
arrangement of hatch end beams to be submitted &  
pillars in form deck at center line

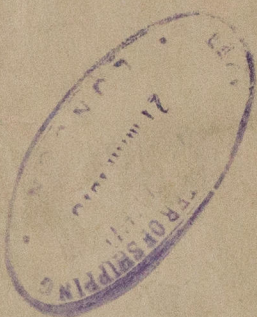

## AMENDED PROFILE AND DECK PLANS










© 2020

Lloyd's Register  
Foundation



W.S. 1148<sup>a</sup>


The North of Ireland S.B. Co.

No 70 ~~77~~ & 71

Amended Profile & Deck Plans

\* Account - No 70.

n.n. Amarylis Bel. 8055.

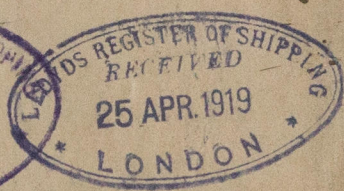

Amarna. 71. Bel. 8100.



Maroulis



W141-0061



© 2020

Lloyd's Register  
Foundation