

9. 11. 05  
17. 9. 06

S.S. N<sup>o</sup> 457-8.




PROFILE & DECK PLANS.

DIMS. 310'-0" x 40'-0" x 26'-6".

SCALE 1/8" = 1 FT.




*angle on lower cap of coamings  
in line of intercalated joint, see deck plan.*

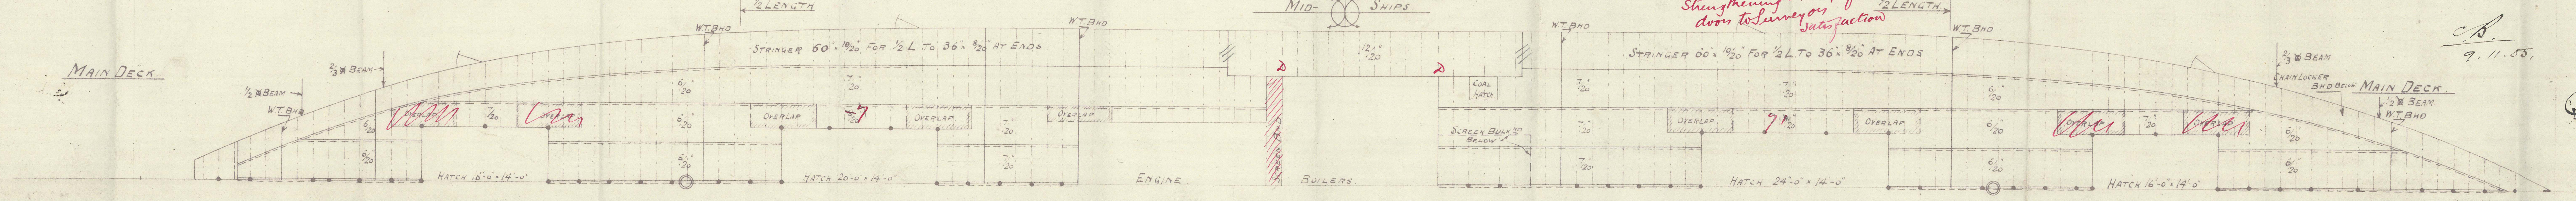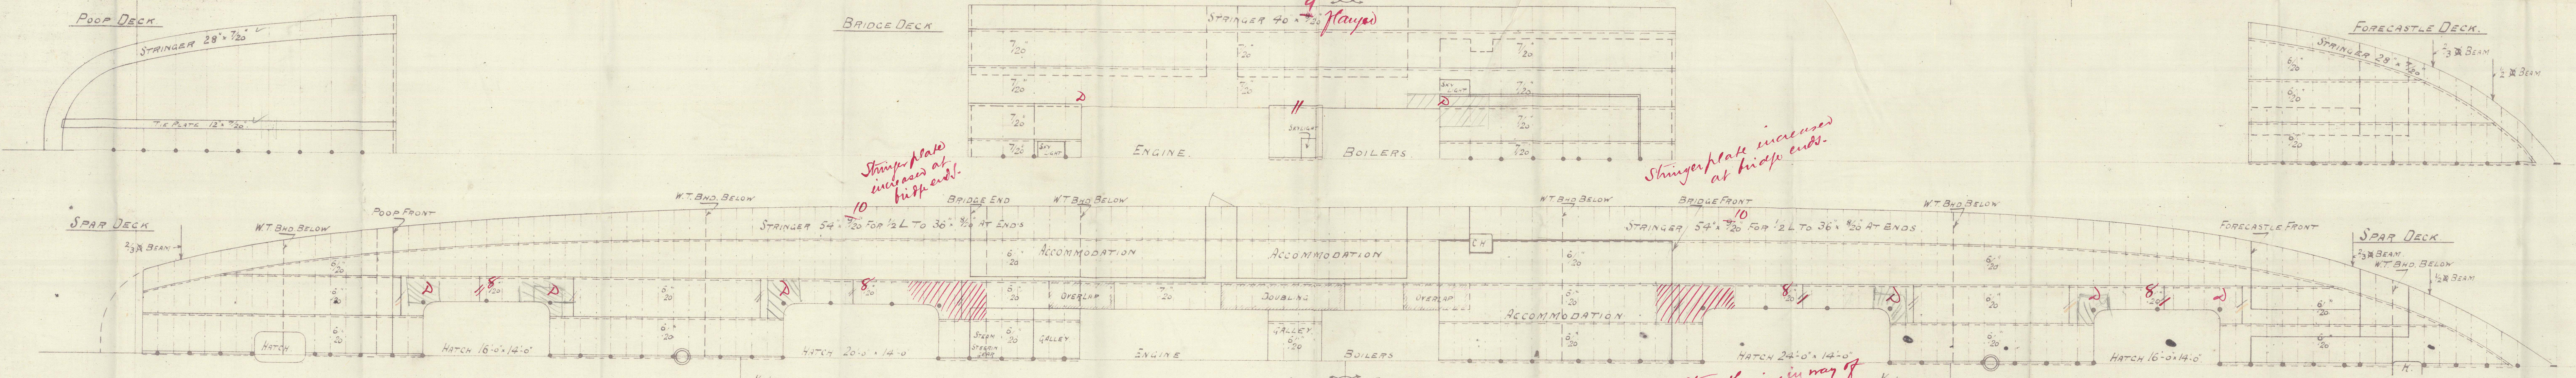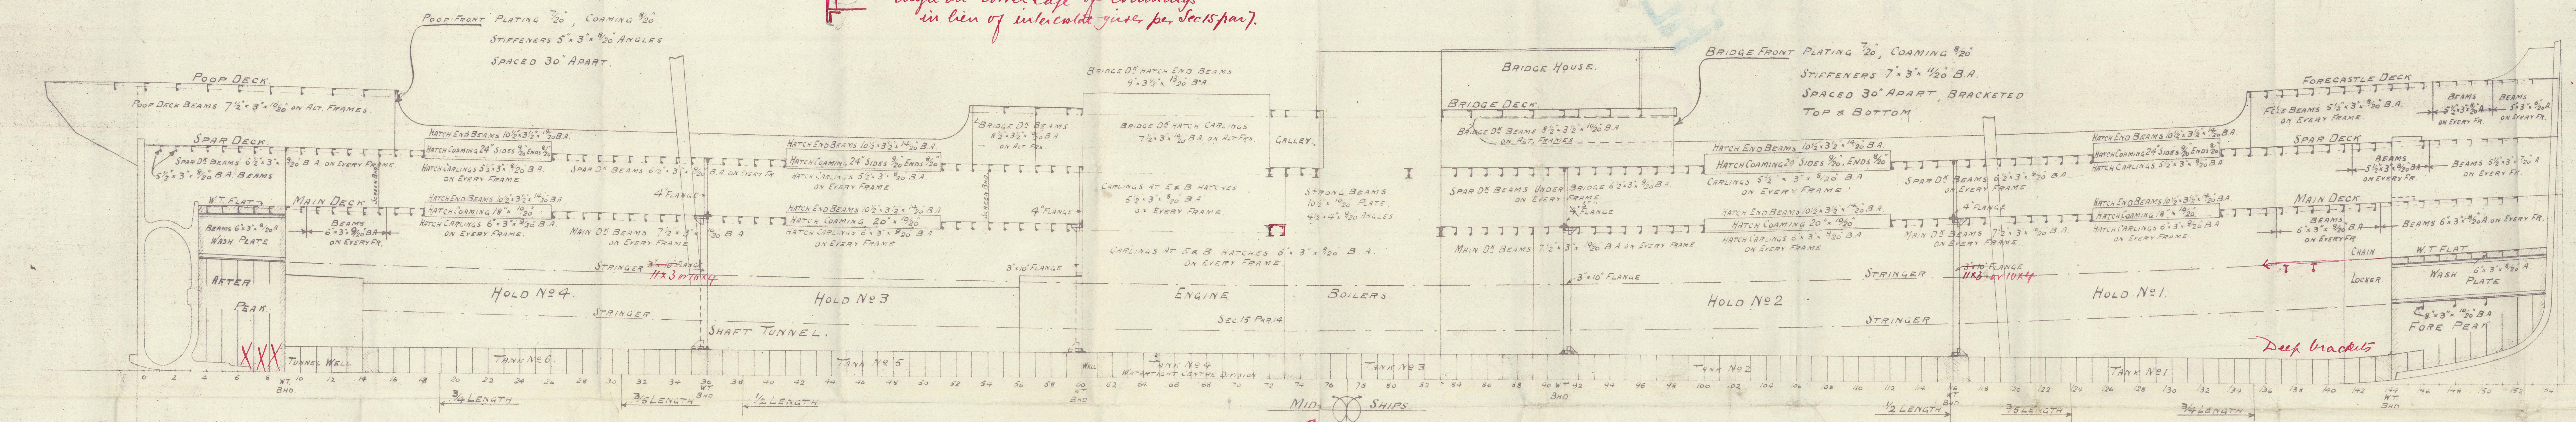



Profile & Decks  
Hendersons 457-8

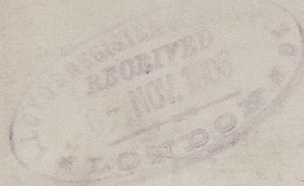

"Chikuzen Maru"  
Gls. Rpt. No. 25144

sp. "Chikugo Maru"  
Gls. Rpt. No. 25403.



D.B.T.



© 2021

Lloyd's Register  
Foundation

W1411 - 0055