

30-1-07
 12-2-07



— PROFILE AND DECK PLAN. —

STEEL SCREW DRIFTERS

N^{OS} 405-6-7-8-9. — 410. 411. 412.

DIMENSIONS. 84'0" x 18'3" x 9'3" MLD.

SCALE 1/4" = 1 FOOT.

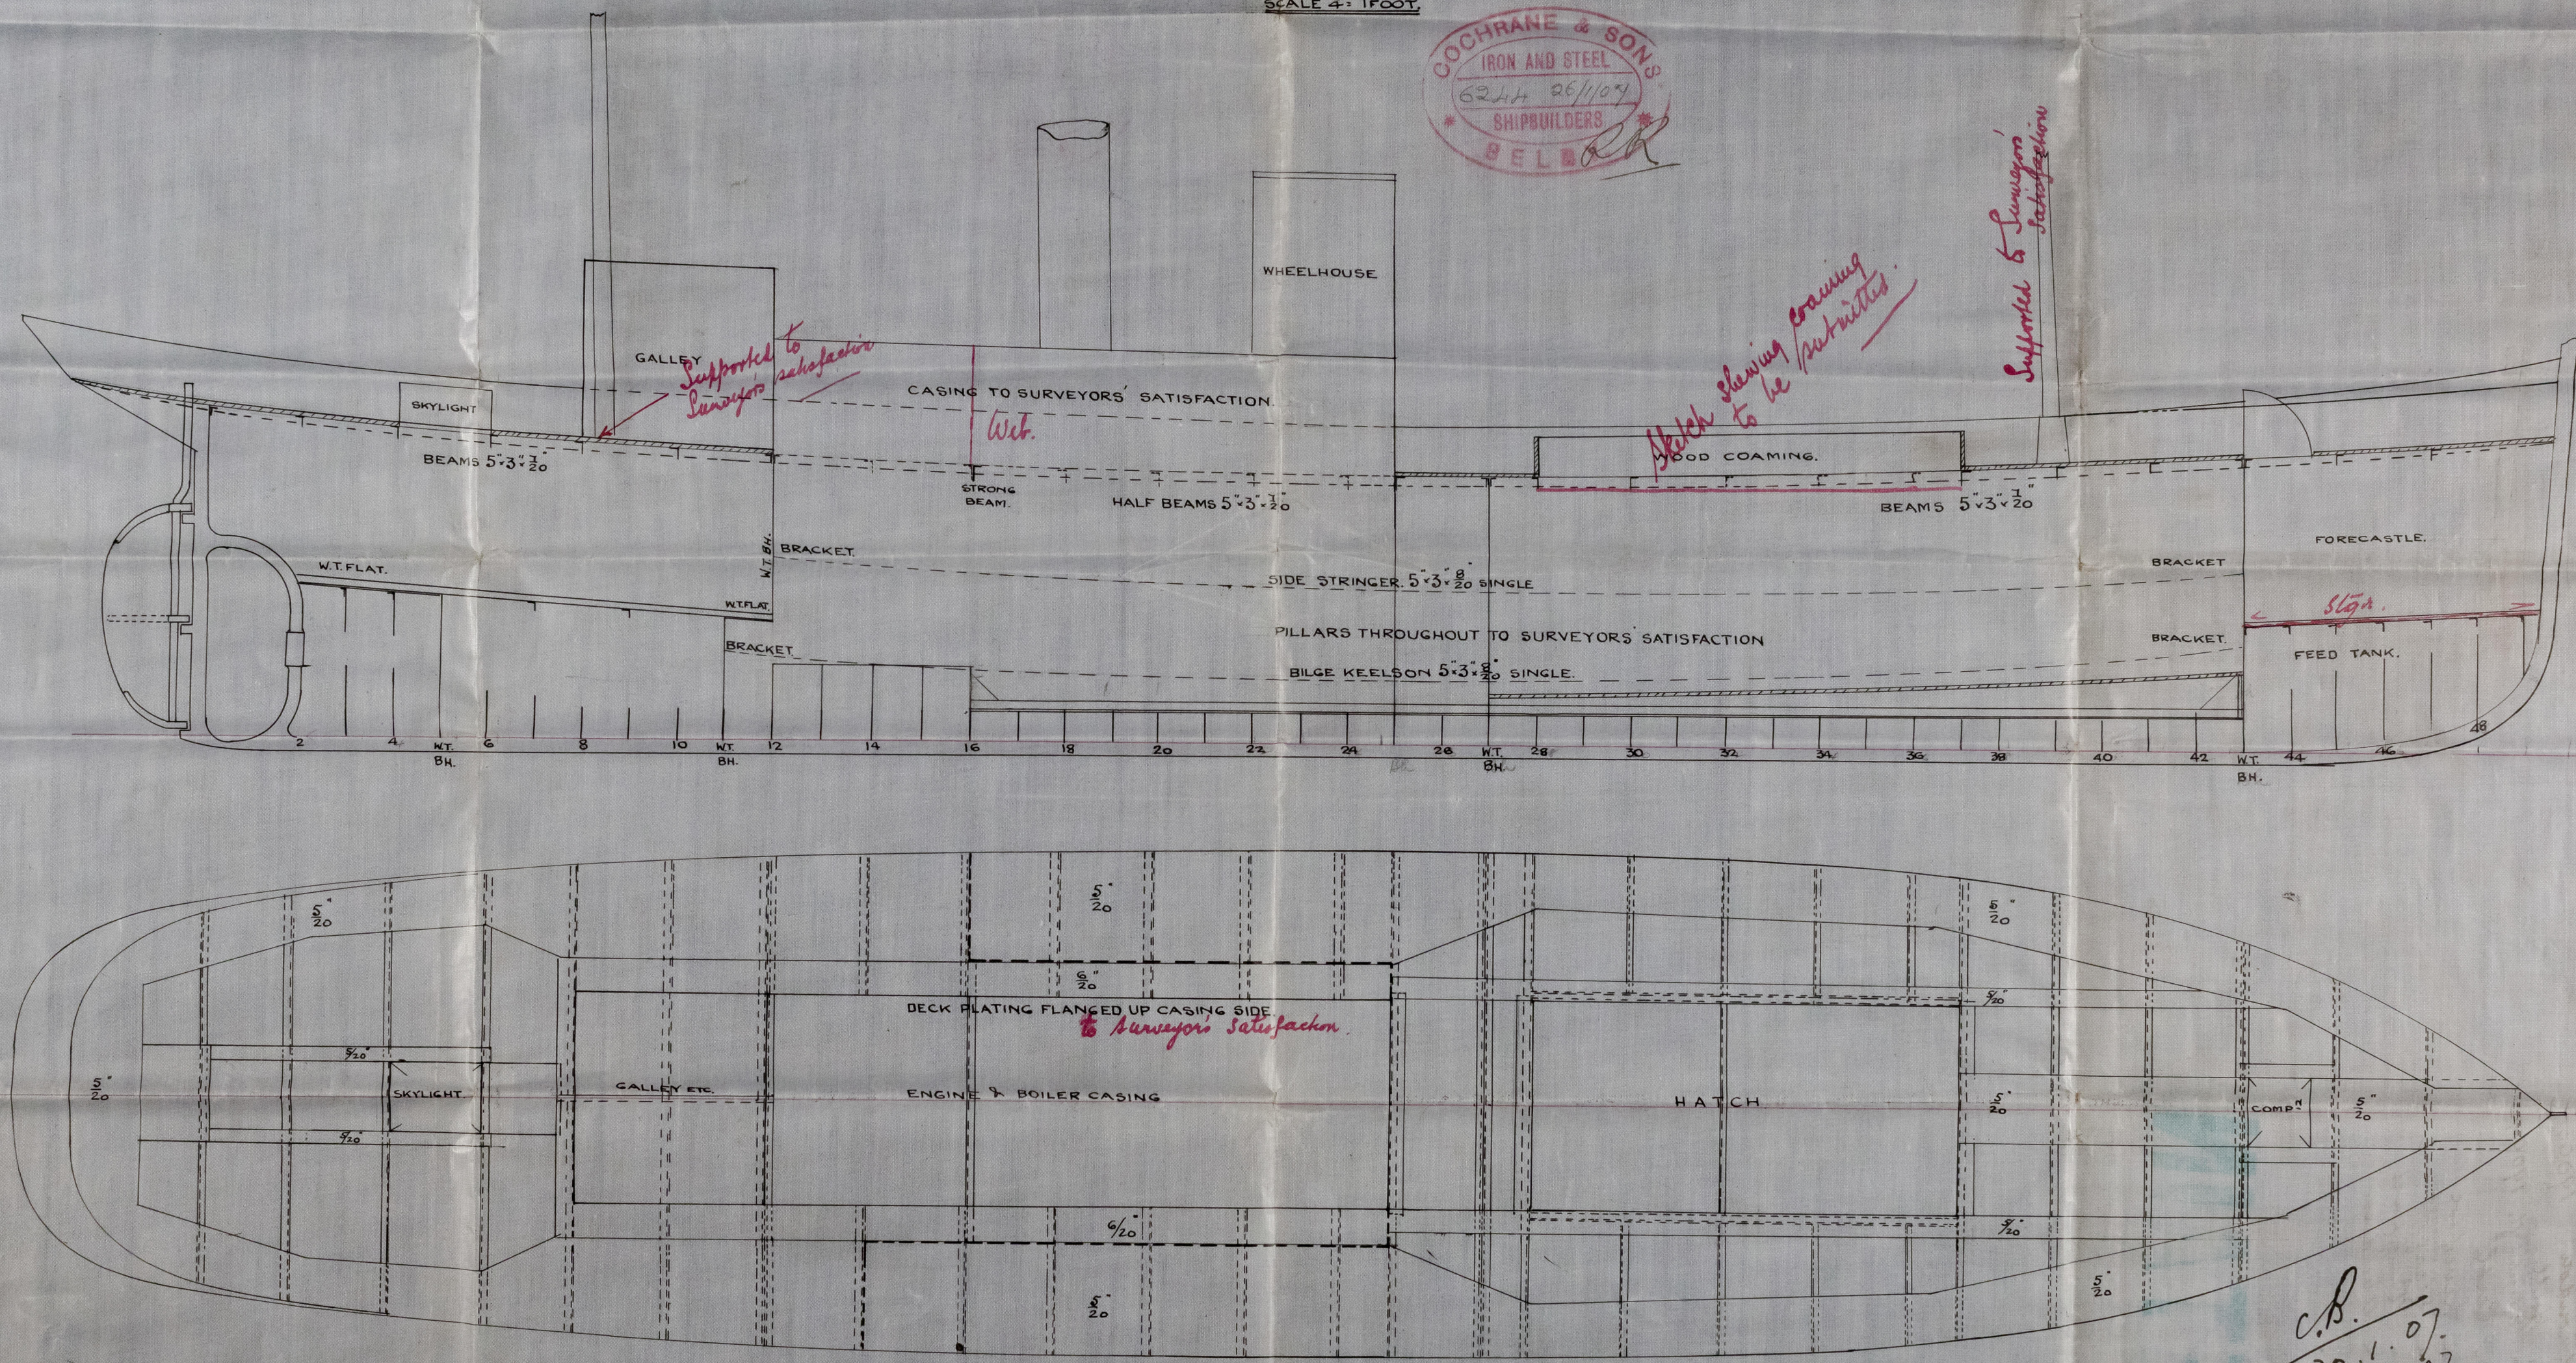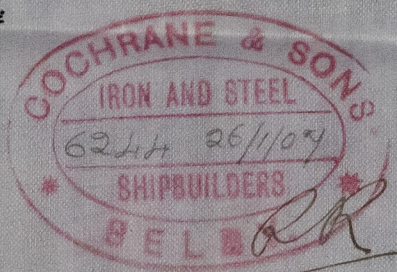

C.B.
 30-1-07
 12-2-07

asus
 29-1-07
 ©2021

- Profile -

Cochrane & Sons
Selby

No. 405, 6. 7. 8 + 9.

No. 410, 411 and 412.

	<u>Rpt no</u>
S.S. City of London	19003
" " " Hull	
" " " Edinburgh	19004
" " " Perth	
" " " Liverpool	
" " " Glasgow	
" " " Belfast	
" " " Aberdeen	

D.S. 23

© 2021

Lloyd's Register
Foundation

W1412-0037