

Nos 405-6-7-8 & 9 * 410-411-412

STEEL SCREW DRIFTERS



MIDSHIP SECTION

DIMENSIONS 84'-0" x 18'-3" x 5'-3" M

SCALE 1" = 1 FOOT

TO CLASS 100A1 FOR FISHING PURPOSES

DECK PLATED OVER IN WAY OF MACHINERY SPACE

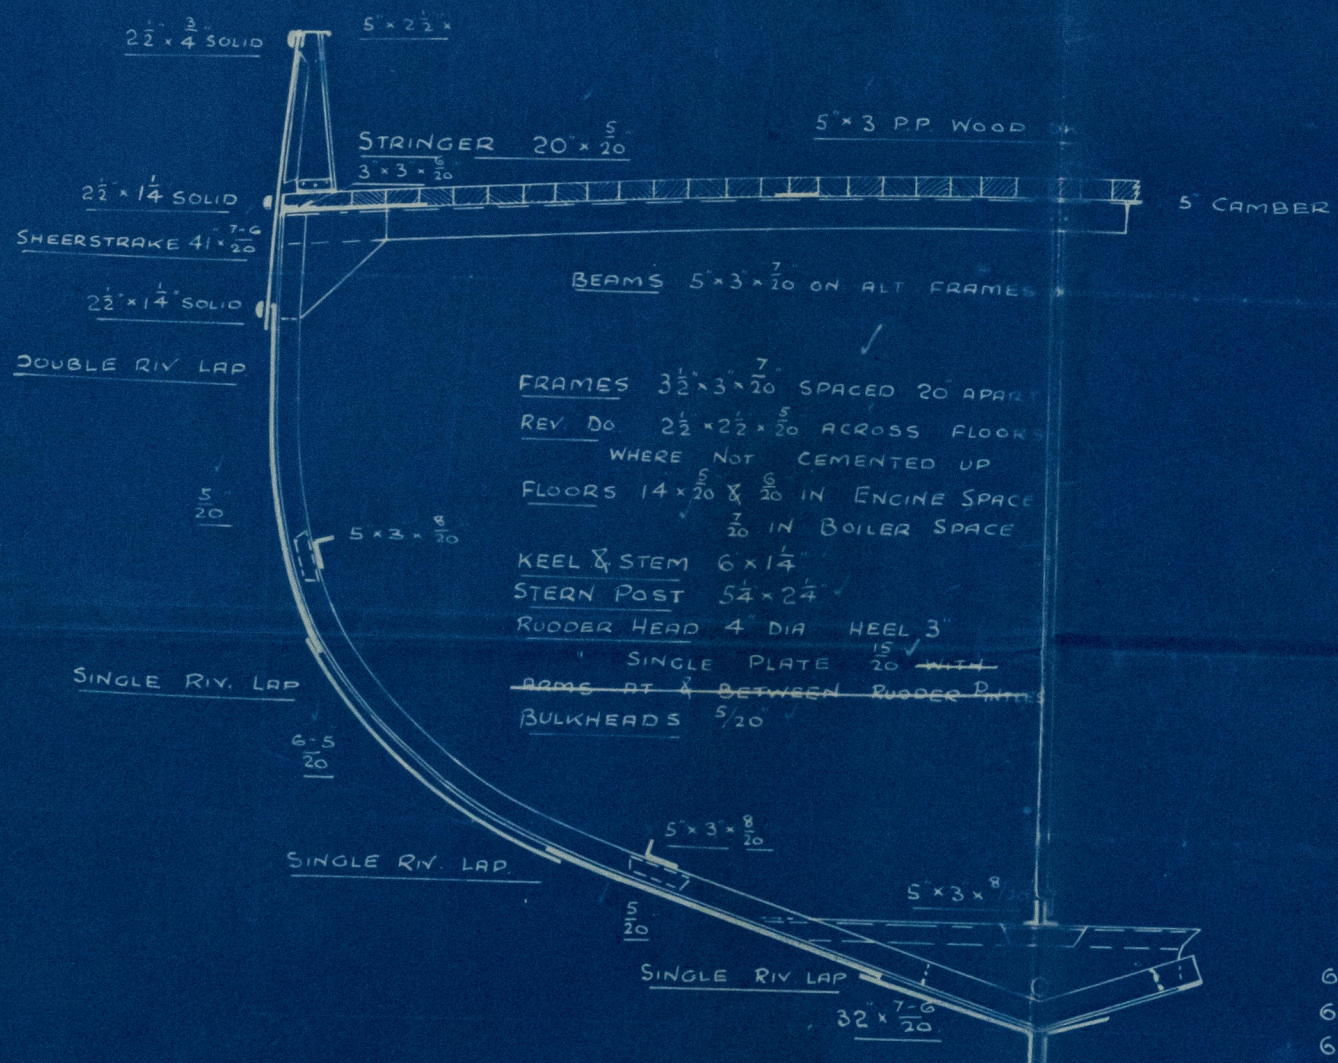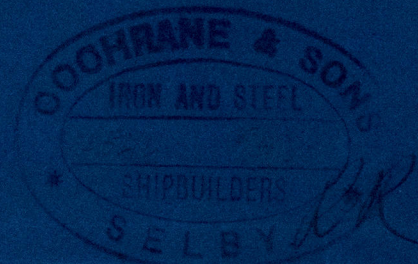

NUMERALS

1/2 B	=	9.08
1/2 G	=	14.88
D	=	9.62
	=	33.58 1ST N°
RULE LENGTH	=	83.06
	=	2789.15 2ND N°

PROPORTIONS

B/D	=	8.6
B/L	=	4.5

EQUIPMENT

2. BOWER ANCHORS	3 CWT EACH EX STOCK.
1 " "	1 3/4 " " " "
60 FATHOMS	12 " CHAIN CABLE
60 " "	5" HAWSER
60 " "	2 1/2" WARP

Nos 410-411-412

410-411-412

410-411-412

410-411-412

29-1-07

Midship Seehor

Cochran & Sons

— No. 409 -

of City of Liverpool

Hull Report No. 19079

RETAIN



© 2021

Lloyd's Register
Foundation

W1412-0099