

Nos 405-6-7-8 & 9. 410-411 & 412

STEEL SCREW DRIFTERS



# MIDSHIP SECTION

DIMENSIONS 84'-0" x 18'-3" x 9'-3" M<sup>10</sup>

SCALE  $\frac{1}{2}$ " = 1 FOOT.

TO CLASS 100 A1 FOR FISHING PURPOSES

DECK PLATED OVER IN WAY OF MACHINERY SPACE.

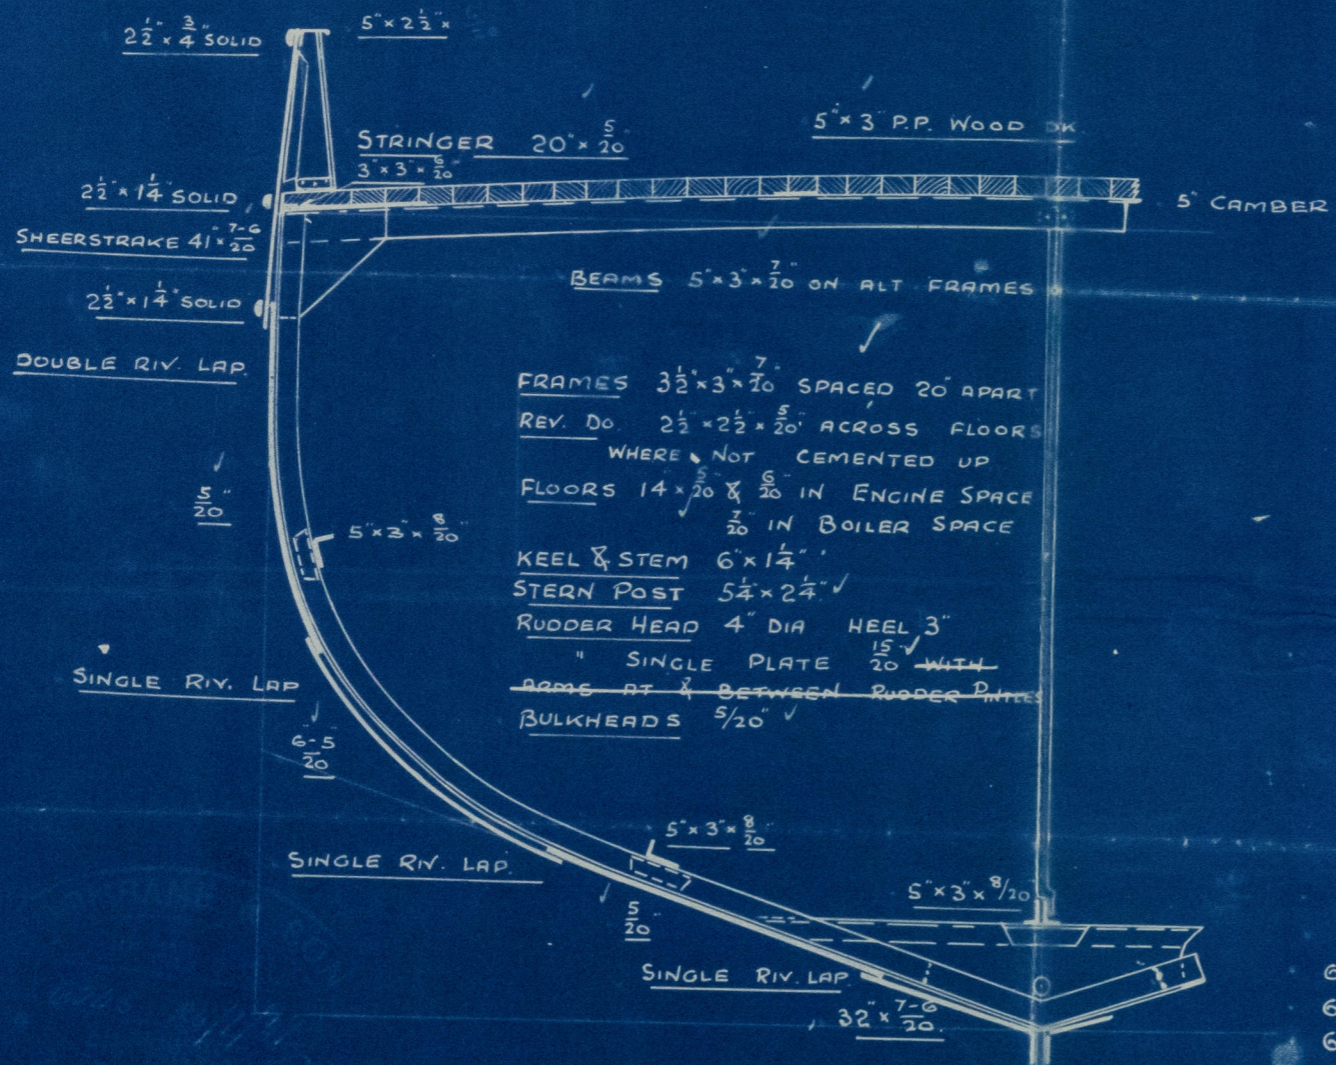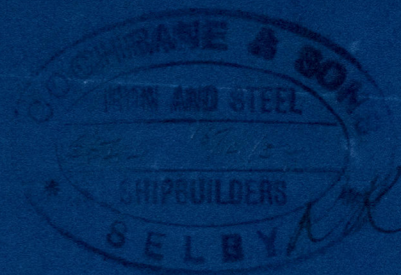

## NUMERALS.

$\frac{1}{2}$ B	=	9.08
$\frac{1}{2}$ G	=	14.88
D	=	9.62
	=	33.58 1 <sup>ST</sup> N <sup>O</sup>
RULE LENGTH	=	83.06
	=	2789.15 2 <sup>ND</sup> N <sup>O</sup>

## PROPORTIONS.

B/L	=	8.6
D/L	=	4.5

## EQUIPMENT

2. BOWER ANCHORS	3 CWT EACH EX STOCK.
1 " "	1 3/4 " " " "
60 FATHOMS	12/16 CHAIN CABLE
60 " "	5" HAWSER
60 " "	2 1/2" WARP

410 + 11.01 + 11.5.  
410 + 11.01 + 11.5.  
410 + 11.01 + 11.5.

30-1-07.  
12-2-07.  
ARRS  
29-1-07.

Midship Section

Cochran & Sons  
Selby

of City of Aberdeen

Hull Report No. 19197

RETAIN

W1412-0178



© 2021

Lloyd's Register  
Foundation