


20:12:06

LLLOYDS SURVEY.

3804

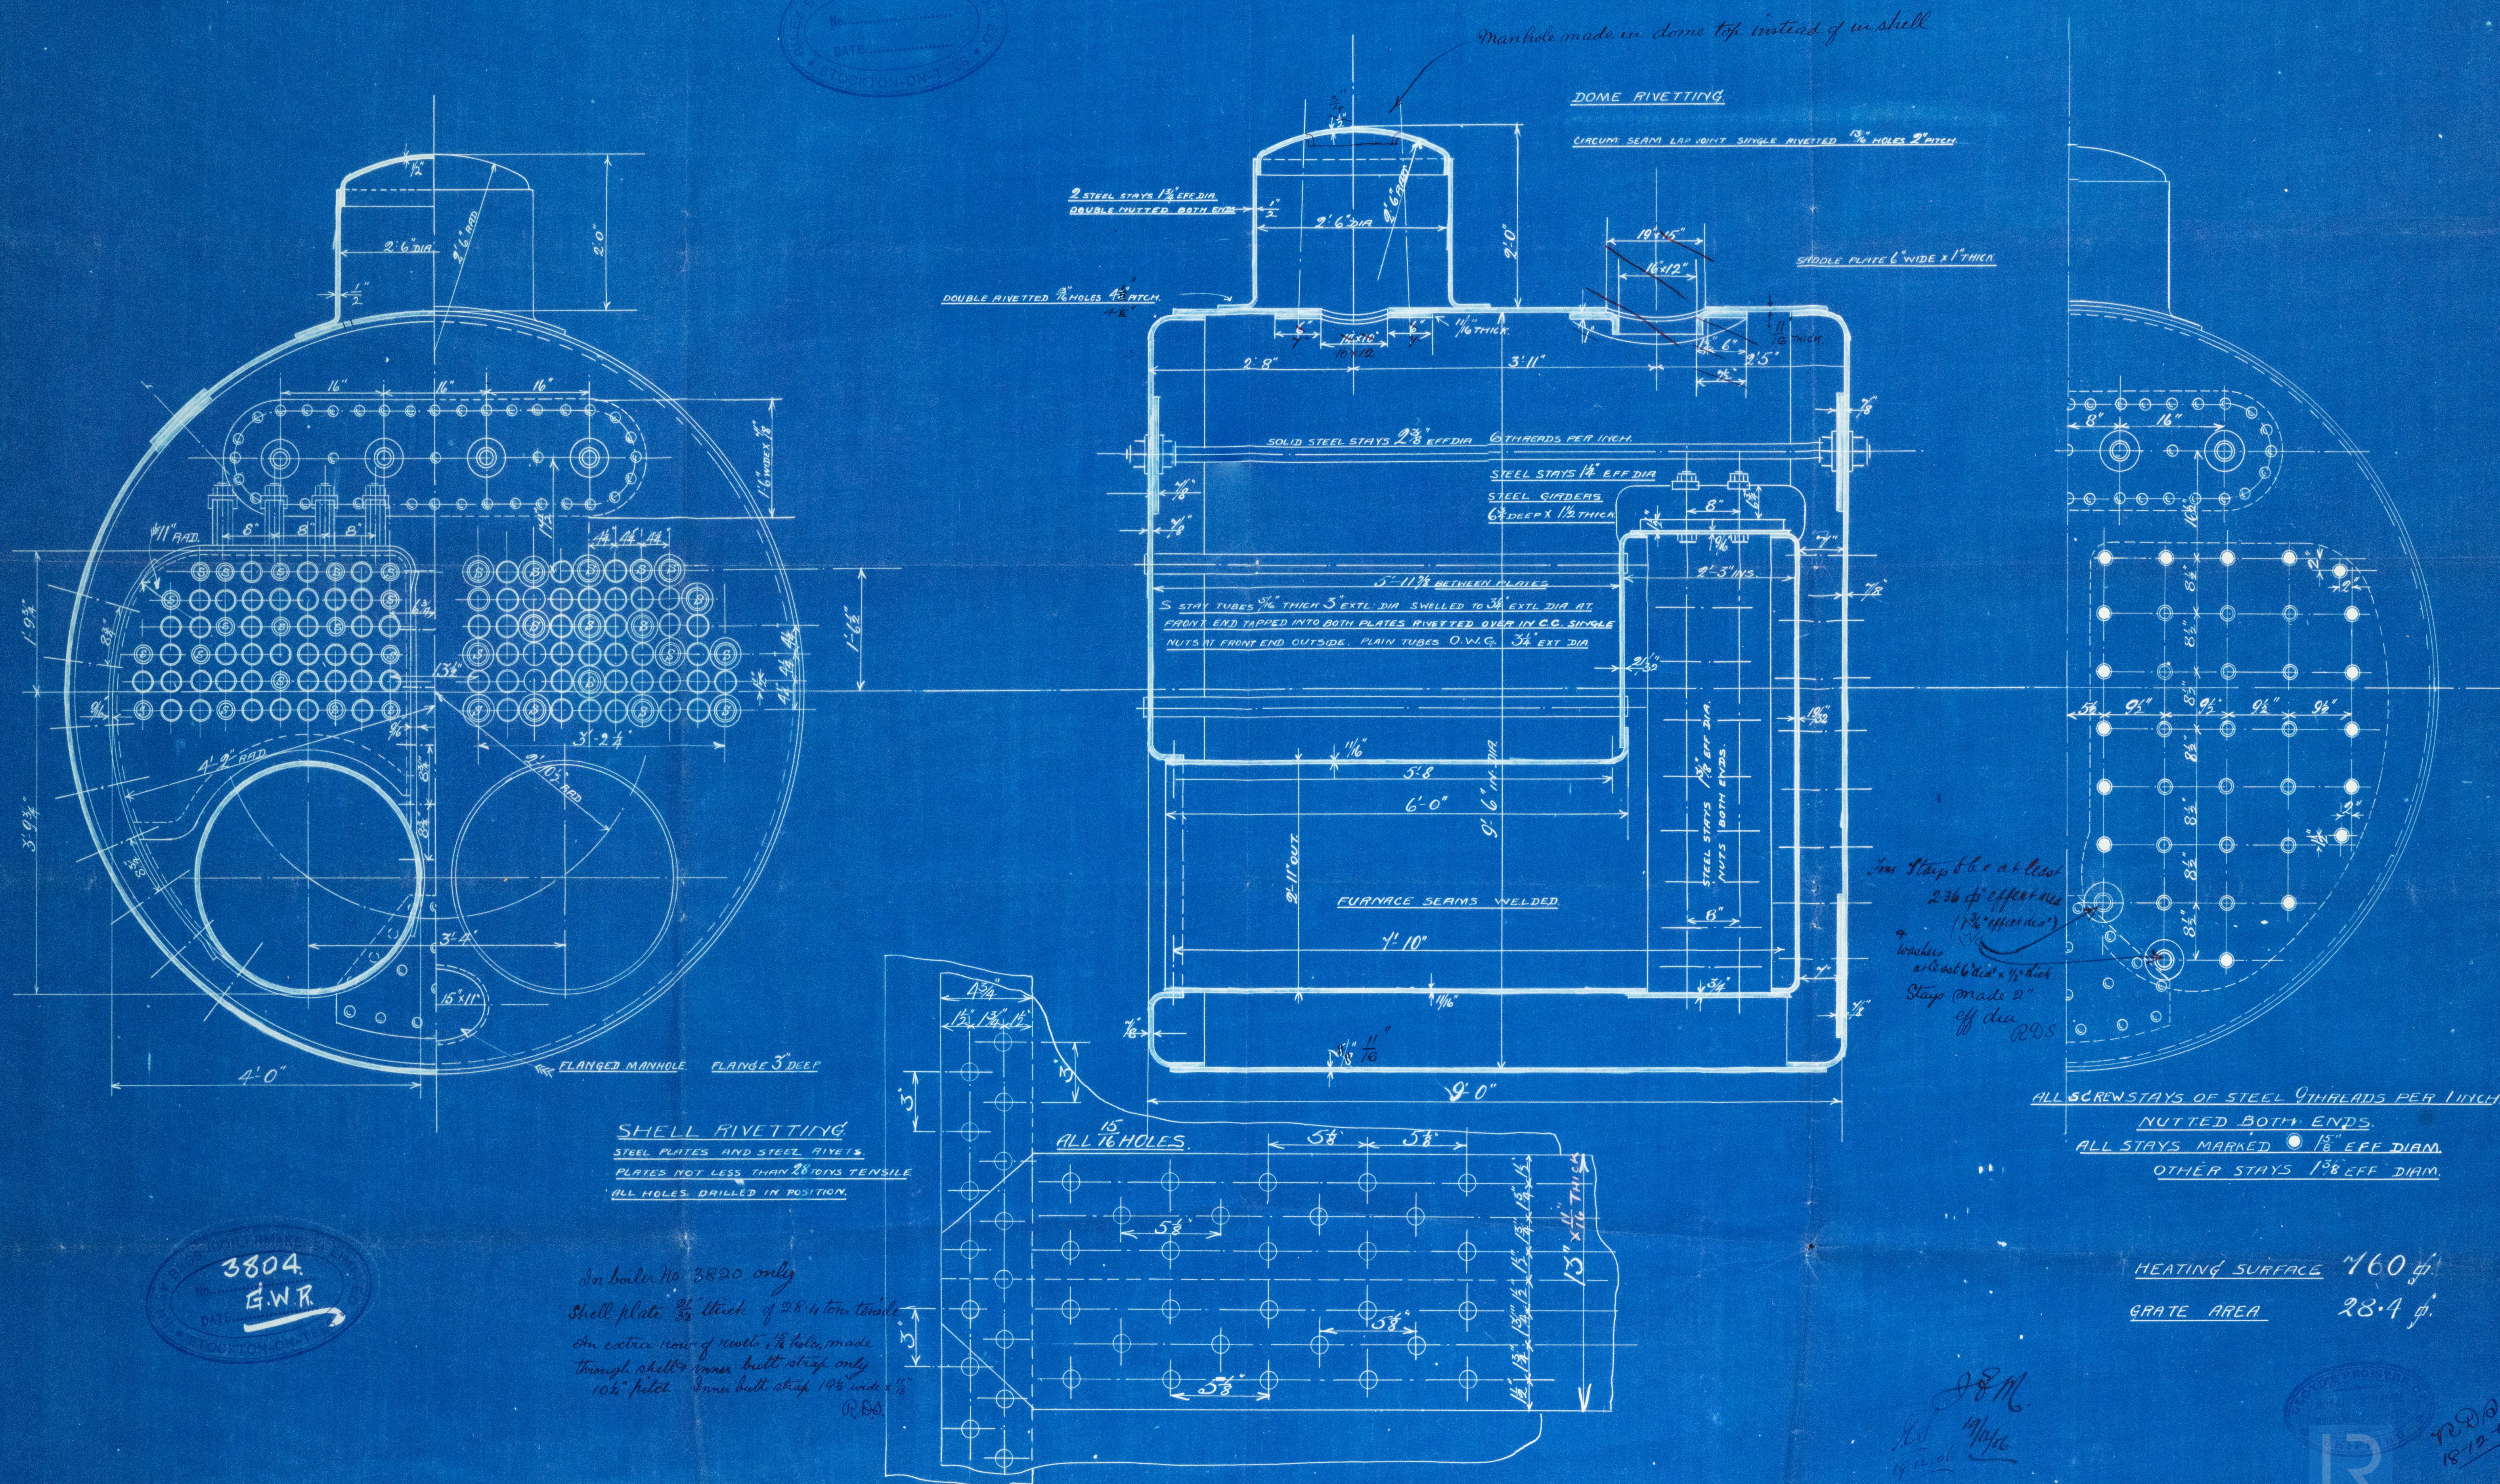

Ans. Slaps like at least
236 # of effort due
(13% effort due)
7
w/trackers
at least 6000 x 1/2 inch
Slaps made 2"
off dia
RDS

HEATING SURFACE 760 sq.
GRATE AREA 28.4 sq.

Main Boilers
Nos 3804-3810

Riley Bros Ltd

Crabtree & Co Ltd

Also boiler No 3819. 20.21.
See Riley's letter of 19.3.07.

3804
No. 3892
LLOYD'S TEST.
280 lbs.
9-4-07
R.D.S.
Mdt Report No 5000

3810
No. 3919
LLOYD'S TEST.
280 lbs.
10-5-07
R.D.S.
Mdt Report No 5054

3819
No. 3916
LLOYD'S TEST.
280 lbs.
7-5-07
R.D.S.
City of Glasgow
Mdt Report No 5040
Hull 19078

3820
No. 3928
LLOYD'S TEST.
280 lbs.
24-5-07
R.D.S.
Mdt Report No 5065

3821
No. 3924
LLOYD'S TEST.
280 lbs.
16-5-07
R.D.S.
Mdt Report No 5060

RECEIVED

W1412-02021



© 2021

Lloyd's Register
Foundation