

Nos 405-6-7-8 & 9. 410-411 & 412

STEEL SCREW DRIFTERS



# MIDSHIP SECTION

DIMENSIONS 84'-0" x 18'-3" x 9'-3" M

SCALE  $\frac{1}{2}$ " = 1 FOOT

TO CLASS 100 A1 FOR FISHING PURPOSES

DECK PLATED OVER IN WAY OF MACHINERY SPACE.

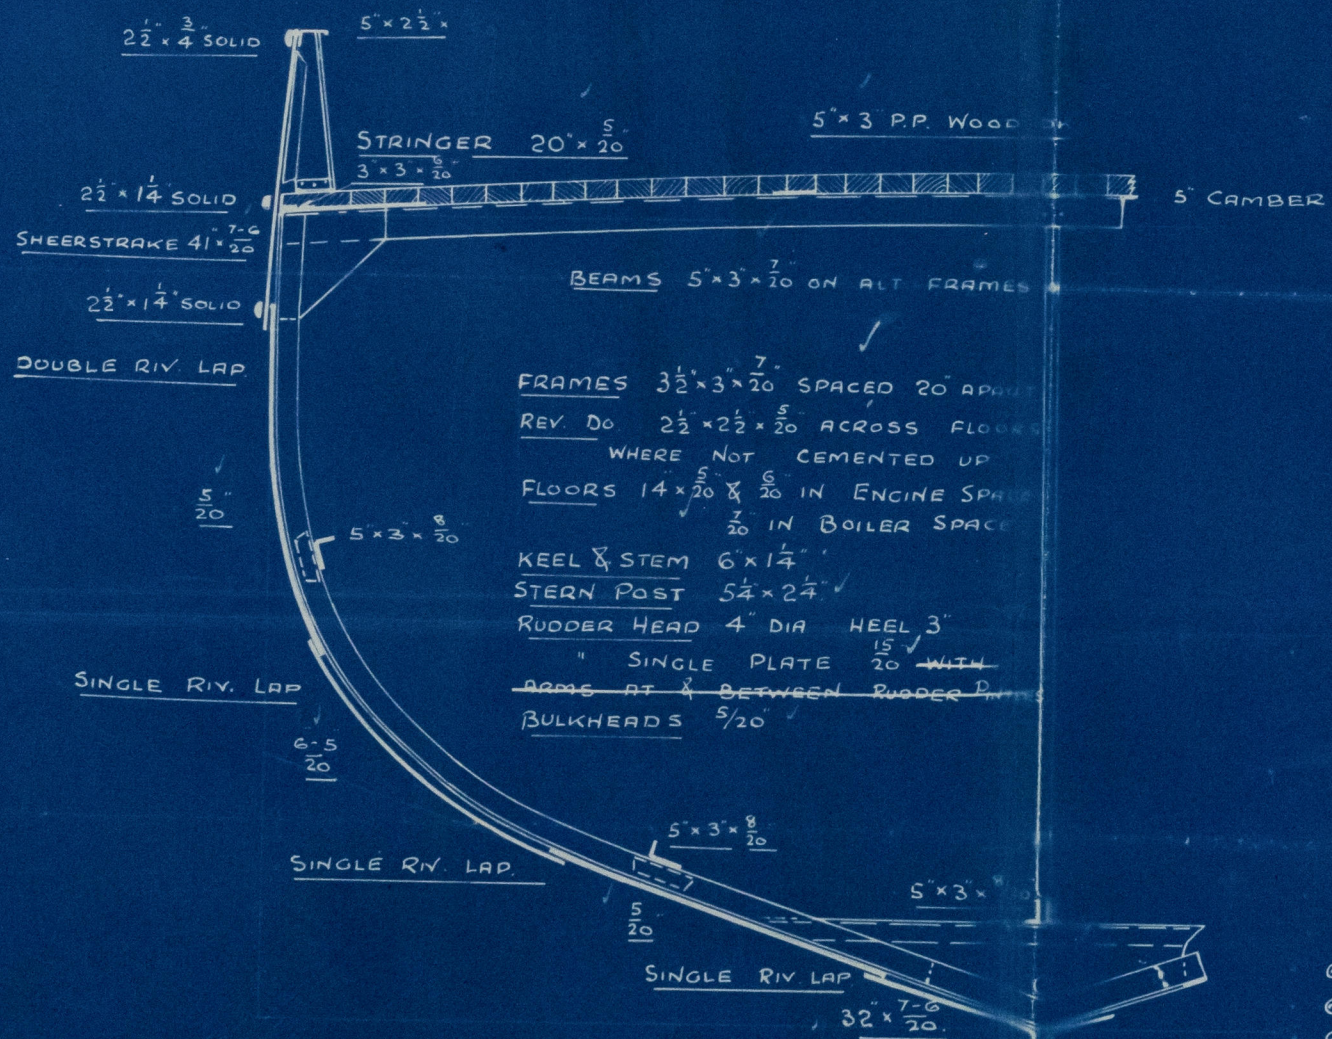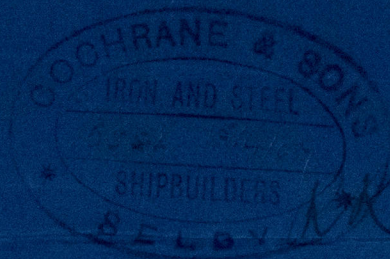

## NUMERALS.

$\frac{1}{2}$ B	=	9.08	
$\frac{1}{2}$ G	=	14.88	
D	=	9.62	
	=	33.58	1 <sup>ST</sup> N <sup>O</sup>
RULE LENGTH	=	83.06	
	=	2789.15	2 <sup>ND</sup> N <sup>O</sup>

## PROPORTIONS.

L	=	8.6
D	=	4.5
B		

## EQUIPMENT

2.	BOWER ANCHORS	3 CWT EACH EX STOCK.
1	"	$1\frac{3}{4}$ " " " "
60	FATHOMS	$\frac{12}{16}$ " CHAIN CABLE
60	"	5" HAWSER
60	"	$2\frac{1}{2}$ " WARP

Nos 405-412 only 415.

30-1-07.

WH12-0202



Midship Section  
Cochrane & Sons  
— No 410 —

City of Glasgow  
Hull Report No. 19078

PAID



© 2021

Lloyd's Register  
Foundation

W1412-0202