

Nos 405-6-7-8 & 9 & 410-411 & 412

STEEL SCREW DRIFTERS



MIDSHIP SECTION

DIMENSIONS 84'-0" x 18'-3" x 9'-3" M¹⁰

SCALE $\frac{1}{2}$ " = 1 FOOT

TO CLASS 100A1 FOR FISHING PURPOSES

DECK PLATED OVER IN WAY OF MACHINERY SPACE.

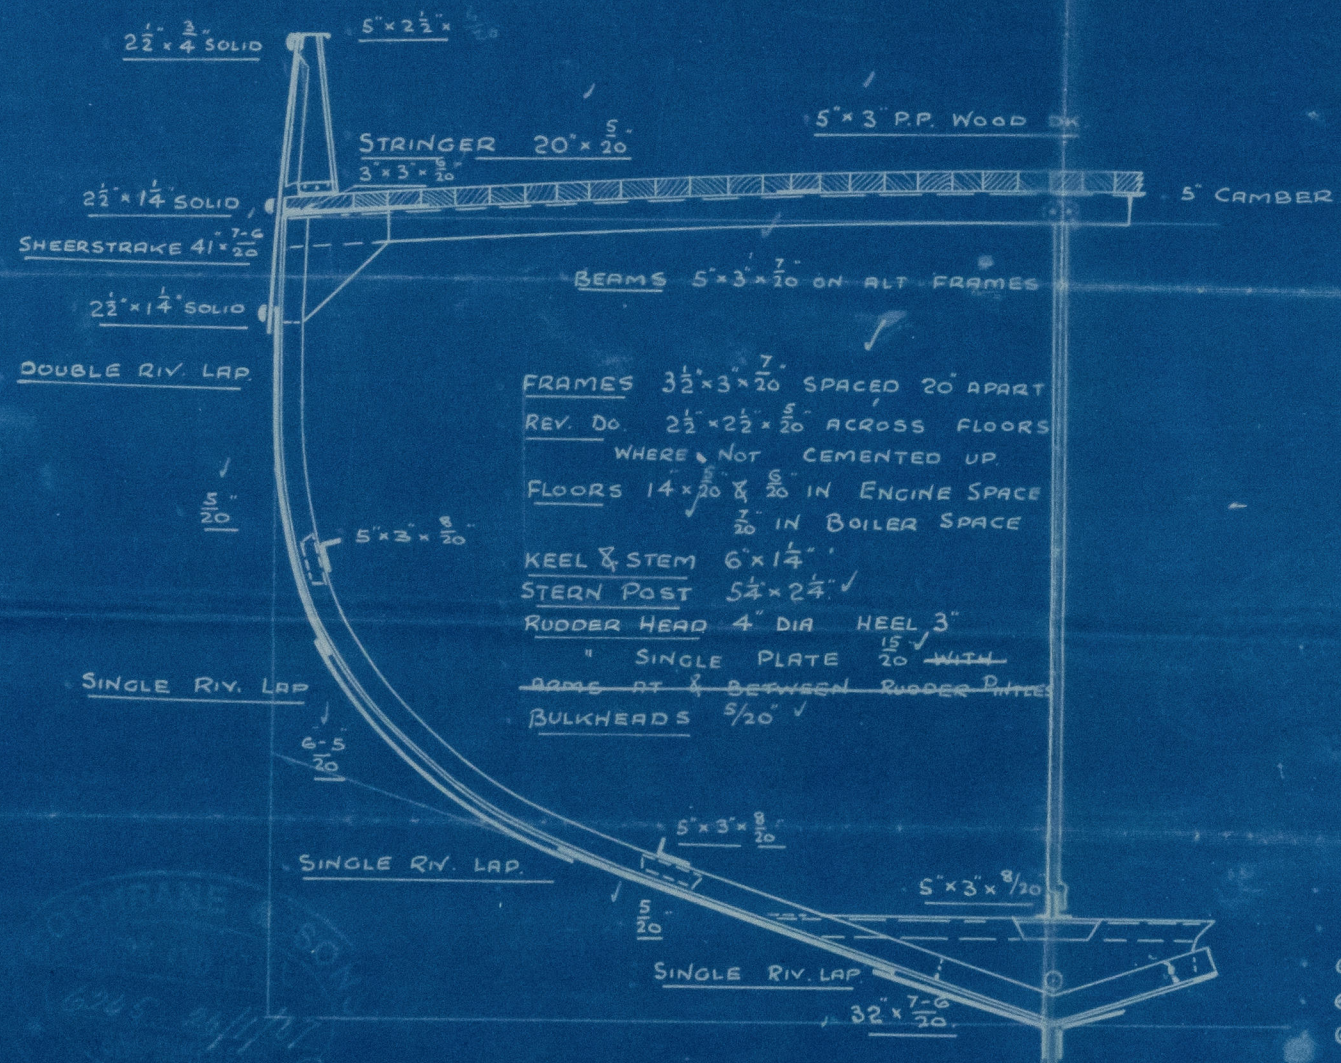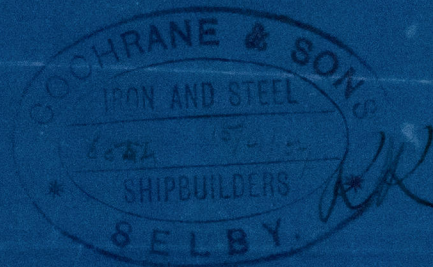

NUMERALS.

$\frac{1}{2}$ B	=	9.08
$\frac{1}{2}$ G	=	14.88
D	=	9.62
	=	33.58 1 st N ^o
RULE LENGTH	=	83.06
	=	2789.15 2 nd N ^o

PROPORTIONS.

L	=	8.6
D	=	4.5

EQUIPMENT

2.	BOWER ANCHORS	3 CWT EACH EX STOCK.
1	"	1 3/4 " " " "
60	FATHOMS	16 " CHAIN CABLE
60	"	5 " HAWSER
60	"	2 1/2 " WARP.

30-1-07.
12-2-07

Nos 410, 411, 412, 1000.

30-1-07.
29-1-07

11412-0219

Midship Section
Cochran & Sons

- No. 406 -

s/s City of Hull

Hull Report No 19046



© 2021

Lloyd's Register
Foundation

W1412-0219