

Boiler No 131.

Steel Marine Boiler 8'-6" diam outside x 8'-0" long outside.

for 140^{lbs} per sq. inch W. P.

Scale 1"=1 Foot.

20/10/14

1/7/15





Drawing No 1196.


The Dock


Northwich.

3rd Oct 1914.

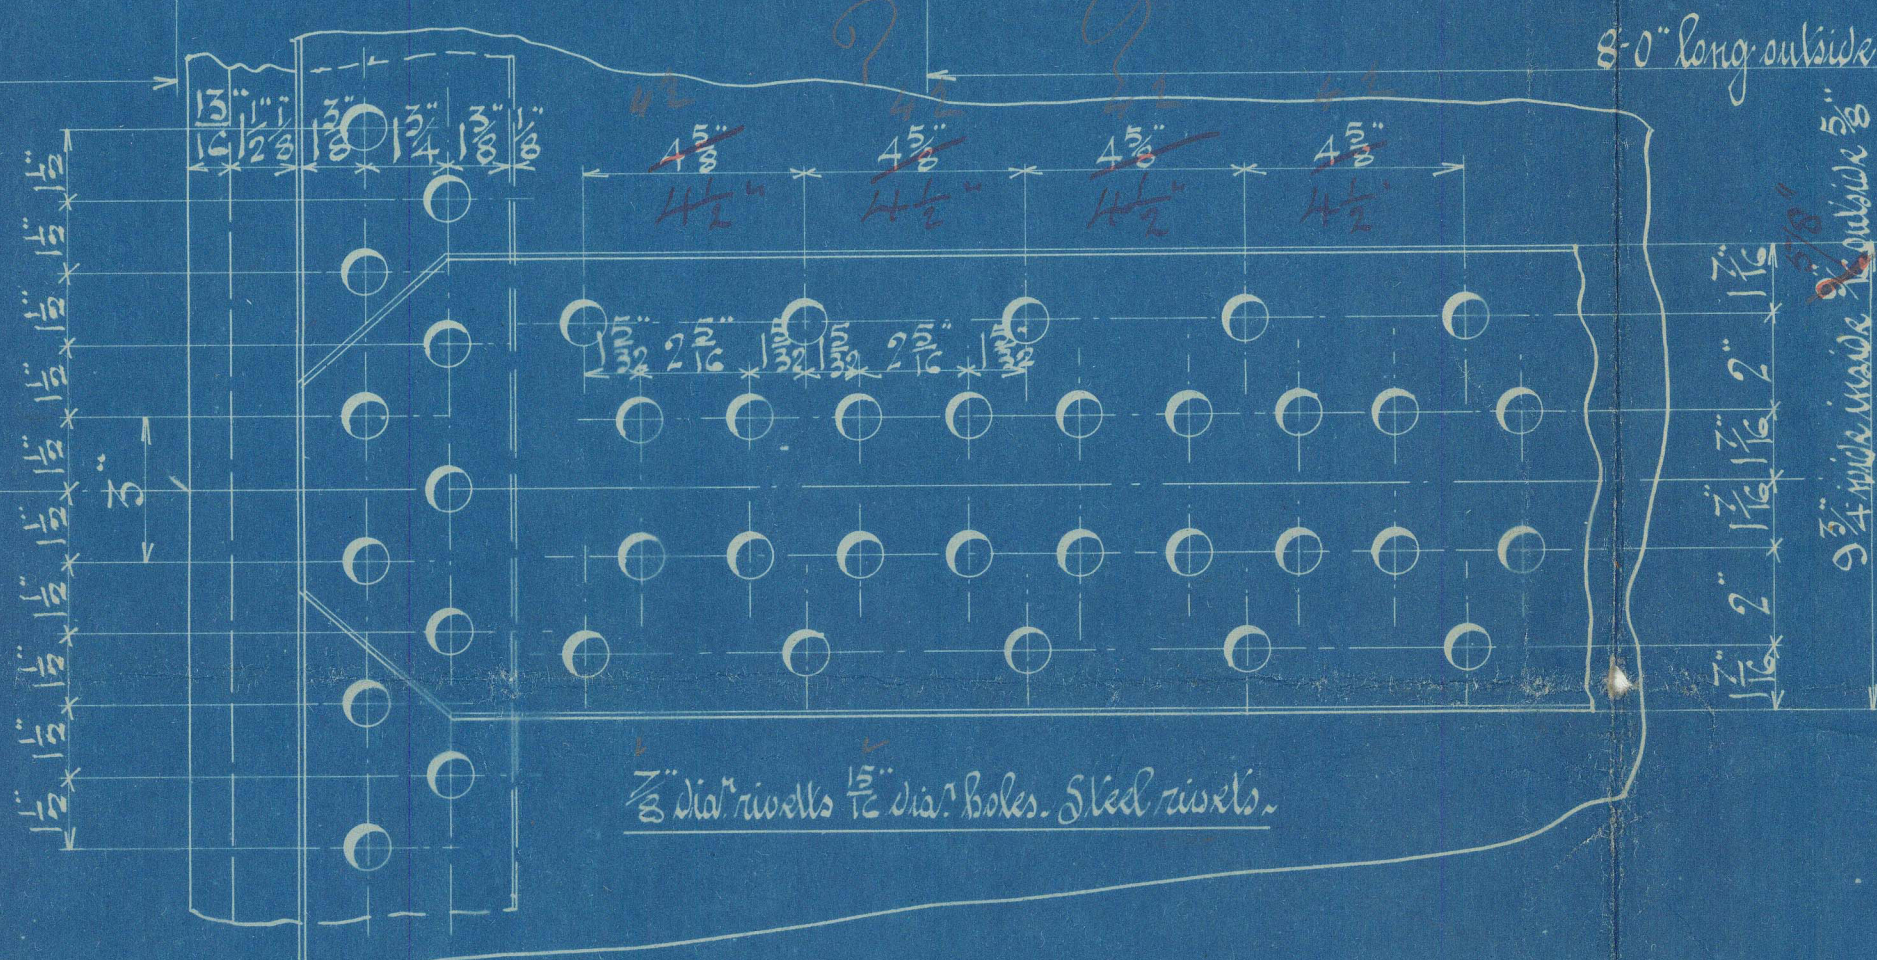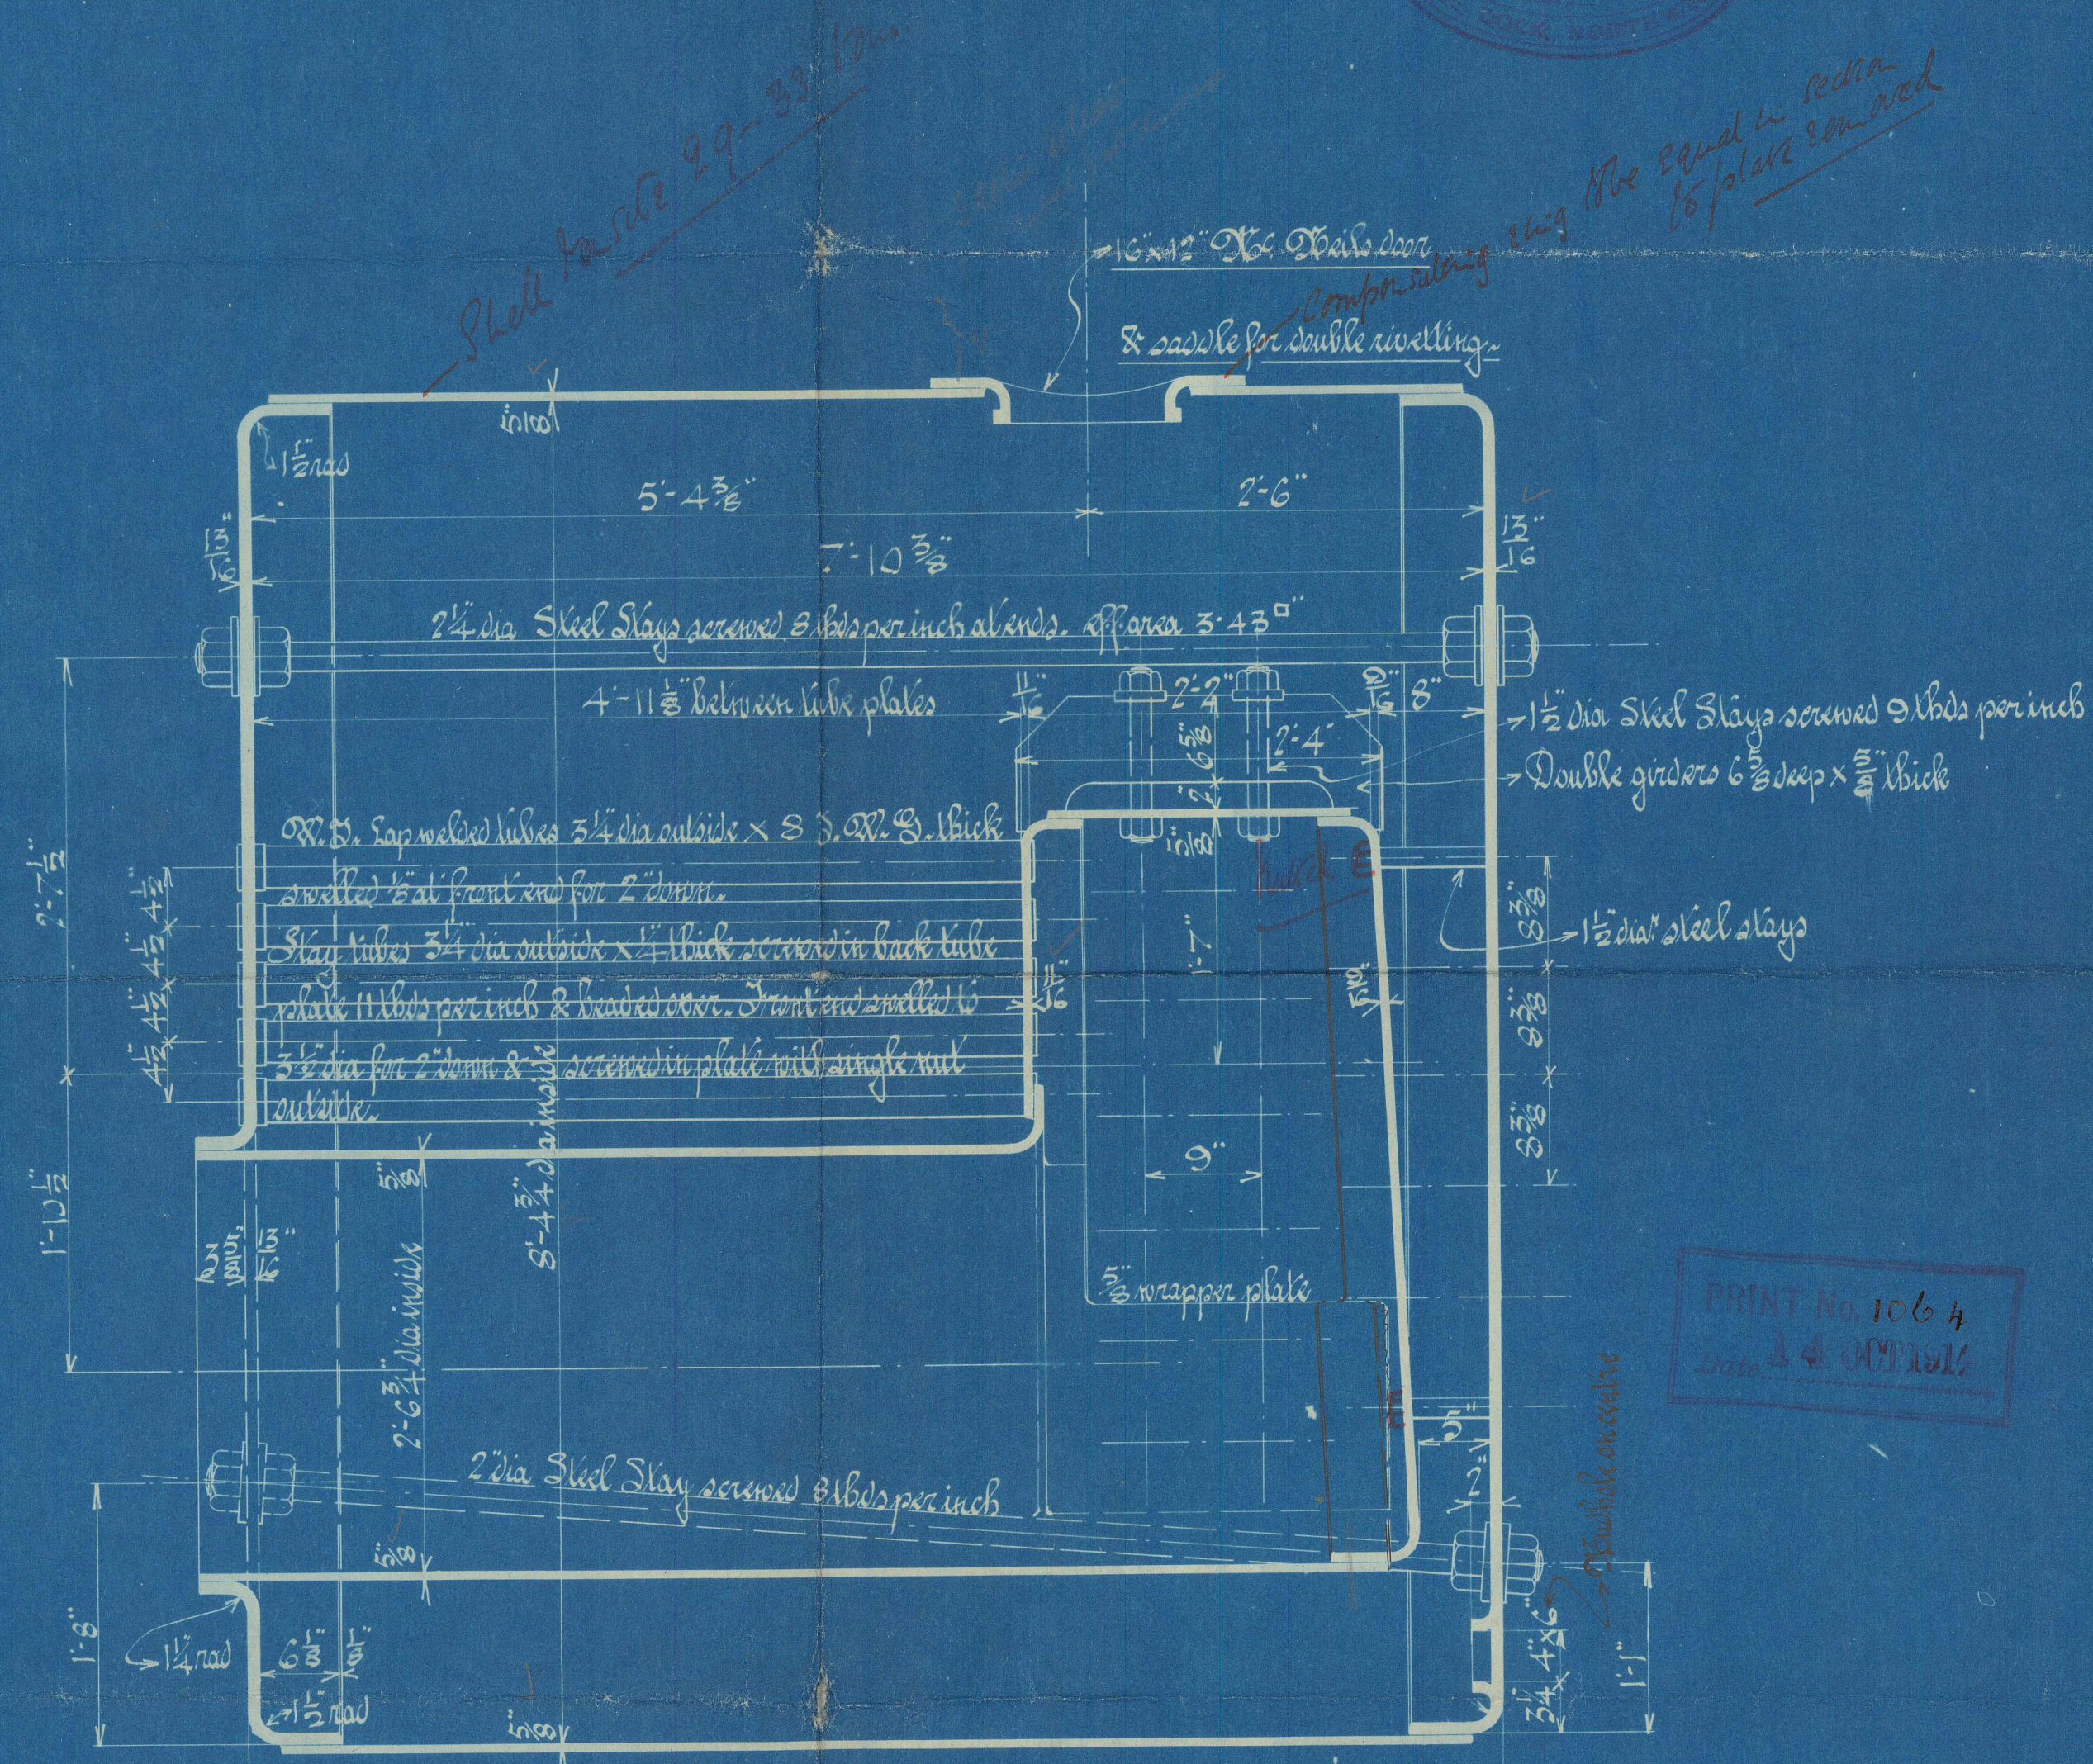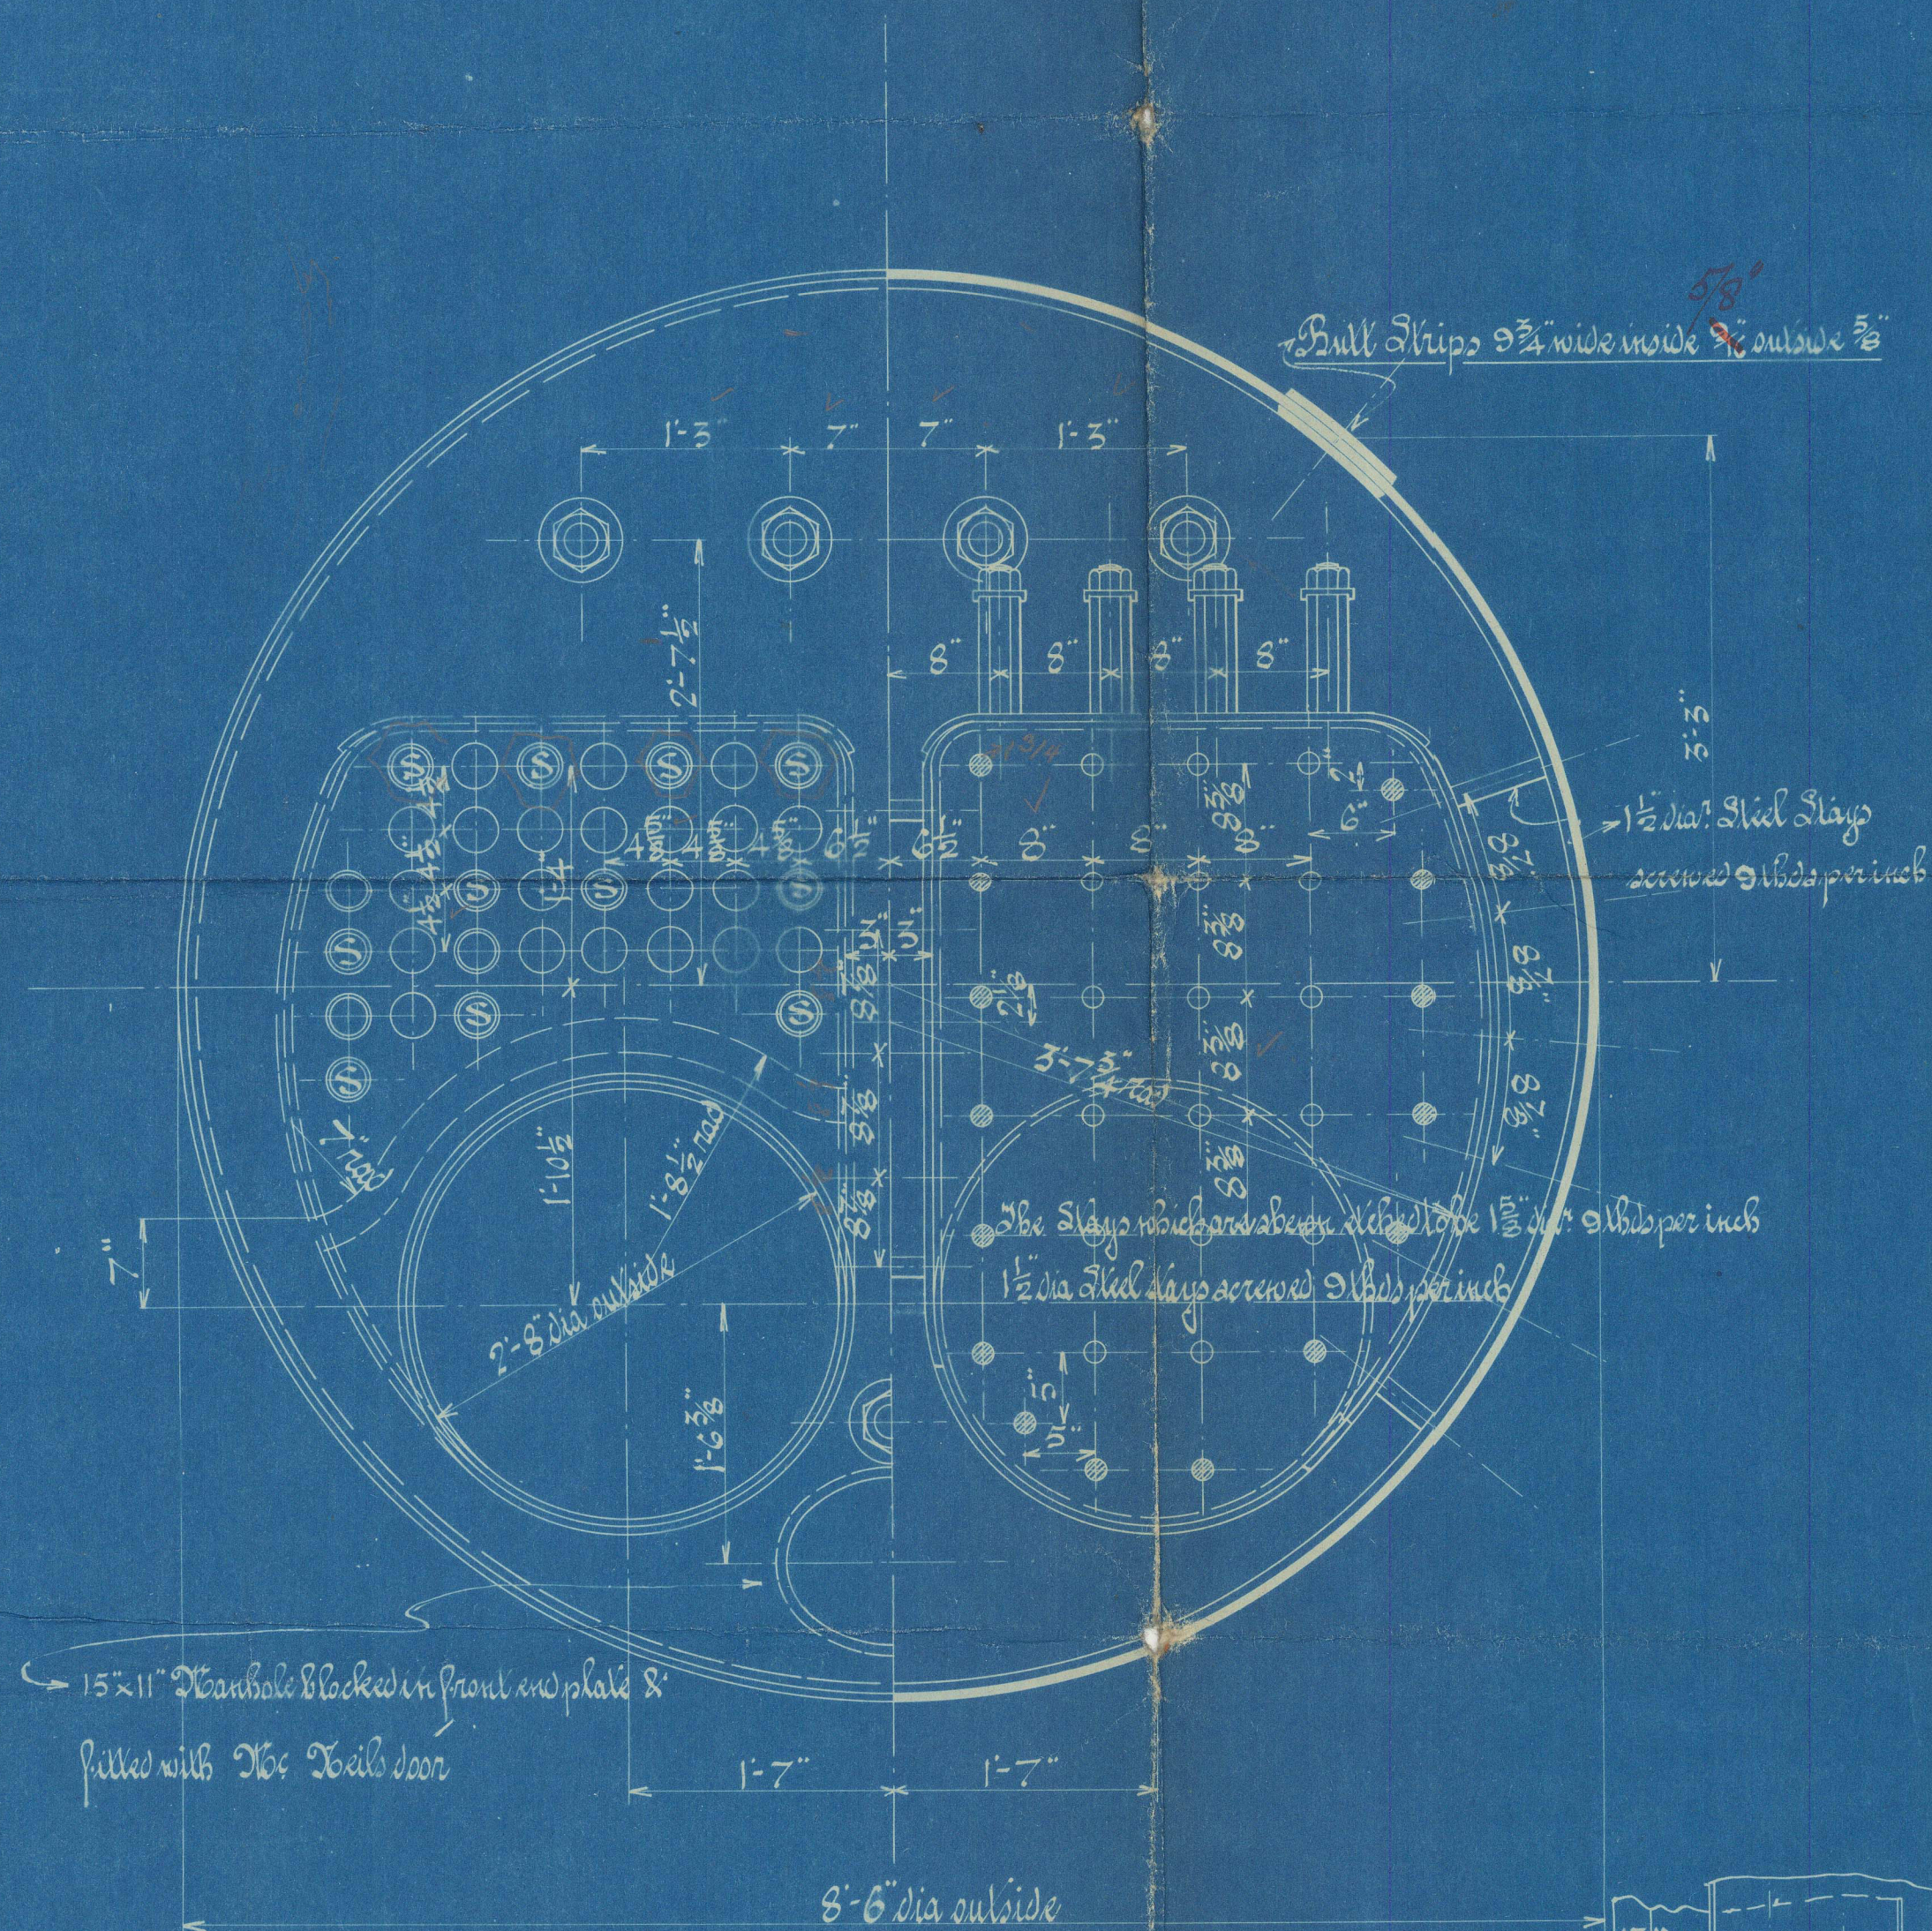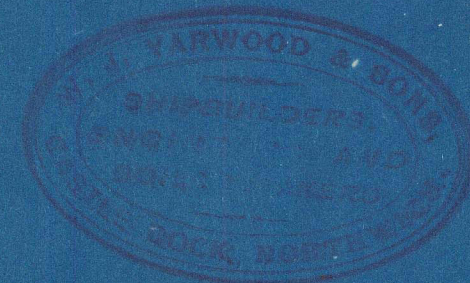

Detail of rivetting in Bull Straps & Ends Scale 3"=1 Foot.

PRINT No 1064

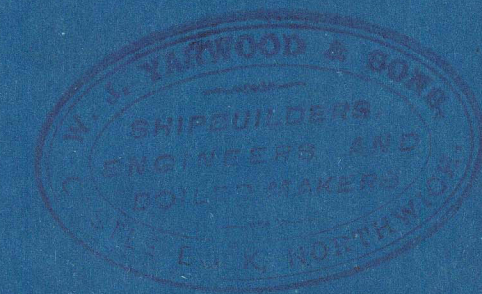

19/10/14

1/7/15



Lloyd's Register

RETAIN

Yarwood & Sons
Blk No 131.

WP 140lb

S. S. "lynfal"

Liv. Report No. 76632.

W1424-0180



© 2021

Lloyd's Register
Foundation



© 2021

Lloyd's Register
Foundation