

1.508.

TO CLASS 100 A.I. LLOYDS FOR FISHING PURPOSES.


SCALE $\frac{1}{2}$ " = 1 FT.

NUMERALS.


HALF GIRTH	19.33.
BREADTH	11.00
DEPTH	13.00
1 ST NO	43.33
LENGTH	123.87
2 ND NO	5367.28.

EQUIPMENT N° 5357.

✓ 1 ANCHOR	62NTS	3QR.	14LBS	STOCKLESS
✓ 1 "	50NTS		EX	STOCK
✓ 1 "	2 ³ / ₄ "		"	"
✓ 105 FTHMS	1 ¹ / ₁₆ "	STUD LINK	CHAIN	
✓ 60 "	6 "	HAWSER		
✓ 60 "	4 ¹ / ₂ "	WARP.		
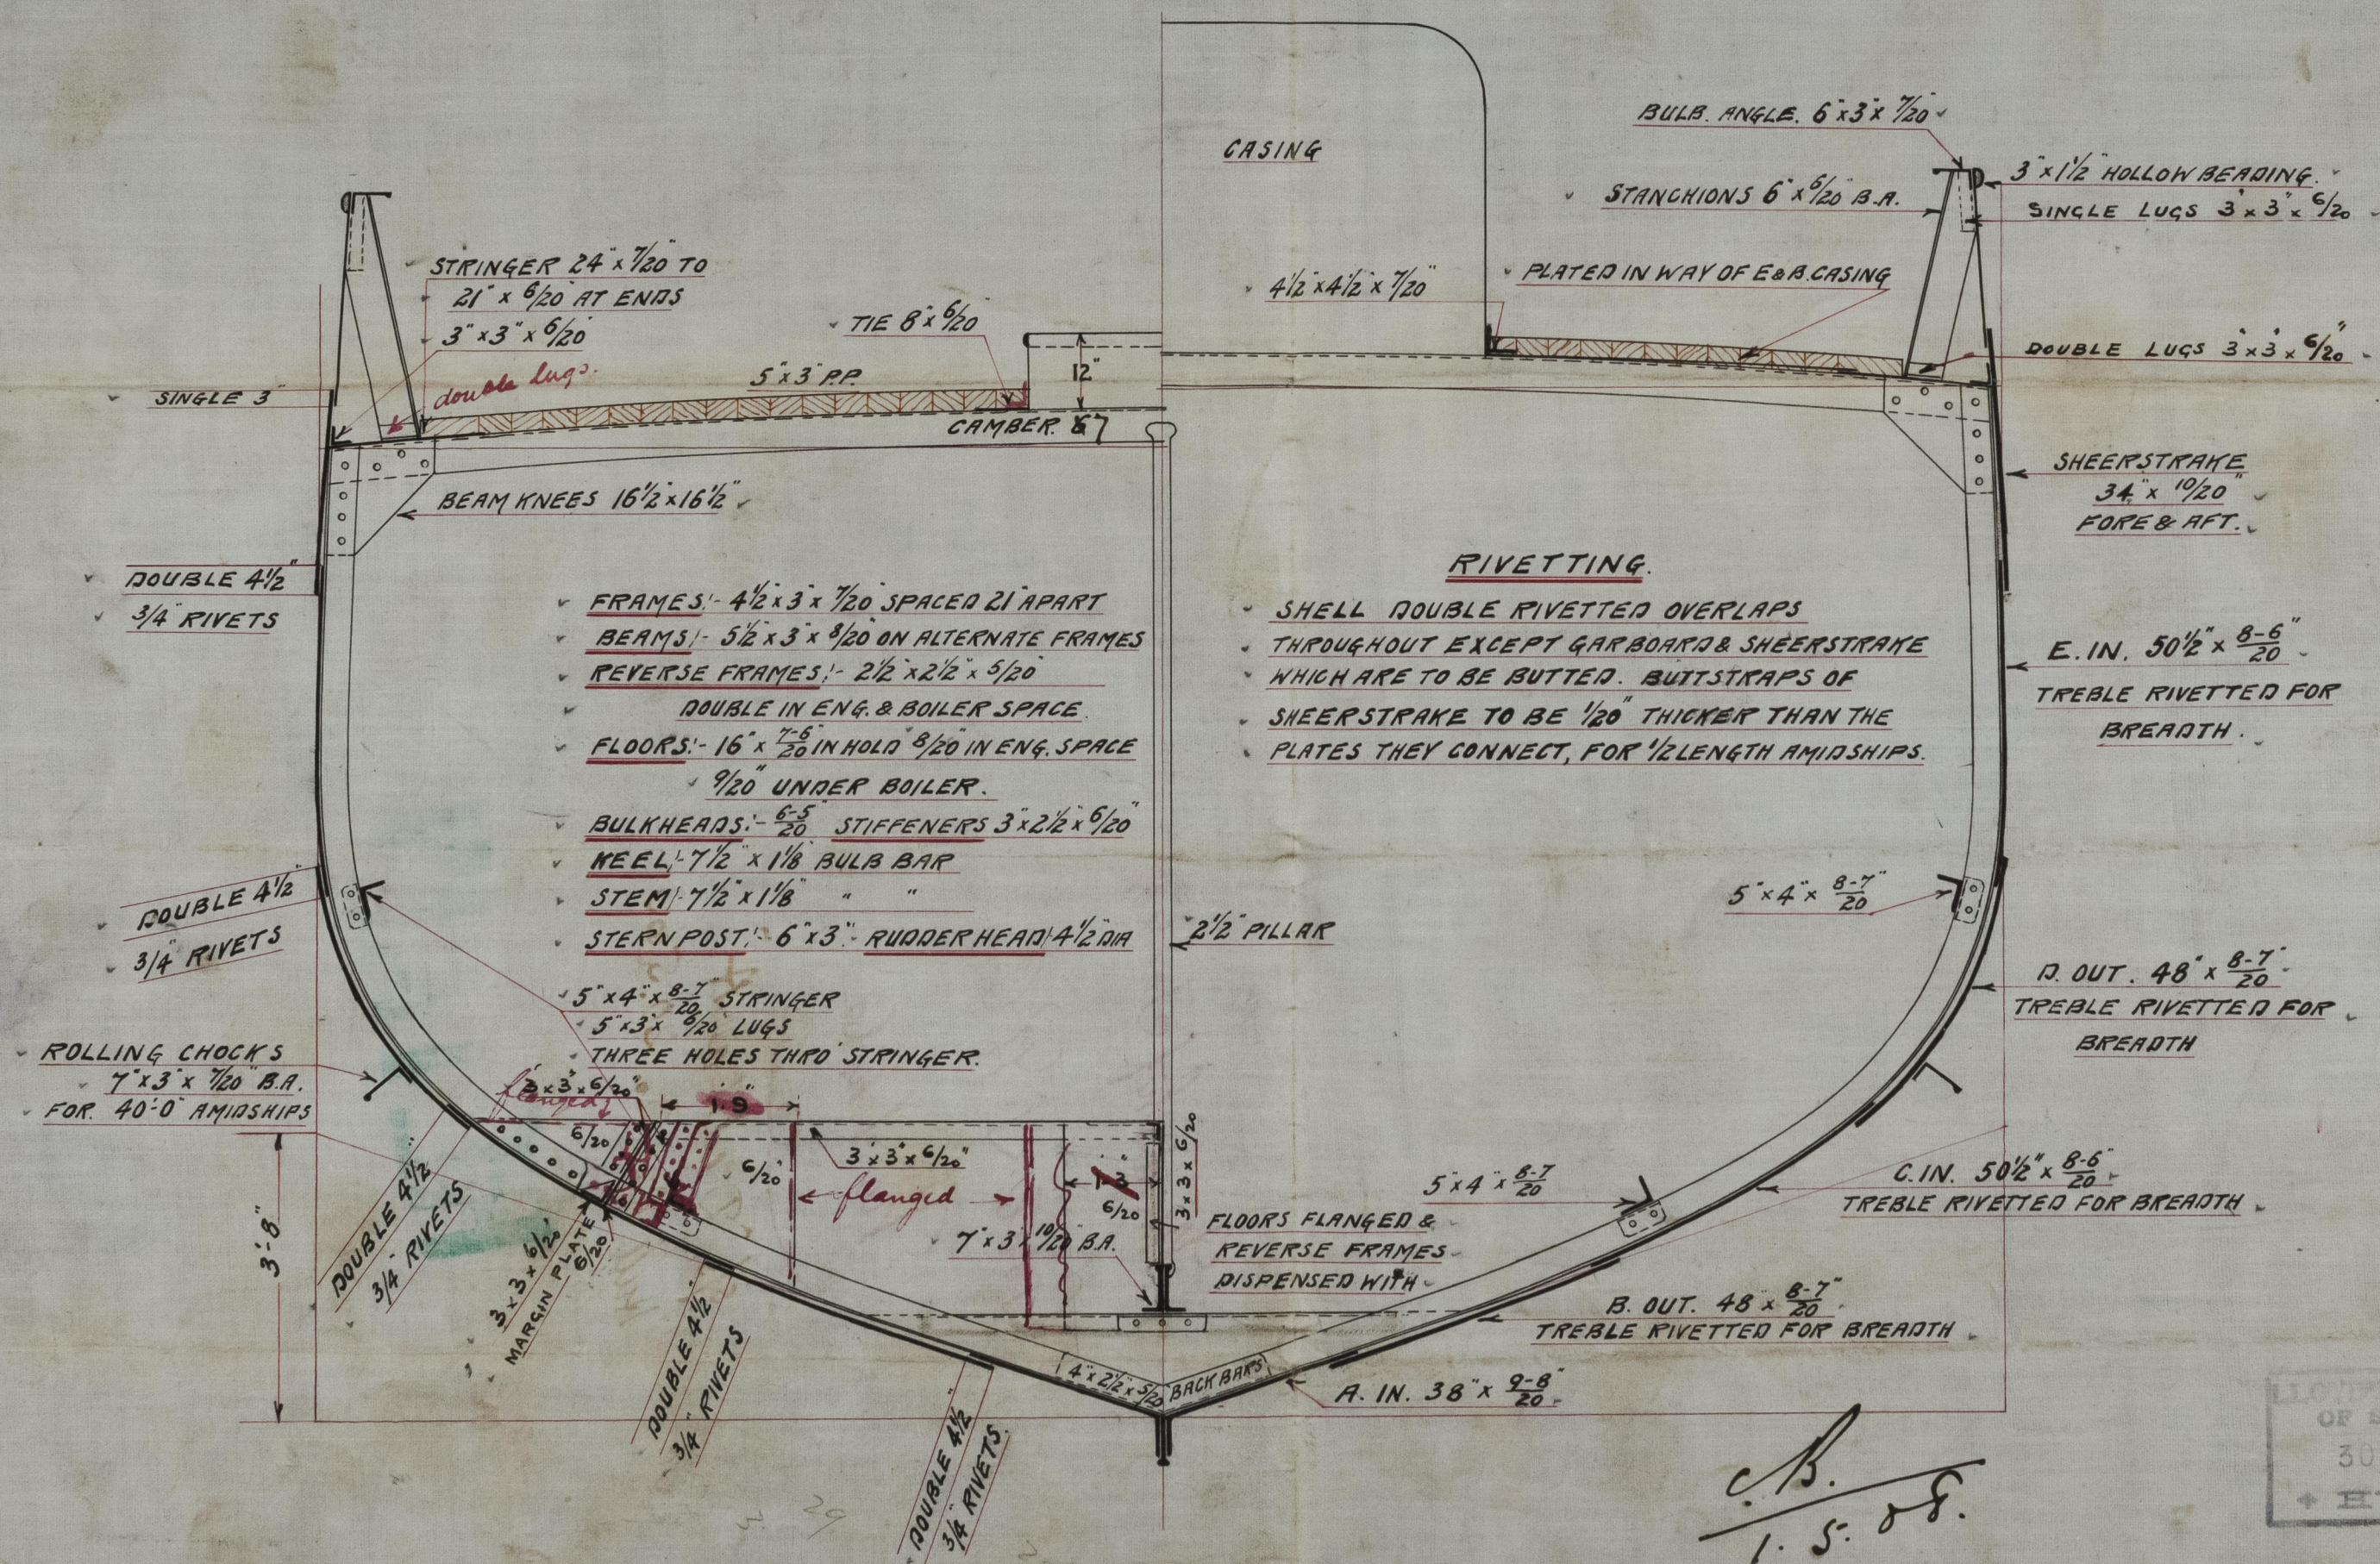
$$\checkmark \frac{L}{B} = 5.63$$
$$\frac{L}{n} = 9.52$$


B. J. Depth to Launch top 9-45

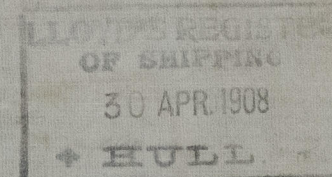

Midship Section

Goole S. H. Co's

No 126

s/s Delta A

Hull Rph No. 20.563

RECEIVED



© 2021

Lloyd's Register
Foundation

W1426-0054