


1.5.08.

S. T. No 126.

PROFILE.

DIMS. 125'-0" B.P. x 22'-0" M.L. x 12'-6" M.H.

SCALE 1/4" = 1 FT.

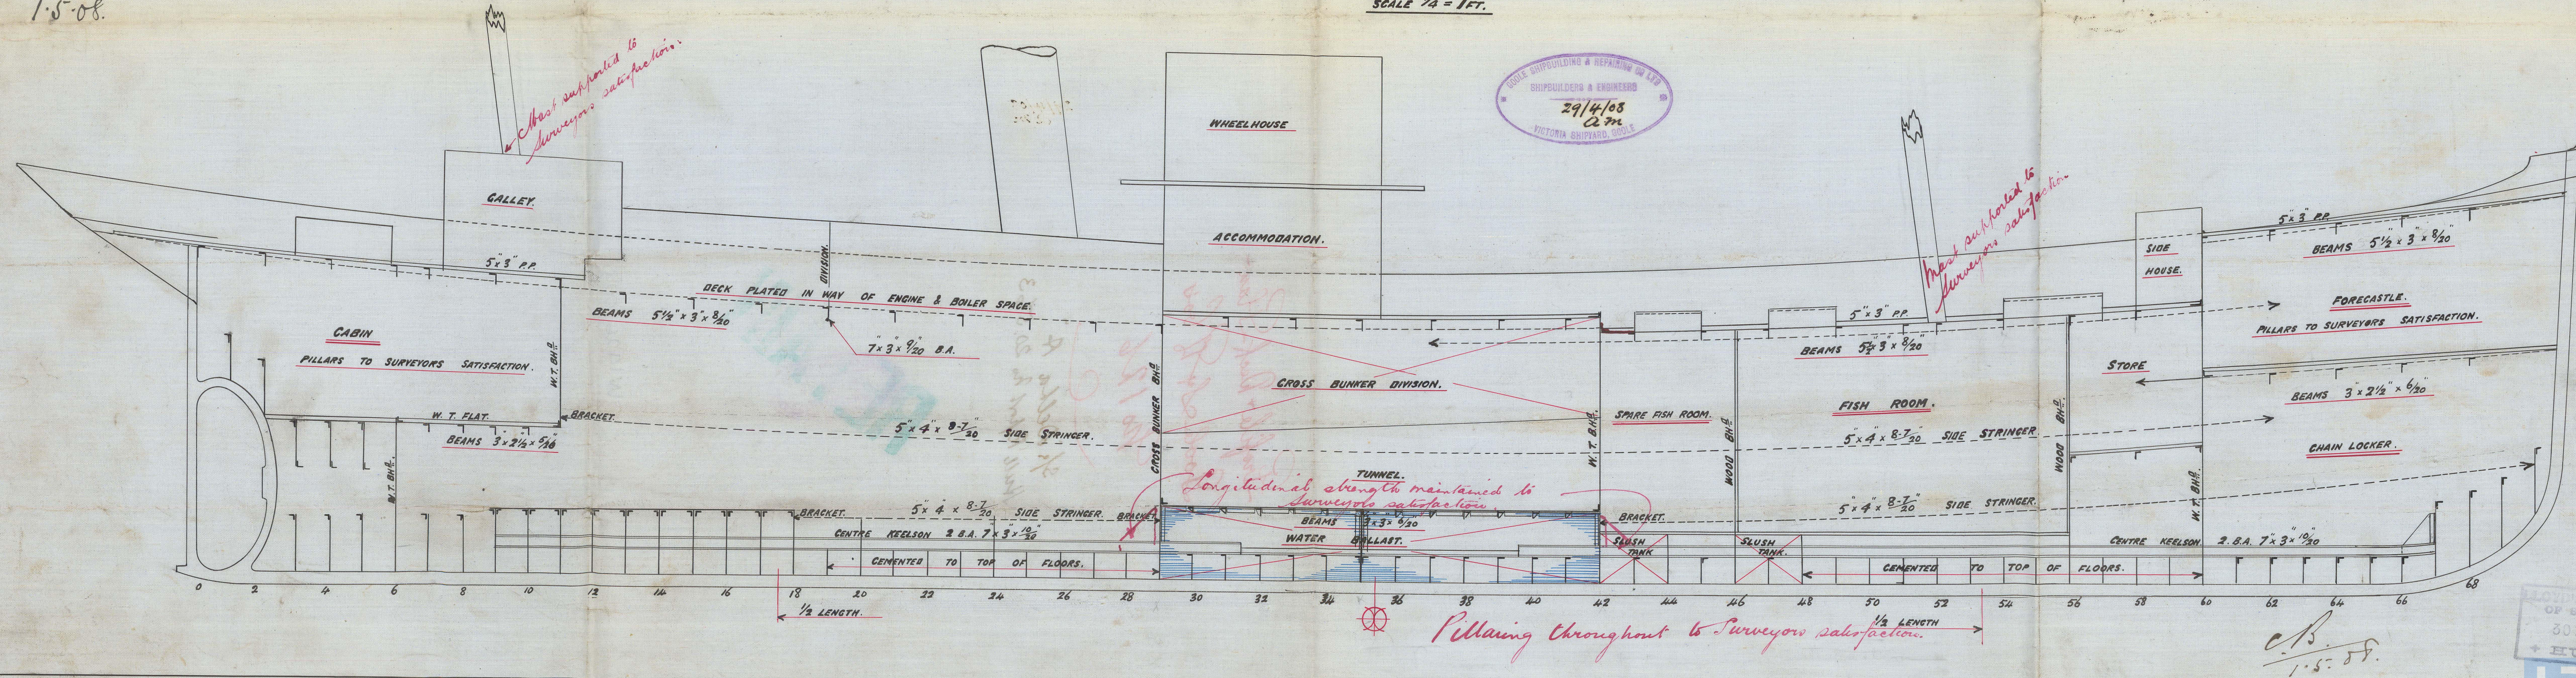


LLOYD'S REGISTER OF SHIPPING
30 APR. 1908
HULL

Profile + Deck Plan -
Goole S & W Co's

No 126

S/S Delta A
Hull Report No 20.563

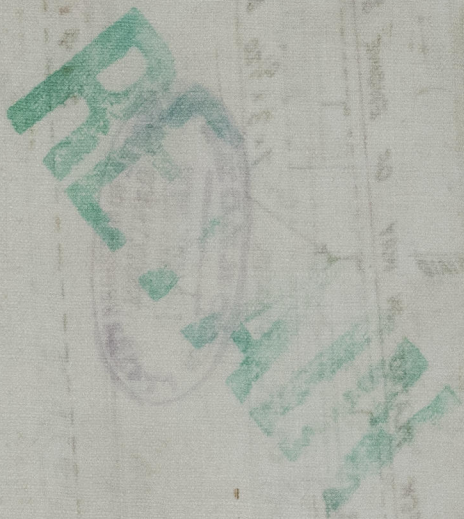

W1426-0055



© 2021

Lloyd's Register
Foundation