


WORKING PRESSURE 180 LBS PER S.Q. IN LLOYDS + BUREAU VERITAS  
TEST PRESSURE 360 " " " "  
SCALE 1 = 1 FOOT.



Boules for  
A 110

Messrs Earles. C. L.  
s/s Delta A  
Hull Report No. 20, 563

No 1665  
Lloyds Test  
360 lbs  
15.8.08  
J. H. G.

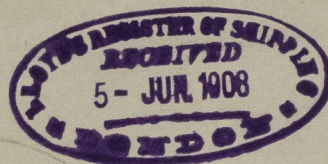

20 L...  
126.08  
RE-AL

W1426-0056



© 2021

Lloyd's Register  
Foundation