

STEAM SPACE IN ONE BOILER FROM 9" ABOVE FIREBOX TOP = 392.6
WEIGHT OF WATER (FRESH) " " " " " " " 24 1/2 TONS
DRAUGHT AREA THROUGH THE TUBES = 81.6

McNEIL'S MANHOLE DOOR 16" x 12" x 1"
AND COMPENSATING RING

STEAM SPACE STAYS
STAYS MARKED \bigcirc 3" DIA 6 THD EFF AREA = 7.239 in^2
" " \otimes ~~1 1/2~~ 6 " " = ~~4.416~~ in^2
3" 6.096 in^2


S.E. BOILER N^o 218


Beefast
Worham Clark Bay
L.S.S. 218
P. End. Baiters
U.S.S. "Delta"

Bel 5963

RETAIN

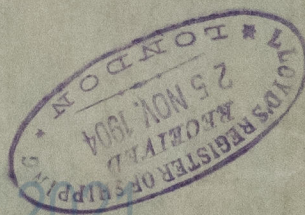

W1426-0076

© 2021

Lloyd's Register
Foundation