


MIDSHIP SECTION N° 218 T.S.S. "DELTA"

CLASS 100 A.I. 3 DECKS LLOYDS.

SCALE 1/2 INCH = 1 FOOT.


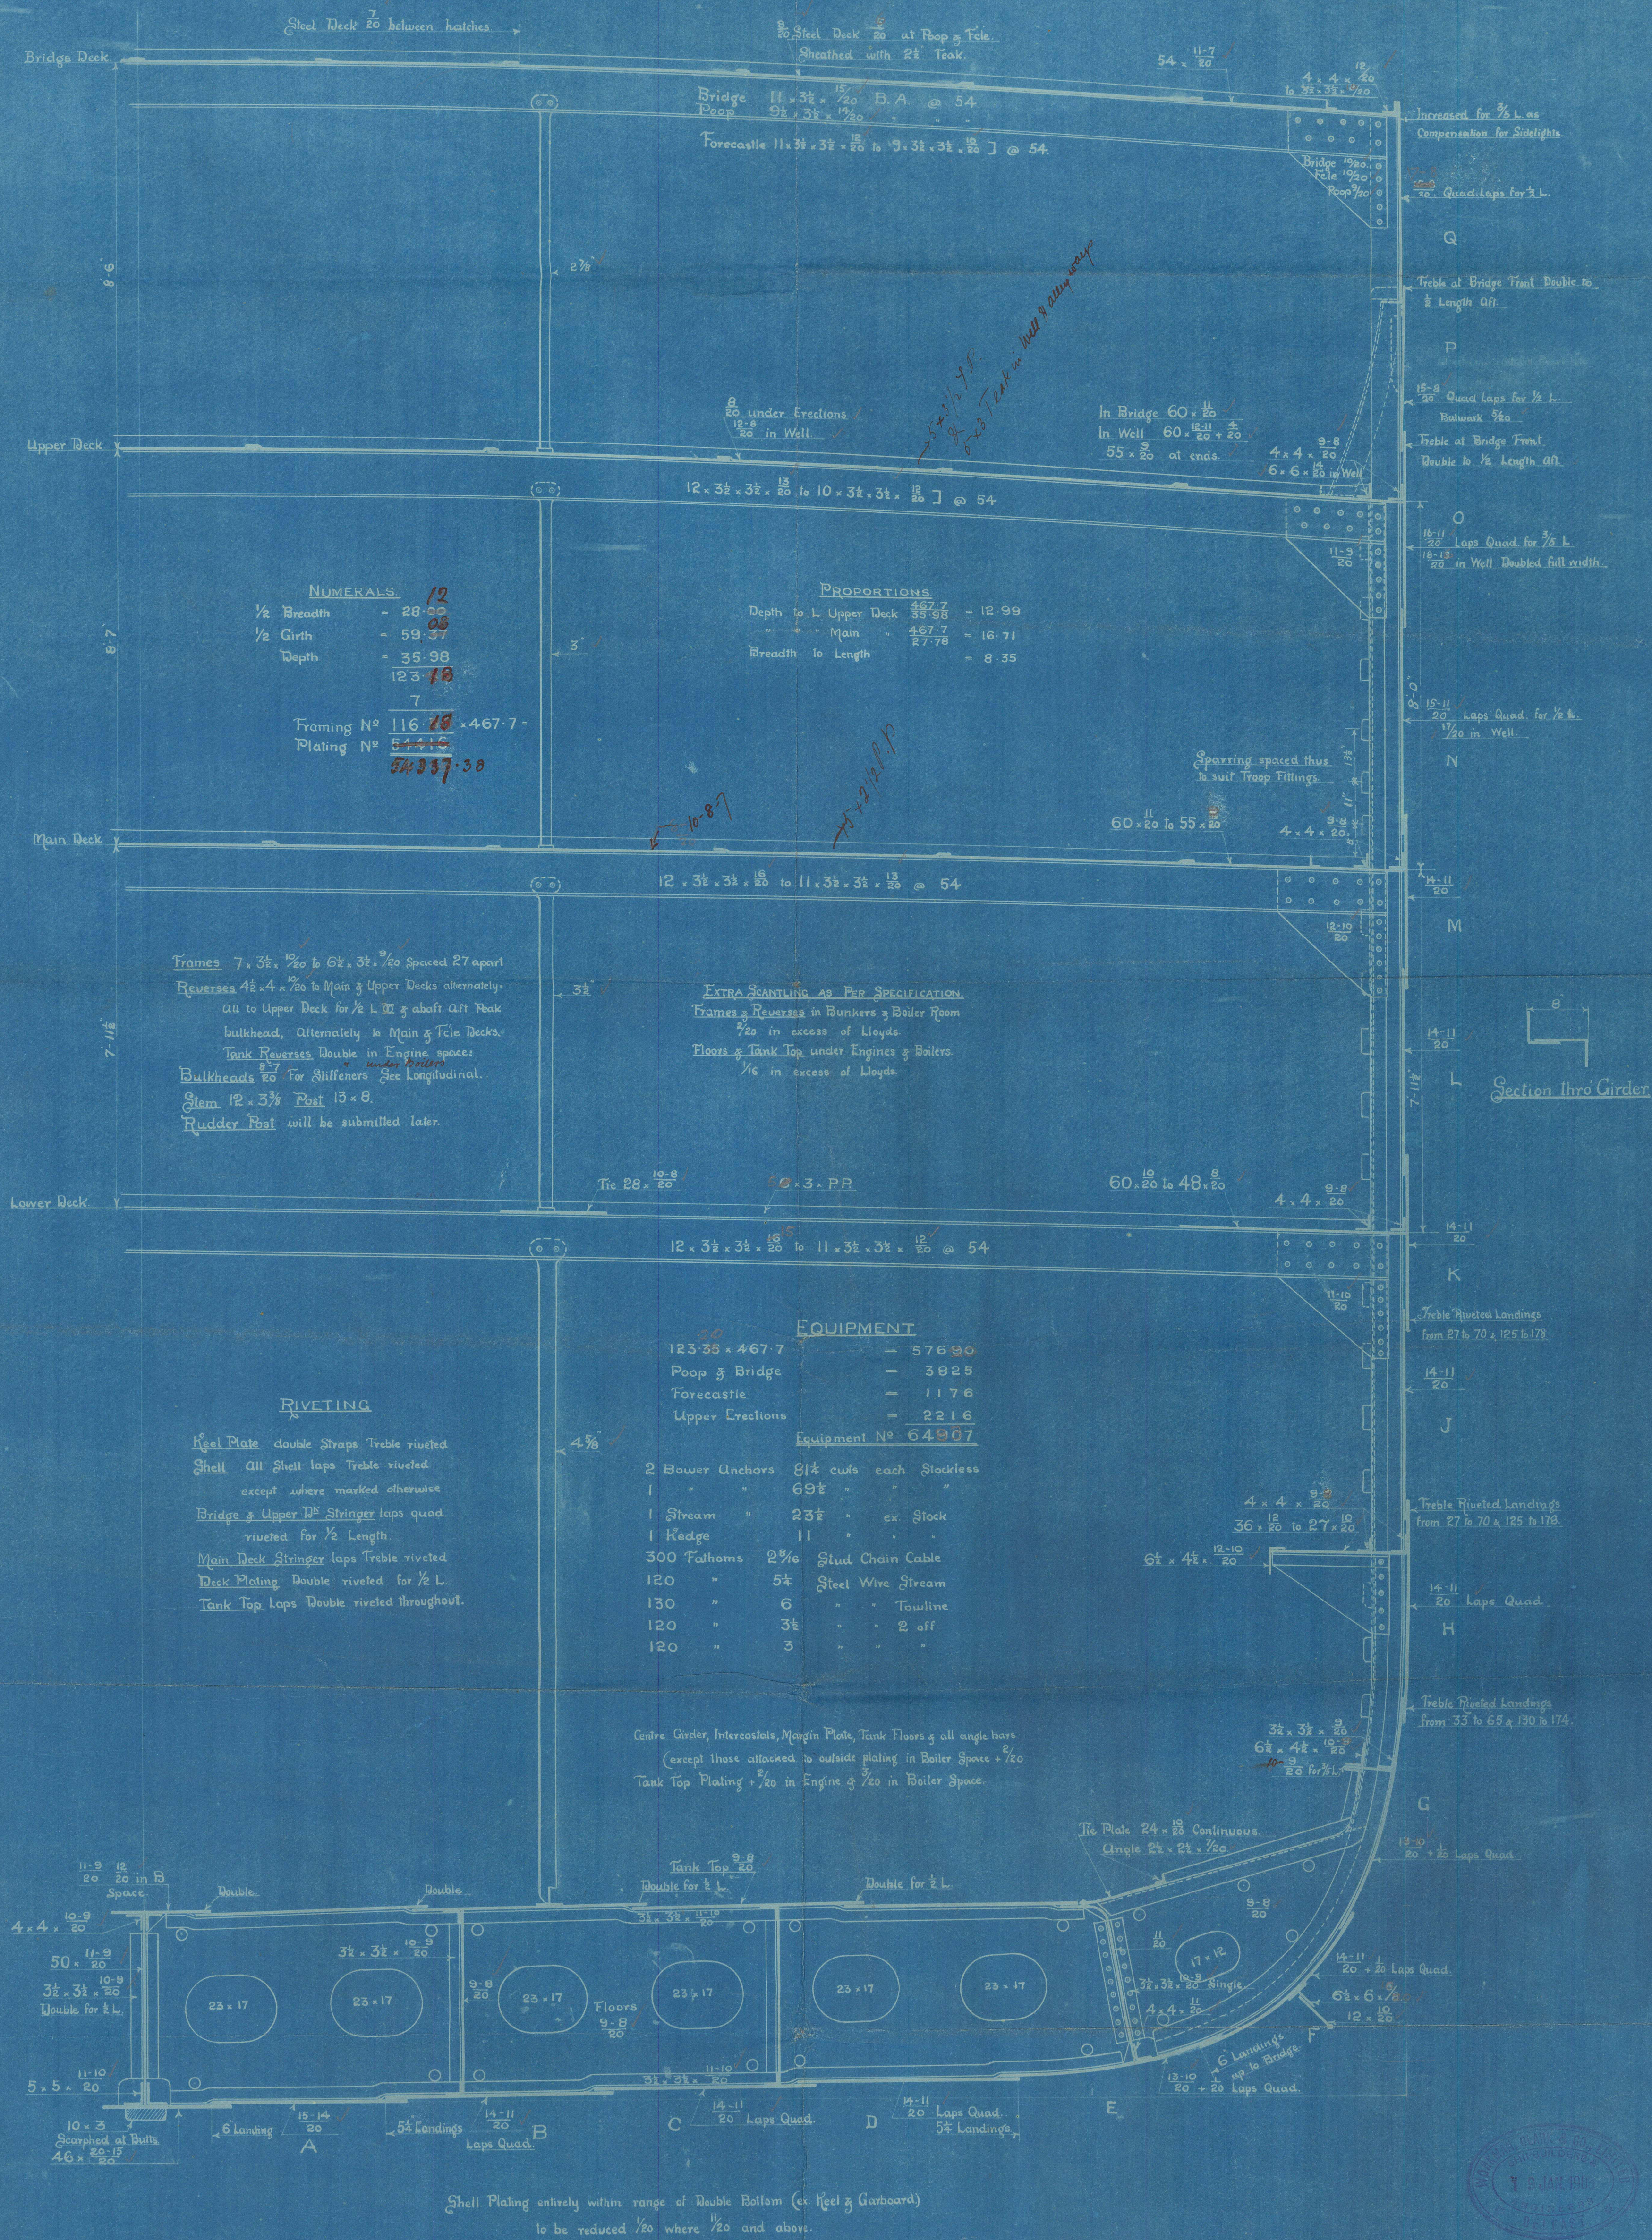


Messrs Workman Clark & Co

T.S.S. 218

Midship Section as
being built

Ref 5963

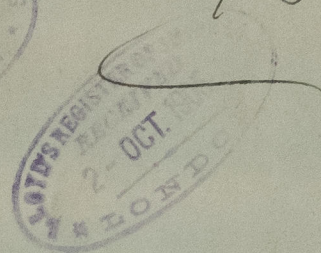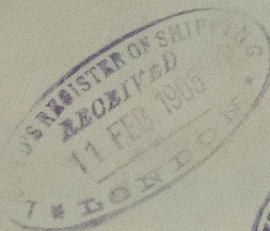

RETAIN



© 2021

Lloyd's Register
Foundation

W1426-0017

Midship Mr. J. J. J.



© 2021

Lloyd's Register
Foundation