

-S.S. No 109, 103 & 115.-

# MIDSHIP SECTION.

TO CLASS 100 A 1. LLOYDS.

DIMENSIONS 385' B.P. x 50' x 29' M.L.D. SCALE 1/2" = 1'-0". ORIGINAL DIMENSIONS 370' x 50' x 29'.

## NUMERALS.

### NUMERALS FOR 385' STEAMER

B+D = 79  
L x (B+D) = 30415  
L.D. IN WAY OF BRIDGE = 10.54  
L.D. " " UPPER DECK = 13.27  
d = 17.5


### NUMERALS FOR 370' STEAMER (ORIGINAL)

B+D = 79  
L x (B+D) = 28230  
L.D. IN WAY OF BRIDGE = 10.1  
L.D. " " UPPER DECK = 12.7  
d = 17.5



### EQUIPMENT FOR 385' STEAMER

POOP 36' x 7'-6" x 3/4" = 202.5  
FORECASTLE 41' x 7'-6" x 3/4" = 230.5  
BRIDGE 27' x 24'-6" x 7'-6" x 3/4" = 1363.5  
CASING 60' x 55'-3" x 7'-6" x 1/2" = 207  
DECK HOUSE 23'-4 1/2" x 7'-6" x 1/2" = 88  
EQUIPMENT NUMBER = 32500.3

3 BOWER ANCHORS STOCKLESS.  
170% C.W.T. COLL. WEIGHT  
1 STREAM ANCHOR 16 1/4 C.W.T. EXCL. STOCK  
1 KEDGE ANCHOR 7 C.W.T. EXCL. STOCK  
270 FATHOMS 2 1/2" STUD CHAIN CABLE  
90 " 4 3/4" STEEL WIRE  
120 " 4 3/4" " "  
2 HAWSEERS 8' x 90 FATHOMS EACH  
2 " 7' x 90 " "

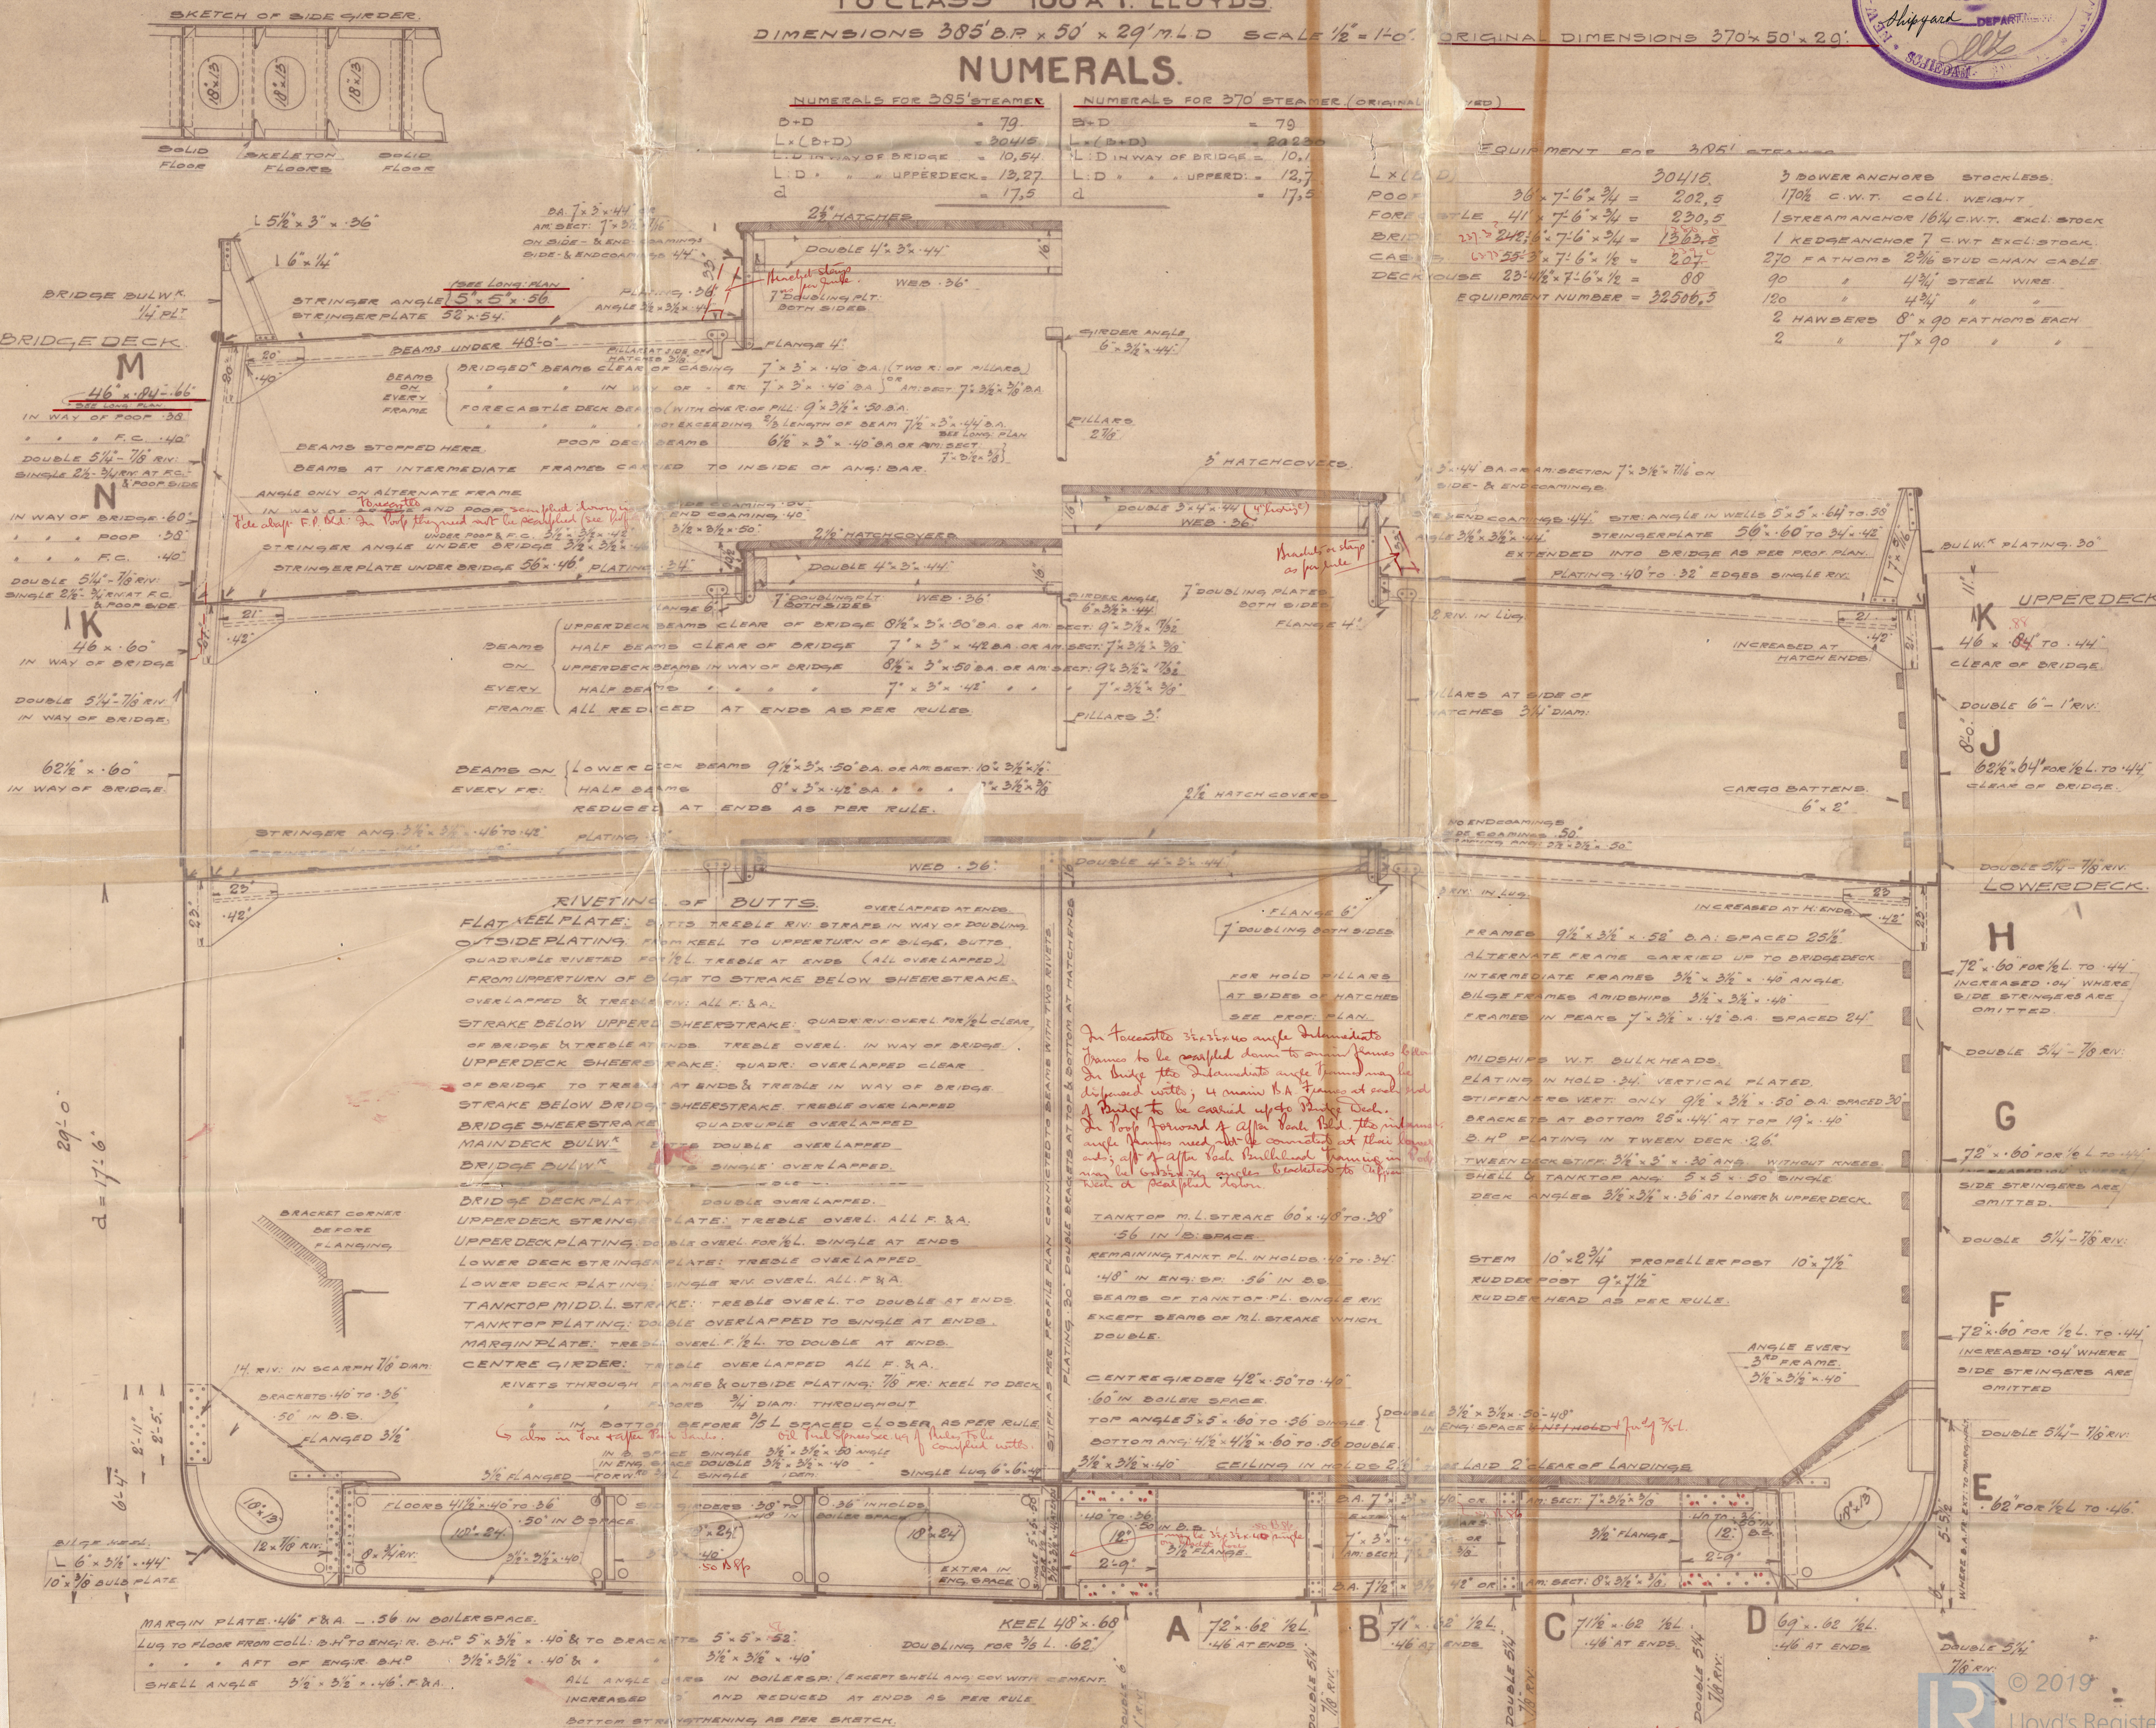

- SCALE 1/2" = 1'-0" -

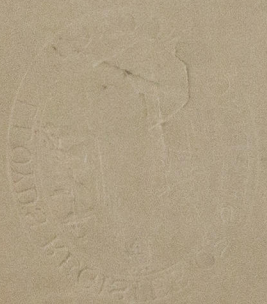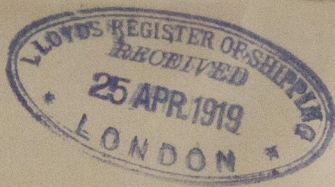

© 2019

Lloyd's Register  
Foundation

S/S "Alchiba"

Midship Section

Rotterdam

Report No. 11394

S/S. Frangenberg

Rotterdam report No. 11673

Yard No. 103. New Water

Subcontracted built  
at Rohith Yard No. 187

see also

Special plan

© 2019  
Lloyd's Register  
9/10-19

W143-0012

Lloyd's Register  
Foundation