
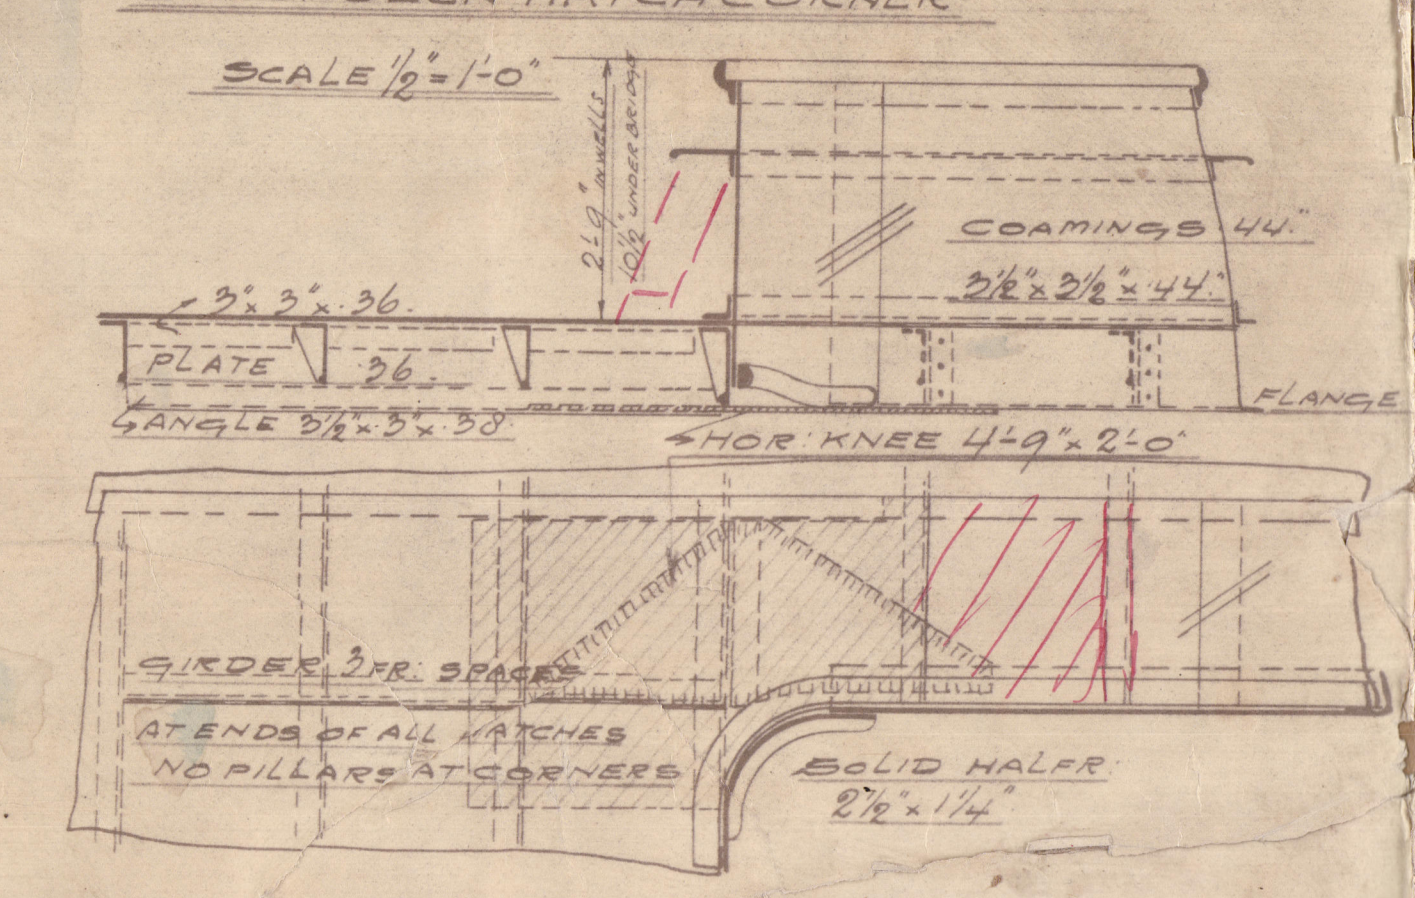






13.5.19

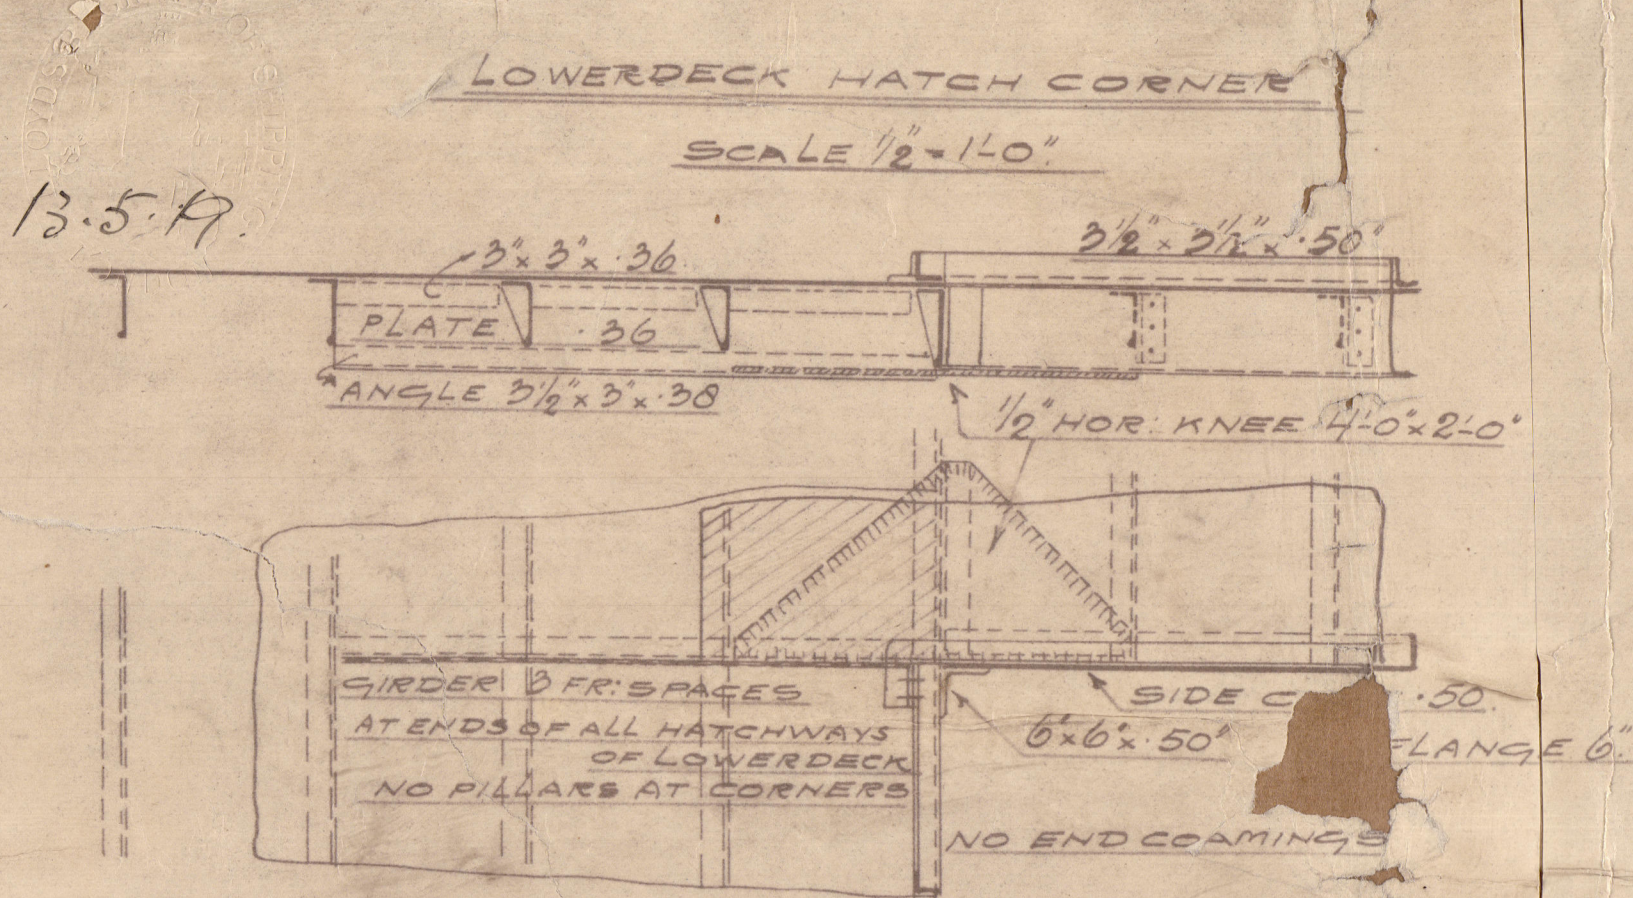

—S.S. No 109, 103 & 115.—
— LONGITUDINAL & DECKPLANS.—
—SCALE $\frac{1}{8}'' = 1'-0''$ —

TO CLASS 100 A 1 LLOYDS. FITTED FOR
DIMENSIONS 385'BP x 50' x 29'. OIL FUEL
F.P. ABOVE 130°.

ORIGINAL DIMENSIONS 370'-D.P. x 50' x 29'

 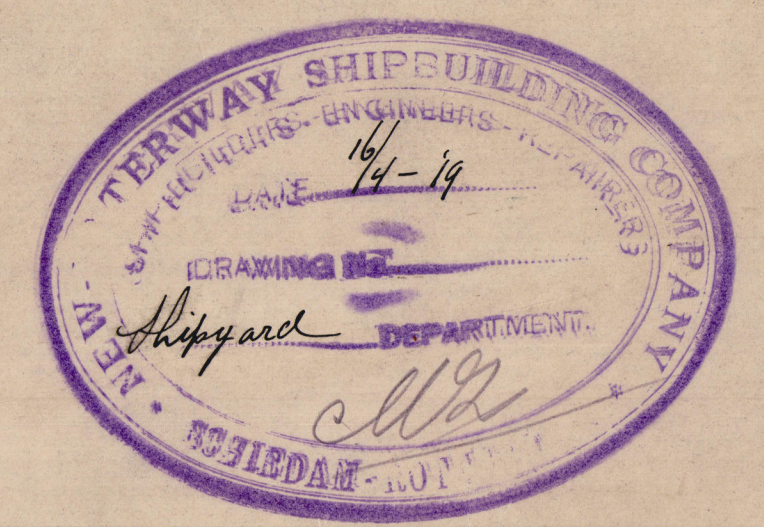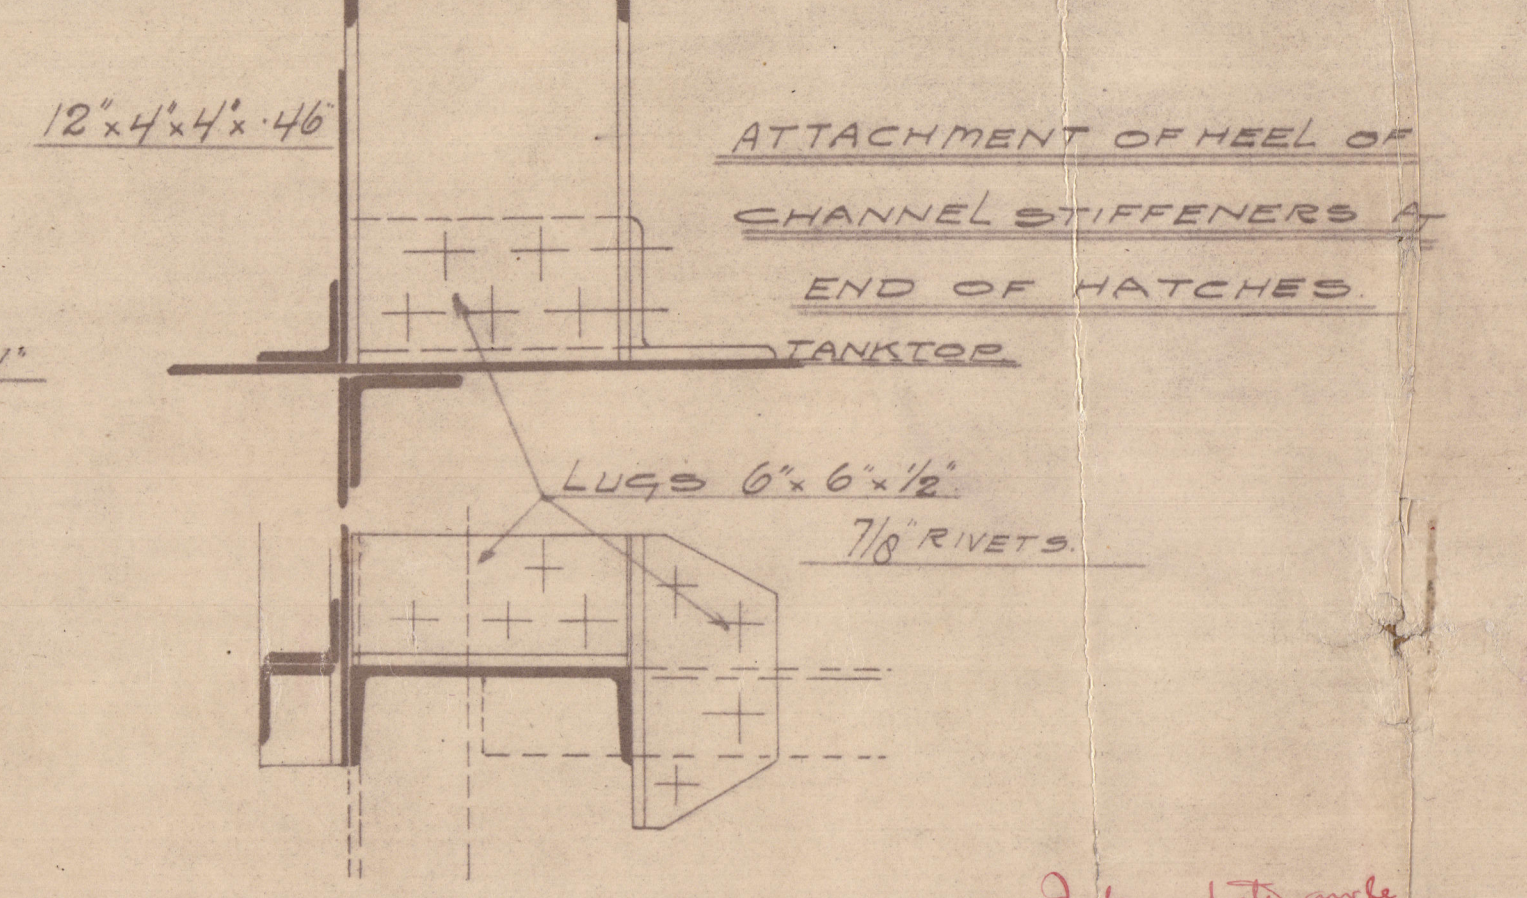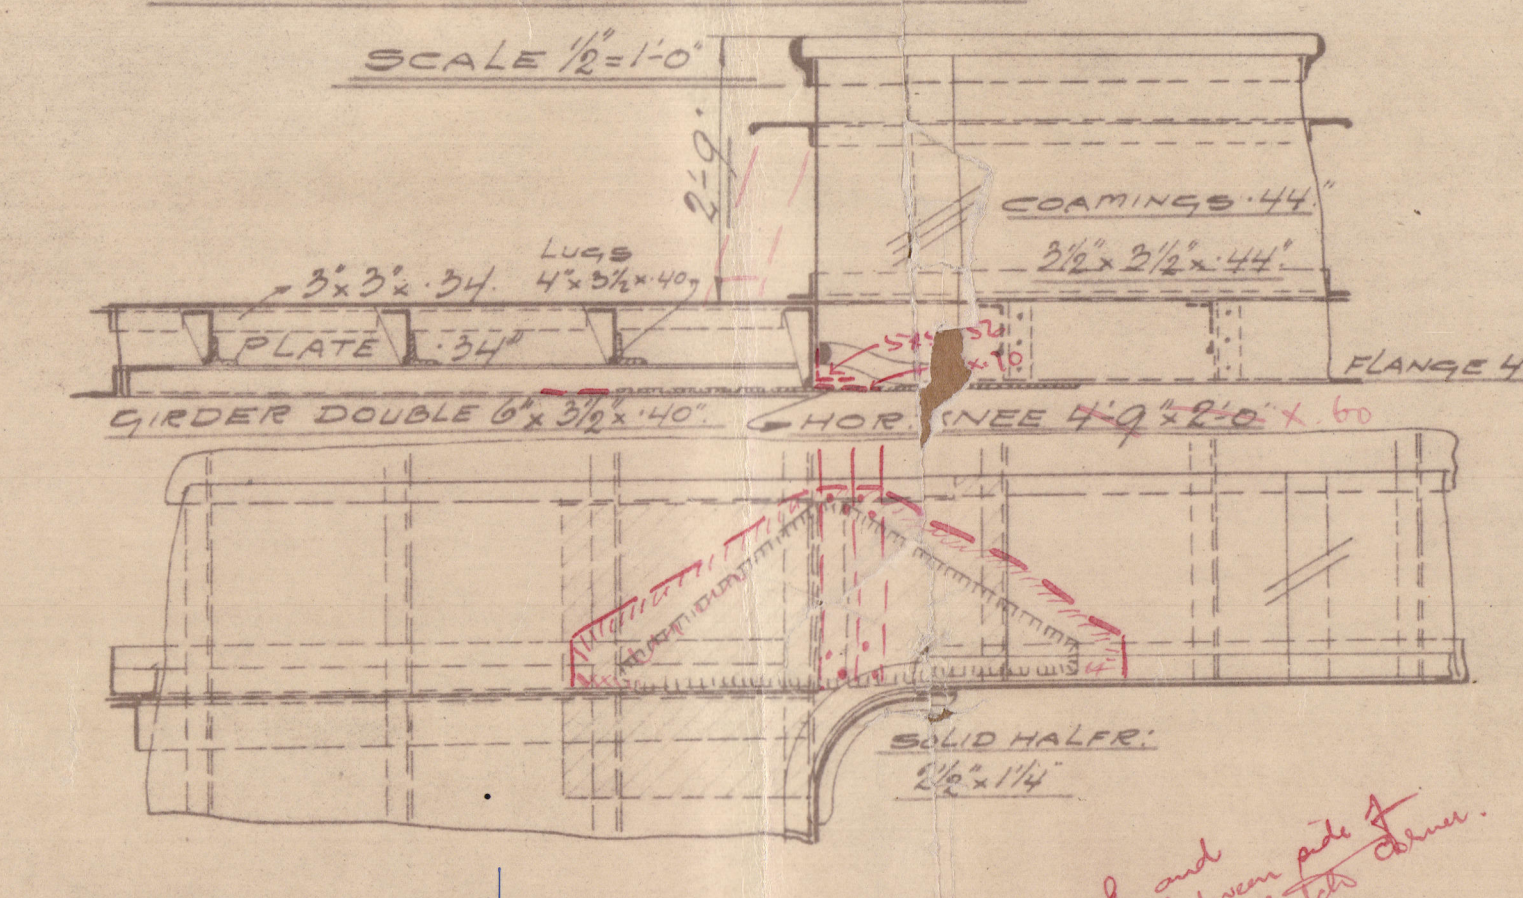

ALTERNATIVE FRAMES CARRIED UP TO POOP- & BRIDGE DECK INTERMEDIATE FRAMES $3\frac{1}{2}'' \times 3\frac{1}{2}'' \times 40'$ ANGLE. (see note on packaging bottom)

PEAK TANKS AND DOUBLE BOTTOM NOT ARRANGED FOR LIQUID FUEL IN S.S. 103 & 115

BRIDGE DECK

NB: ALL WEBPLATES INSIDE HATCHWAYS 16'x36" WITH DOUBLE ANGLES 4"x3"x44"

Profile + DKS

SS. 'Alchiba'.

Rot. rept. No. 11394.

SS. 'Franzberg'.

Rot. rept. No. 11673

(See correspondence
attached to F.E. report.)

W143-0013



© 2019

Lloyd's Register
Foundation