

N<sup>o</sup> 30.

# MIDSHIP SECTION.

SCALE  $\frac{1}{4}'' = 1 \text{ FOOT}$

Dim<sup>s</sup> 458'-6" B.P. x 59'-9" x 24'-5" MLD to Upper D<sup>e</sup>

Course 100 A.1. "Carrying Petroleum in Bulk" Longitudinal Framing

Note: - All sections are N.B.S. except where marked O.B.S.

Lloyds Numerals

L x D 157  $\frac{80}{15}$

L x (B+D) 431  $\frac{15}{15}$

L x B 13-32

d 22-417

2 Transverses in Lanks 2-10 spaced 9'-7", 7'-7", 9'-7"

1 " " " N.B. (no special submission)

Transverse framing for 7' aft

of Oil Tanks

Equipment Numerals

L x (B+D) 431  $\frac{15}{15}$

Port 94 375' x 75' x 75' 30.60

Bridge 31.5' x 75' x 75' 77.20

Yoke 38.5' x 75' x 75' 16.60

Coaming 74.5' x 75' x 5' 279.37

House 27.5' x 75' x 5' 113.12

444  $\frac{81}{81}$

Equipment

2 Bowse Anchors (stockless) each 77 cwt. Coll. wt.

1 " " (stockless) 65  $\frac{1}{2}$  " 217  $\frac{1}{2}$  cwt.

1 Stream Anchor 22 cwt. ex stock

300 Fathoms 2  $\frac{1}{2}$  Stud Chain Cable

120 " 5 Stud Wire (stream)

130 " 5  $\frac{1}{2}$  " " (stream)

100 " (2  $\frac{1}{2}$ ) 2  $\frac{3}{4}$  " " (stream)

100 " (2 off) 2  $\frac{3}{4}$  " " (stream)

Item 10  $\frac{1}{2}$  x 2  $\frac{1}{2}$

Knitter 5  $\frac{1}{2}$  x 8  $\frac{1}{2}$

Stow 10  $\frac{1}{2}$  x 8  $\frac{1}{2}$

Riveting

Shell Longs 1-4 rivs thro' shell 6 dia apart

" 5-8 " " 6 " " "

4  $\frac{1}{2}$  dia for 10 rivs each side Bld, 8  $\frac{1}{2}$  dia for 10 rivs each side Trans.

Longs 8-22, 6 dia 3  $\frac{1}{2}$  dia for 10 rivs each side

Bld x 8+10 rivs each side Trans.

Longs in N<sup>o</sup> 1 Lank on flat of Bottom, 4  $\frac{1}{2}$  dia thro' out

E Bld " 1-4, 6 dia.

" " 5-8, 6 " " 4  $\frac{1}{2}$  for 10 rivs each side Bld x 8+10 on

opposite ends side Trans.

" " 7-11, 6 dia + 3  $\frac{1}{2}$  for 10 rivs each side Bld x 8+10 on

opposite ends side Trans.


Seams of shell as per Section 15 cl. 16

7 rivs through Transverse

APPROVED

LLOYDS REGISTER OF SHIPPING

DATE 155-11300

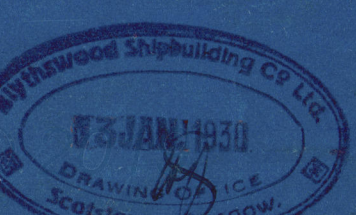

011-3-0022



MIDSHIP SECTION  
Nº 30



© 2019

Lloyd's Register  
Foundation



W143 - 0022

Blythswood S.B. Co.Ltd.

No. 30.

Midship Section.

=====

*T. bat*

GLASGOW REPORT No. 51012

*"Adellen"*

GLASGOW REPORT No. 51038



© 2019

Lloyd's Register  
Foundation