


2.11.37

1/2 No 279.

PROFILE & DECK PLAN.

SCALE 1/8" = 1 FOOT.

CLASS 100A1 WITH FREEBOARD
HULL IN CENTRE OF HATCH END
DIMENSIONS: 410-0 BP x 56-3 1/2 BATH MID x 36-8 7/16 UPPER DECK
CORRESPONDING TO A DRAFT NOT EXCEEDING THAT
CONTEMPLATED BY THE RULES FOR A COMPLETE
SUPERSTRUCTURE SHIP HAVING A TONNAGE OPENING.

 

SUNDERLAND

Messrs. Bartram & Sons, Ltd.


S.S. 279

PROFILE & DECKS PLAN

4/11/37.



AGIOS GEORGIOS IV.
SUNDERLAND RPT. NO. 32830.

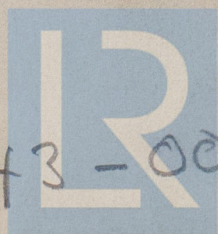

© 2019

W143 - 006 Lloyd's Register
Foundation