


3.7.03
8.7.03
31.7.03

S.S.N^o 174. MIDSHIP SECTION

LENGTH B.P. 314'-0"
BREADTH EXT. 46'-6"
DEPTH MLD. 23'-0 1/2"

— SINGLE D^K. CLASS 100 A.1. —

— SCALE 1/2 INCH = 1 FOOT. —

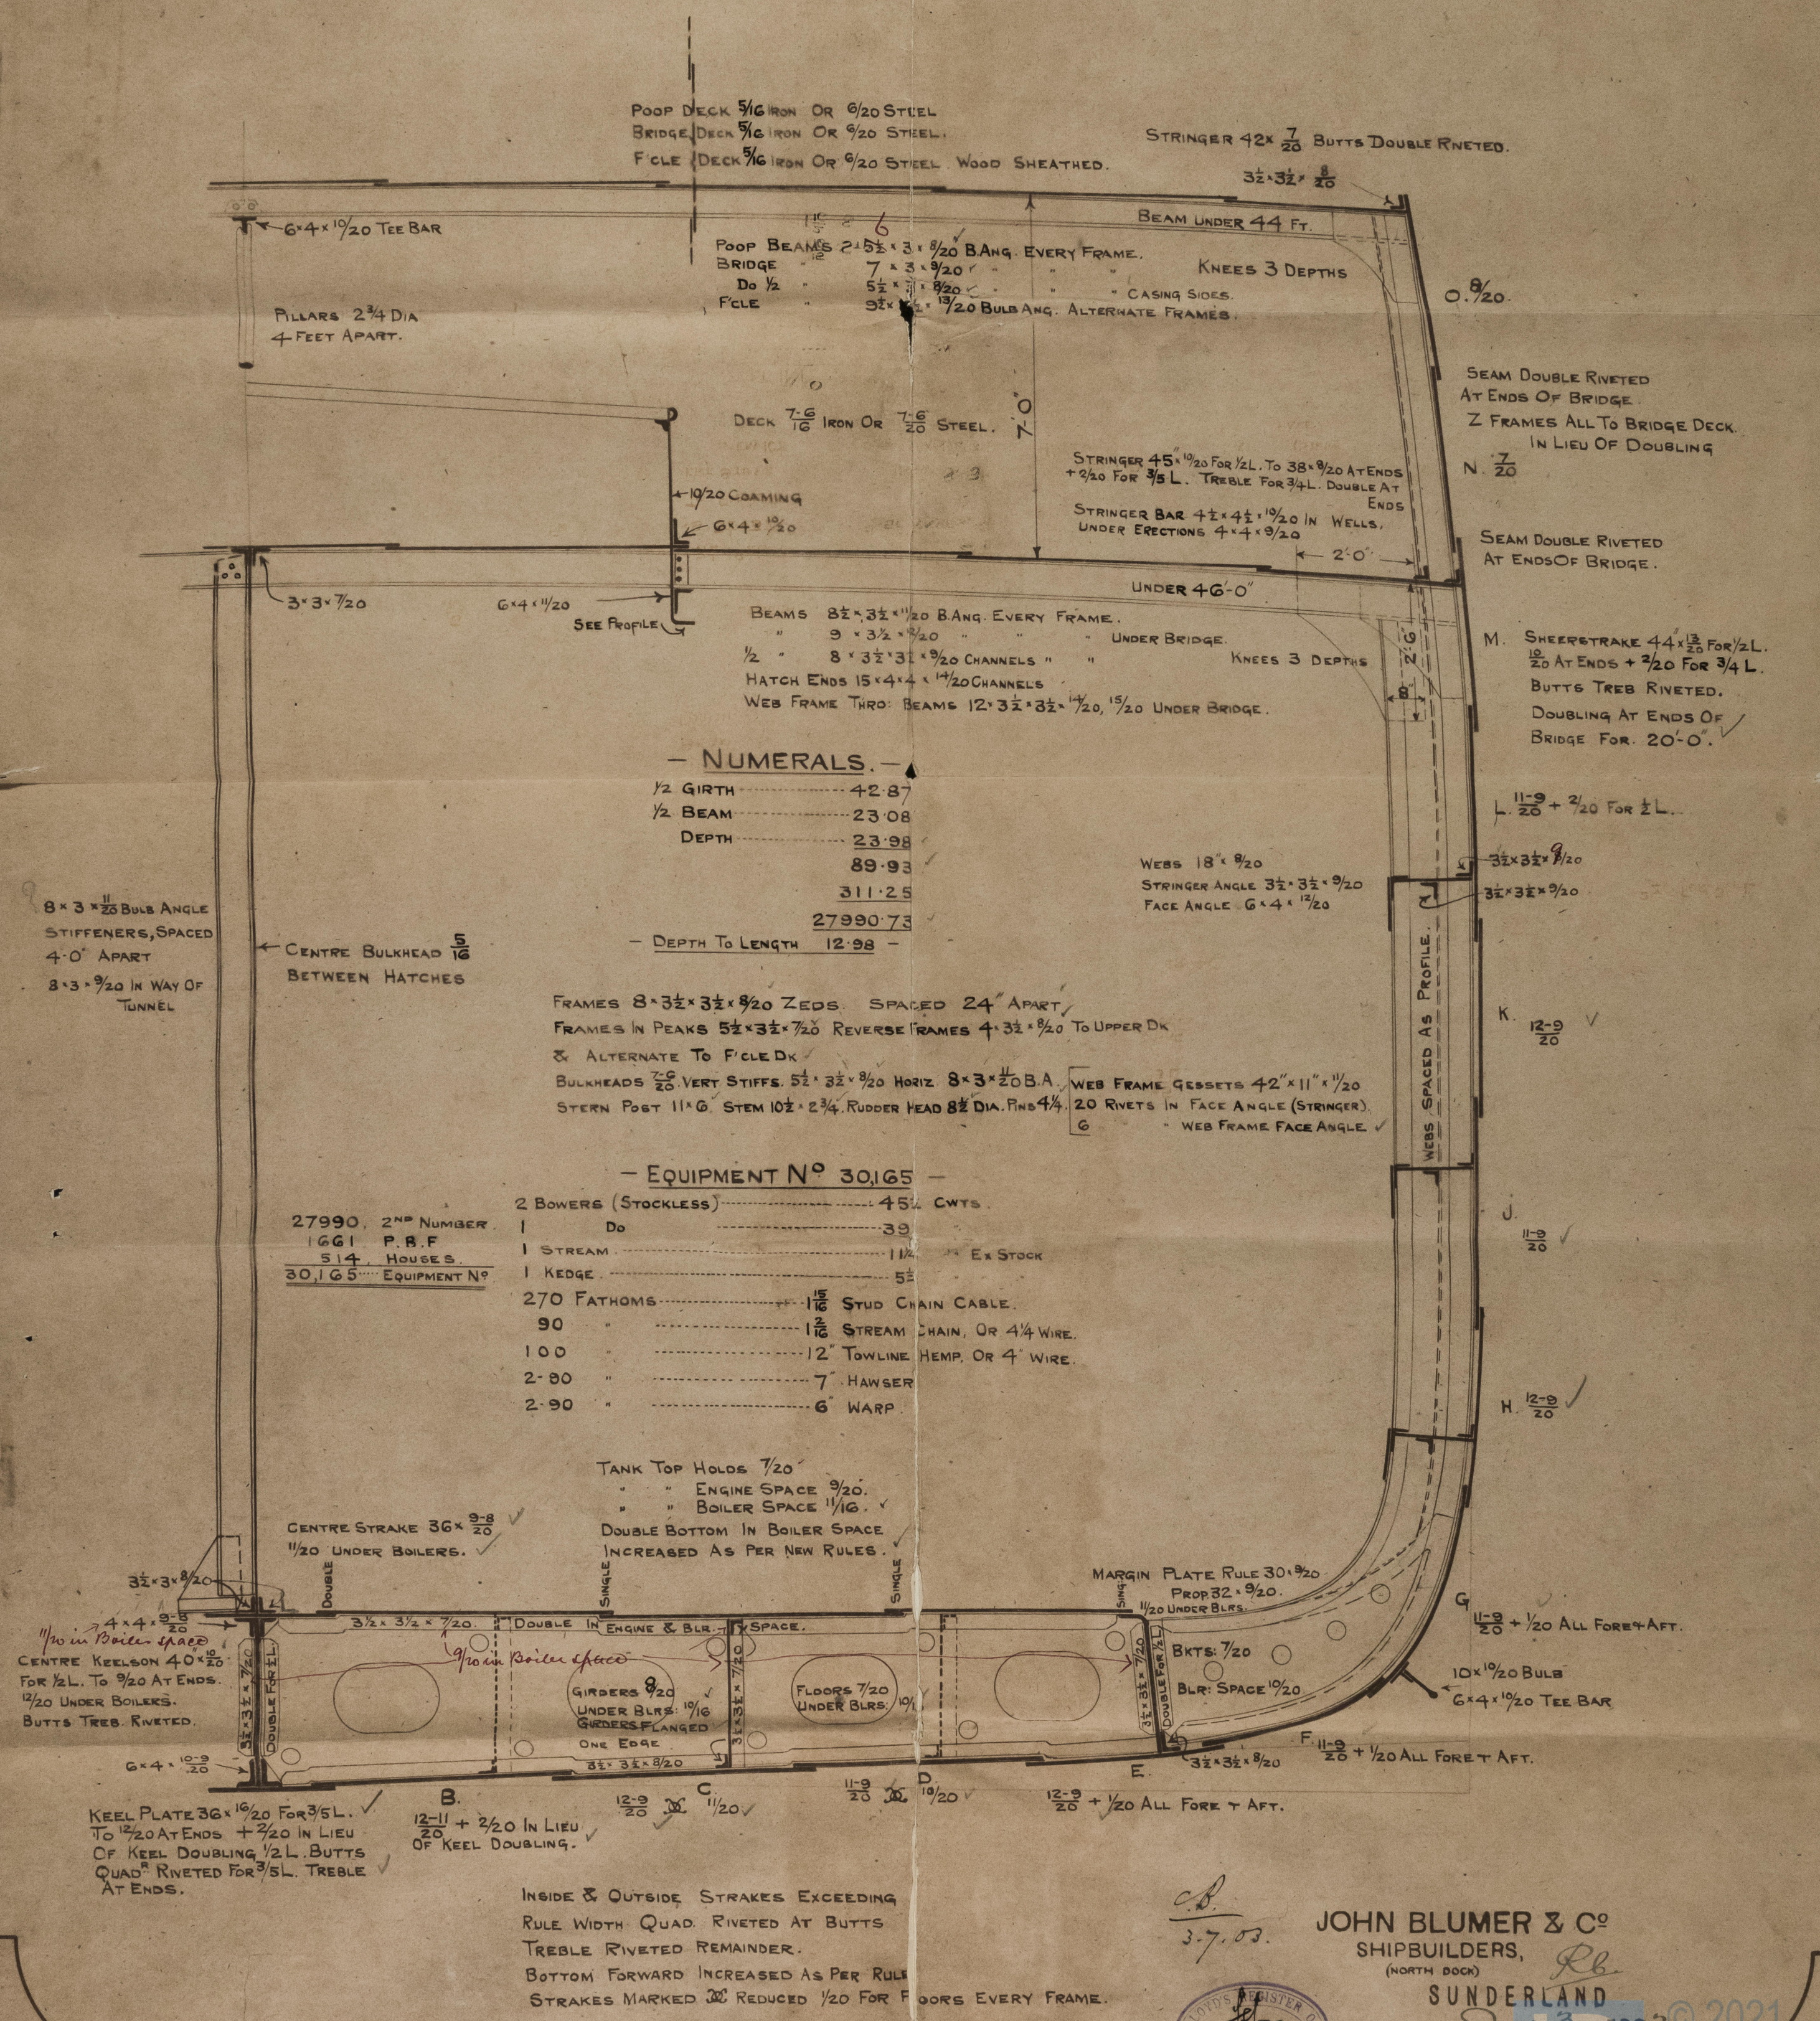



3.7.03.
JOHN BLUMER & CO
SHIPBUILDERS,
(NORTH DOCK)
SUNDERLAND
June 30 1903
Lloyd's Register
Foundation

- AMENDED -
MIDSHIP SECTION -

Messrs J. BLUNTER & Co

S.S. "No. 174"

S.S. "WENTBRIDGE"

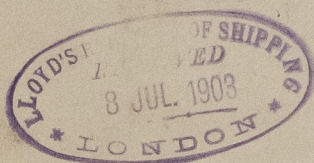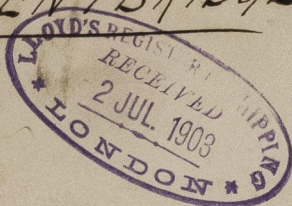

Old flr No 21581



First Entry No. 21608.



© 2021

Lloyd's Register
Foundation

W1431-0143