



25-1-11

N^{os} 143 & 144.

ELEVATION


DIMS: 110'-0" x 21'-6" x 12'-11" MLD.

SCALE 1/4" = 1 FOOT

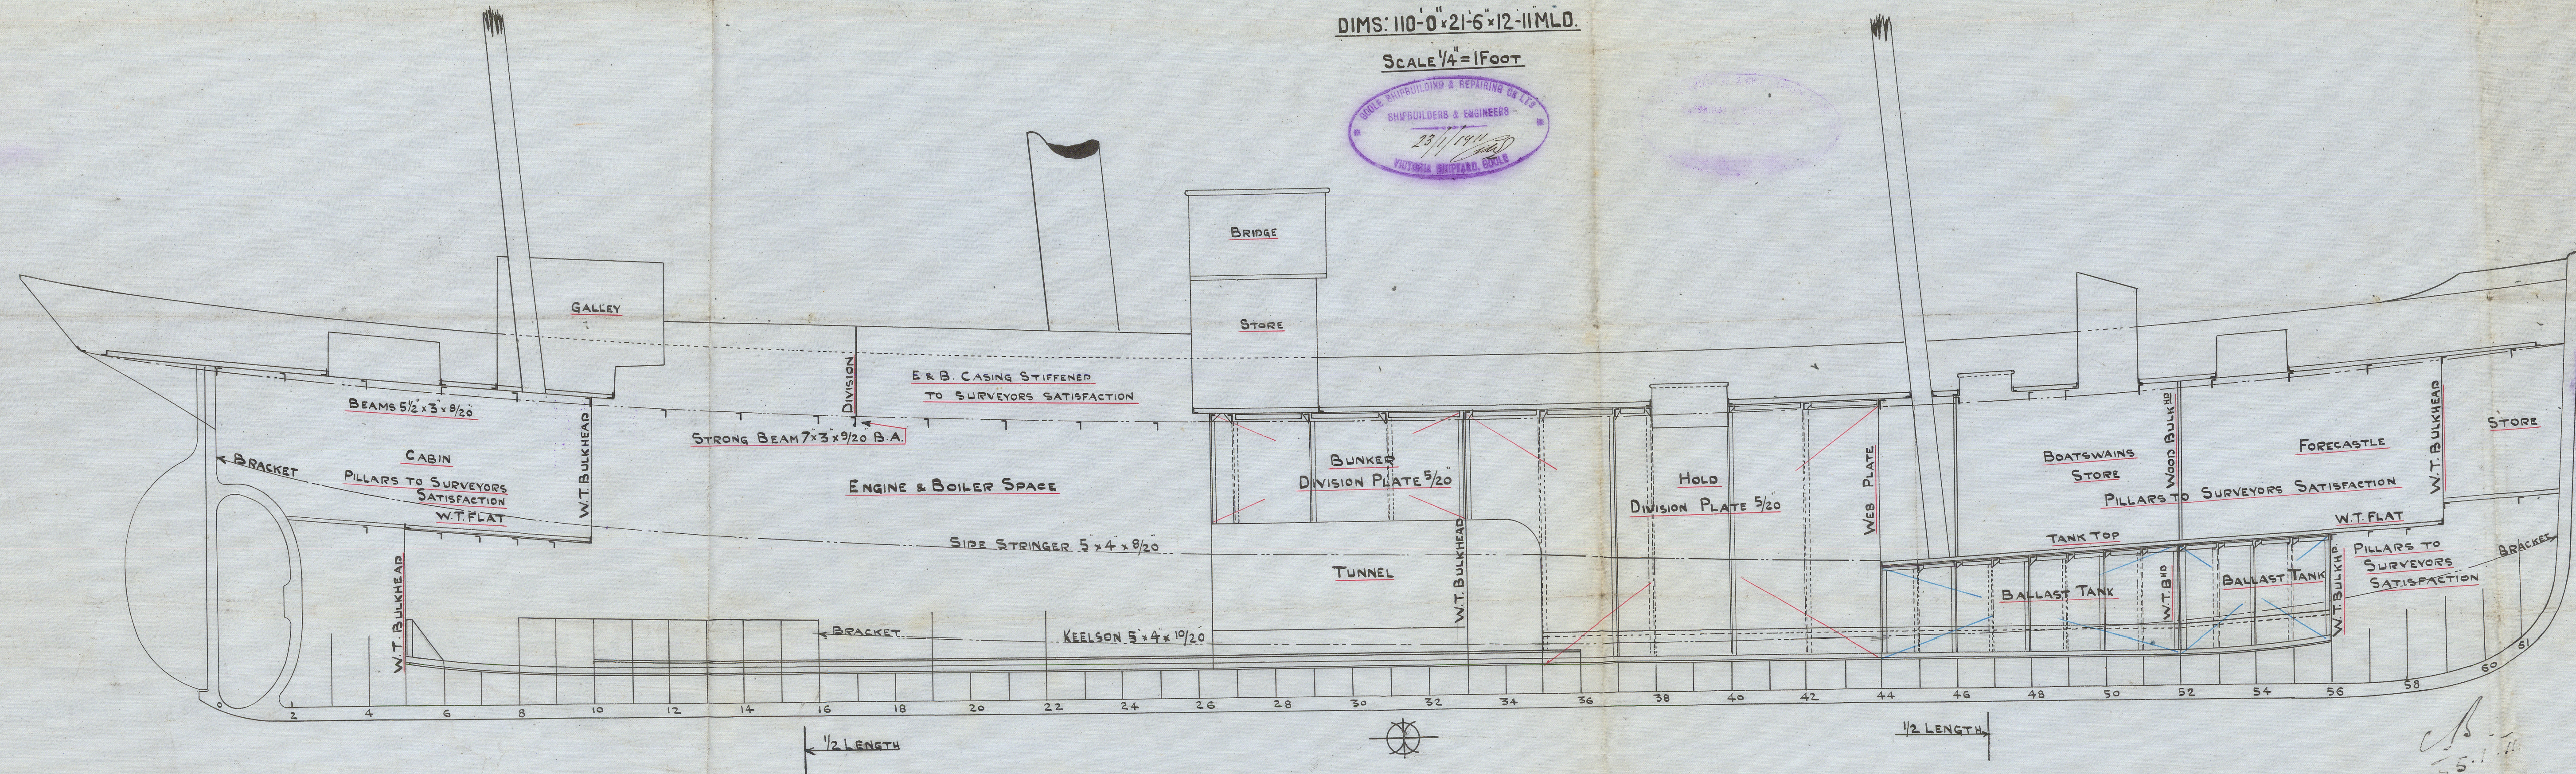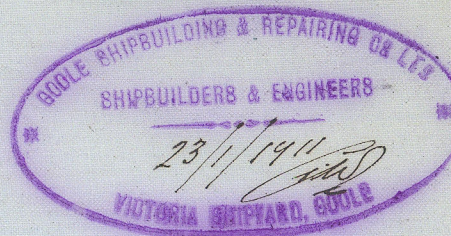

SECTION THROUGH
BALLAST TANK.

SCALE 1/2" = 1 FOOT.

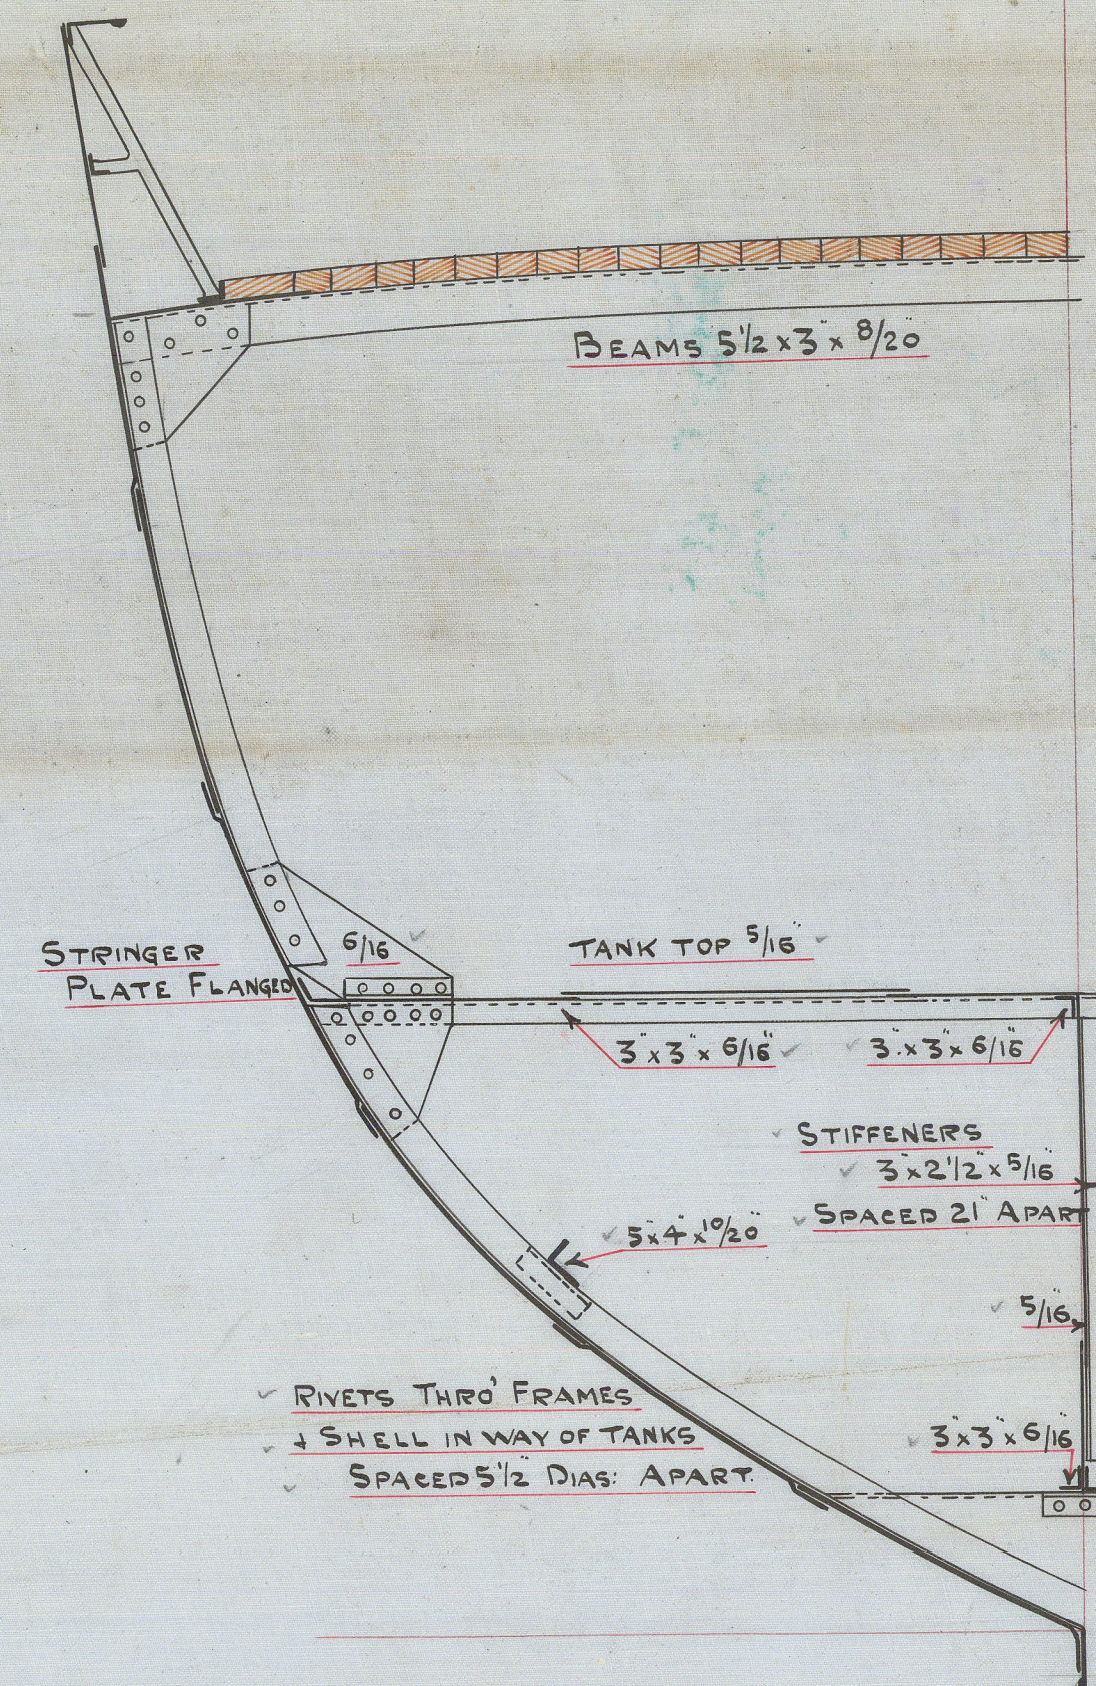

№ 143. 144.

~~Mudchip Section~~
Profile.

3/5 Ouster

3/5 Duster
Hull Rpt No. 23946

2/3 Flicker

1/2 Flicker
1/2 Bull Rpt no. 24352



SECTION THREE

SECTION 1A

© 2021

W1431-0200

W 1431-0200