

N^{os} 143 & 144

NUMERALS

1/2 BREADTH	10.75
DEPTH	13.42
1/2 GIRTH	19.52
1 ST NO:	43.69
LENGTH	108.875
2 ND NO:	4756.748

$$\begin{array}{r} B \quad 21.5 \\ D \quad 12.92 \\ 12^\circ N^\circ \quad \hline 3442 \\ 110 \\ \hline 2^{HO} N^\circ \quad \hline 3786 \end{array}$$

MIDSHIP SECTION

STEEL SCREW FLEETERS


DIMS: 110'-0" x 21'-6" x 12'-11" MLD.

SCALE $\frac{1}{2}" = 1 \text{ FT.}$

TO CLASS 100.A.I. AT LLOYDS.

EQUIPMENT N° 4756

- ✓ 1 ANCHOR 5 CWTs: EX STOCK
- ✓ 1 ANCHOR 4½ CWTs: EX STOCK
- ✓ 1 ANCHOR 2½ CWTs. EX STOCK
- ✓ 90 FATHOMS 1" STUD LINK CABLE
- ✓ 60 FATHOMS 5½ HAWSER
- ✓ 60 FATHOMS 4" WARP

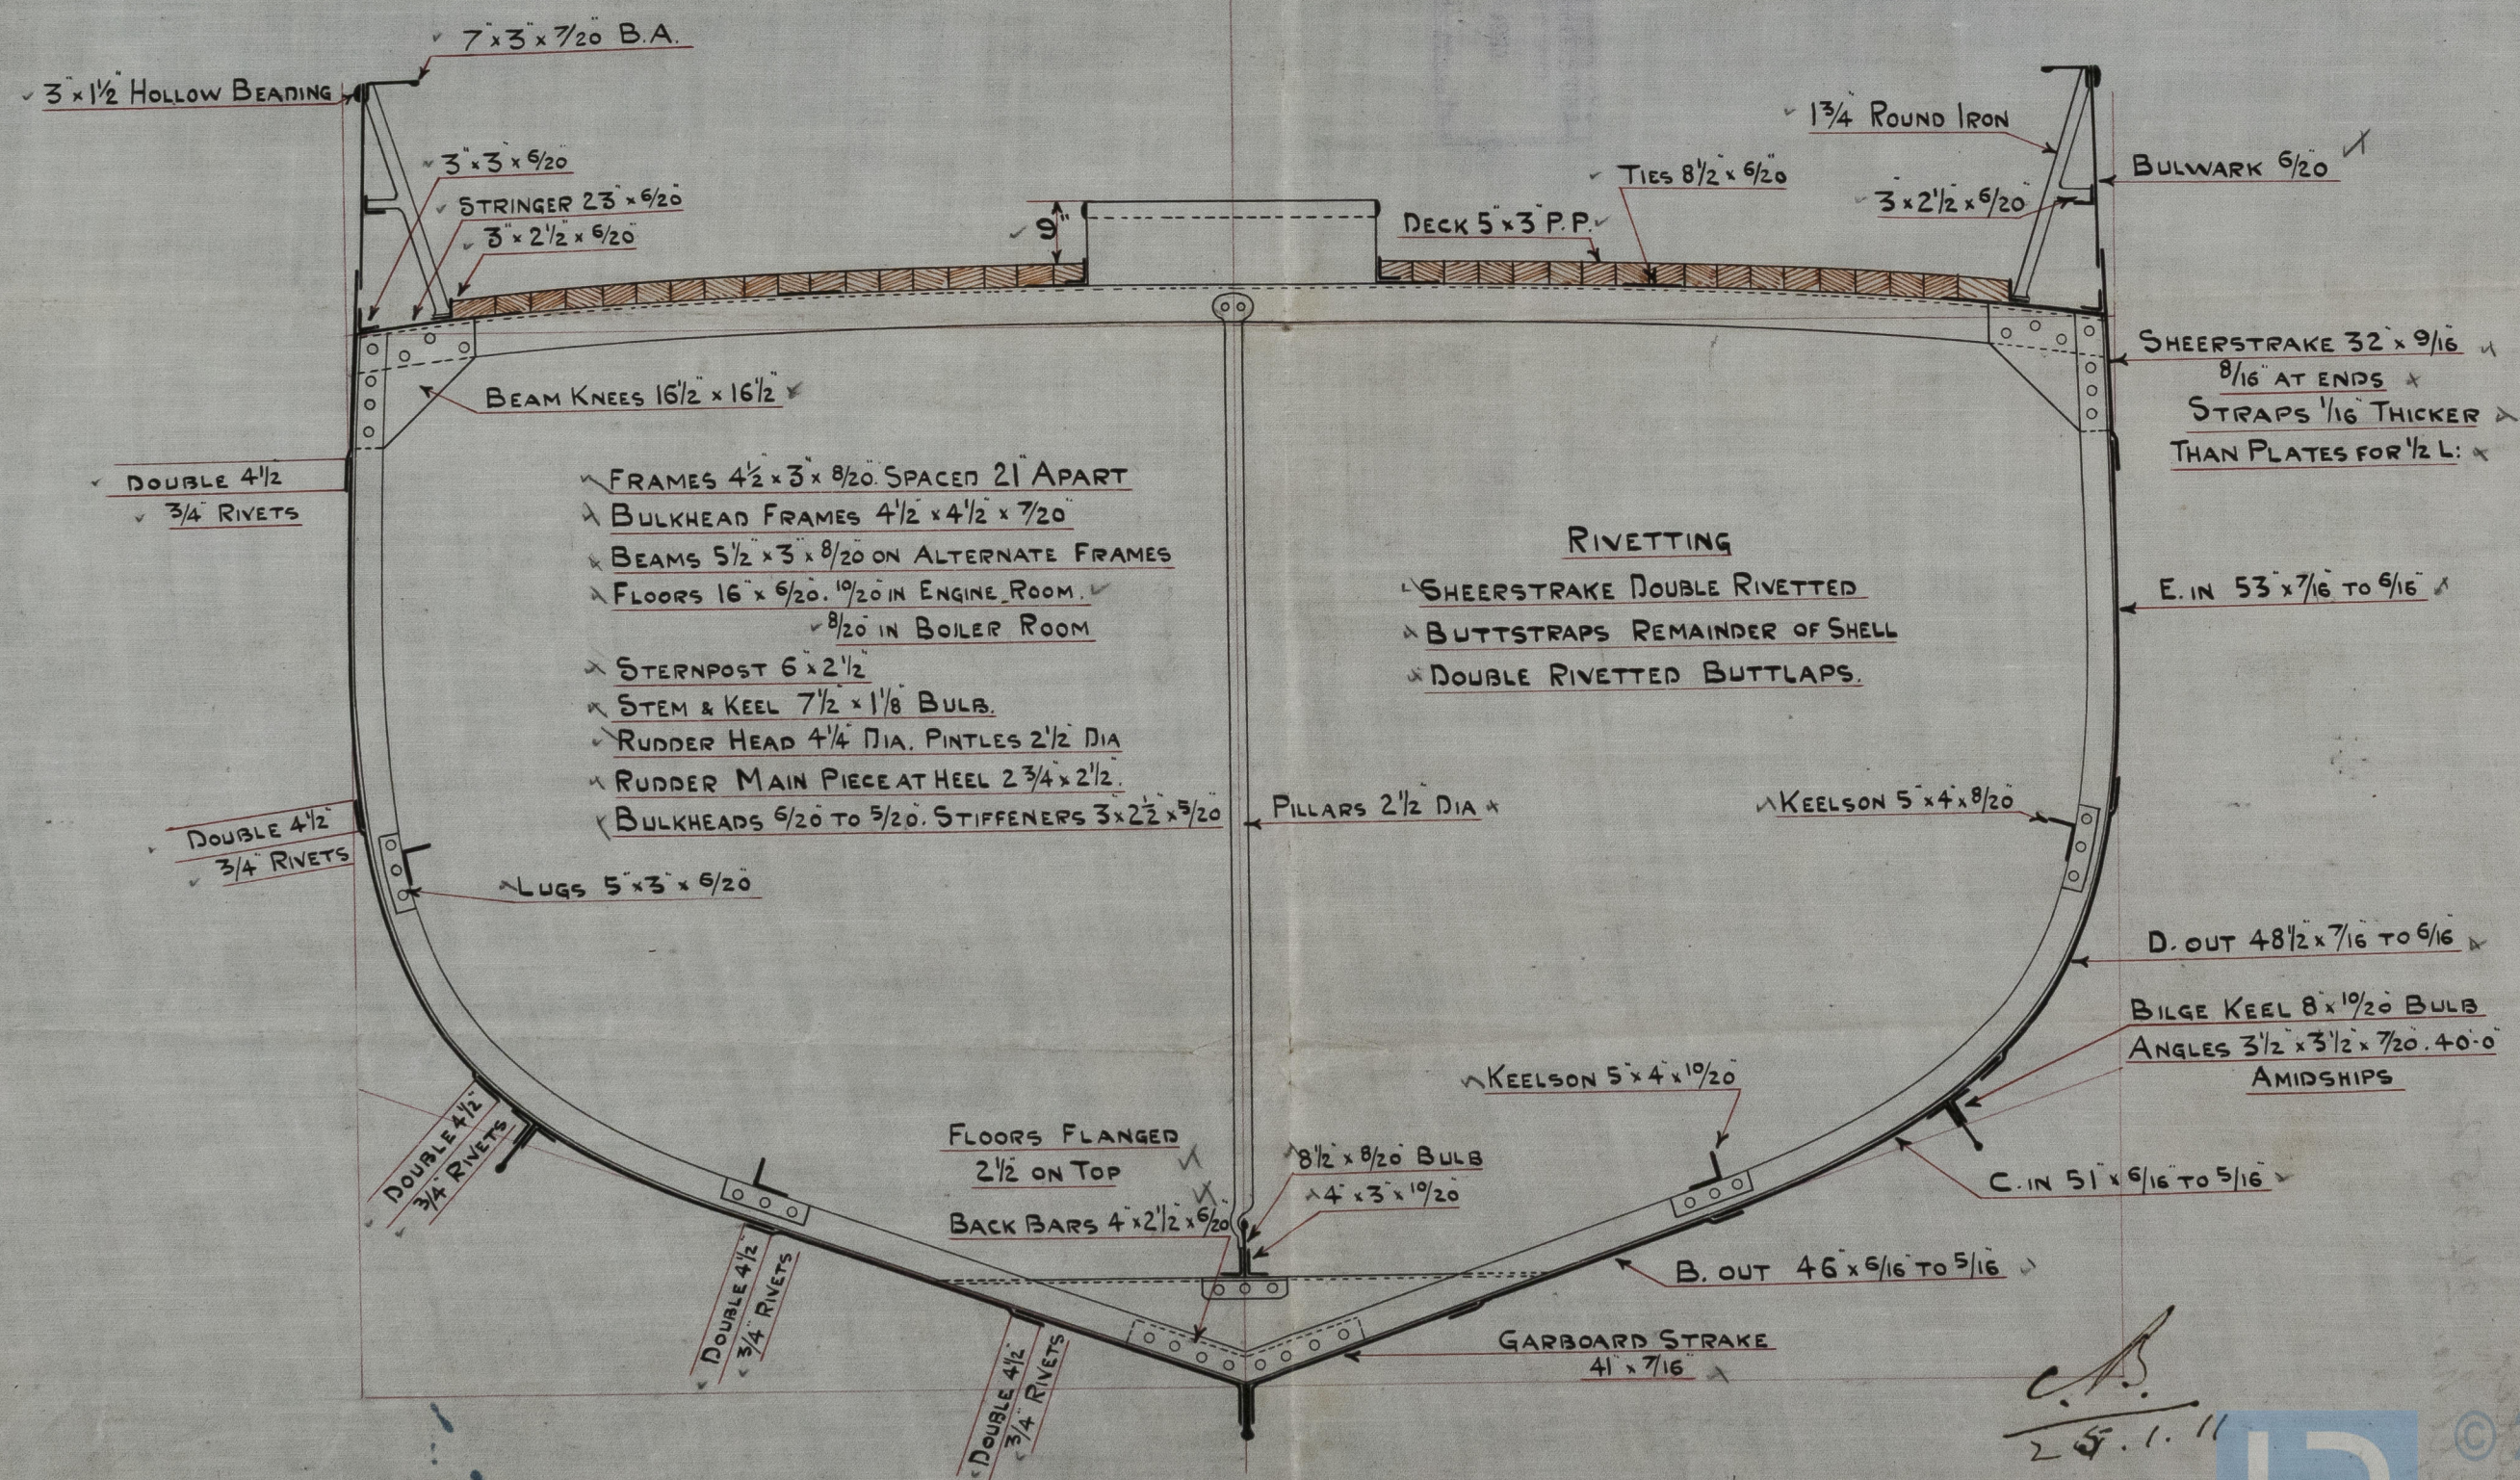

Essex S. & R. C. & L.

No 143-144.

Midship Section.

s/s Duster
Hull Report No. 23946

s/s Flicker
Hull Rpt No. 24352

50.11.2

W1431-0210

REGISTERED
SHIP
HULL

REGISTER
OF SHIPPING
JAN 1911
HULL

RETAI



© 2021
Lloyd's Register
Foundation

W1431-0210