


# MIDSHIP SECTION

S. S N<sup>o</sup> 55

O.A. 60' 0" x 15' 0" x 8' 0" mlo  
57' 6" B.P.

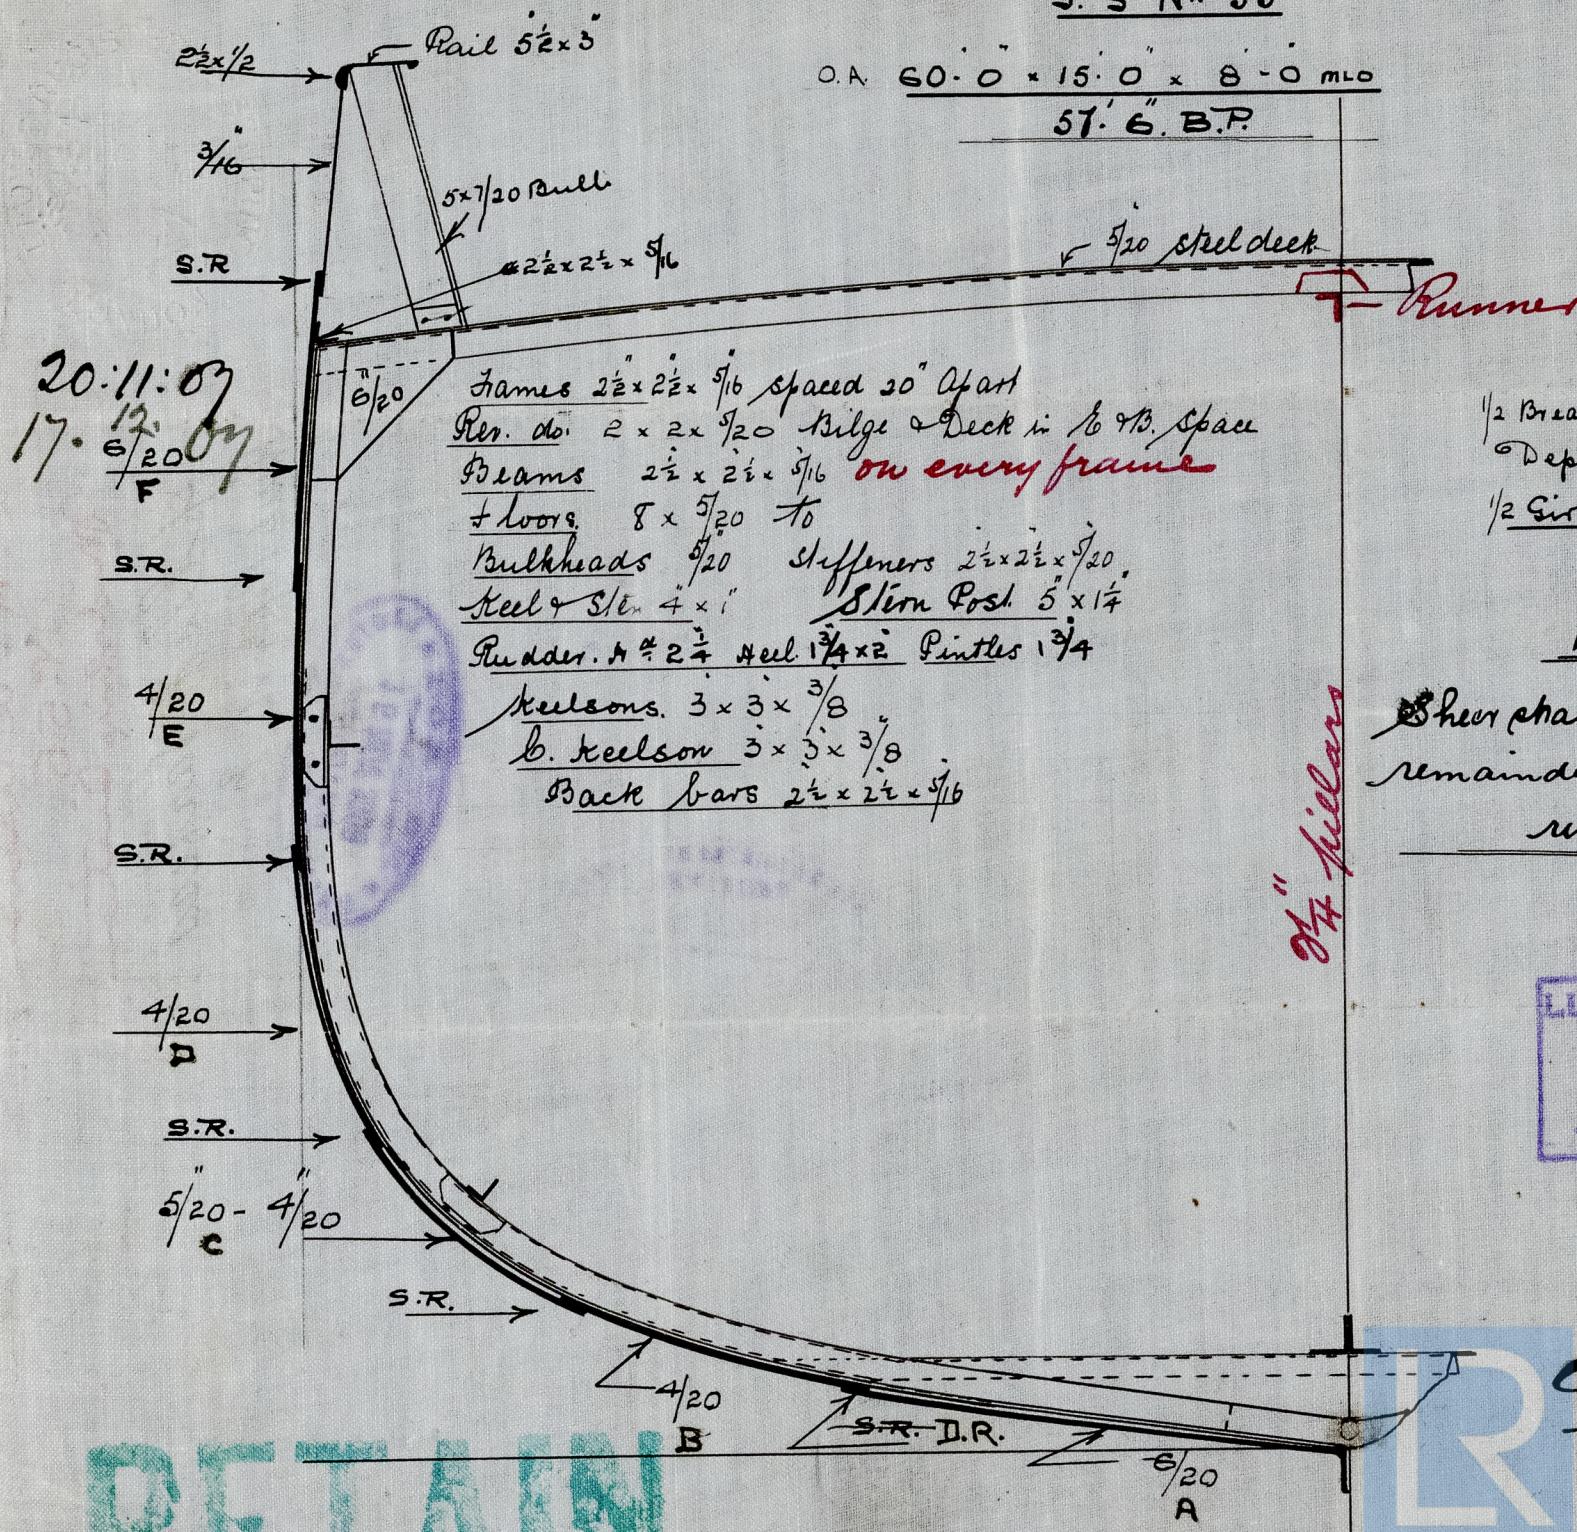

W.H.WARREN

NEW HOLLAND

19.11.07, Lloyd's Register Foundation

W1437-0089

RETAIN

W. H. Warren.

N<sup>o</sup> 55

Midship Section,

Spilda Parkiss

Hull Report No:



© 2021



Lloyd's Register  
Foundation

W1437-0089