

18.1.12
12.2.12
27.2.12
24.6.12

Handwritten notes:
Dunwood I
airford
#028-78

Freeboard Particulars


Length on lead water line	385'0"
Depth 1/4" to upper deck	29'1"
Storage under deck	4300
Sheer forward	108
aft	54
Mean sheer over total length	81
Sheer at 1/4" from stem	59 1/2
" " " stern	29 1/4
Mean sheer at 1/4" L	44 1/8

PROFILE N° 350 S.S.

SCALE 1/8" = ONE FOOT

TO CLASS 100 A1 AT LLOYDS, SHELTERD

Deck plans to be submitted

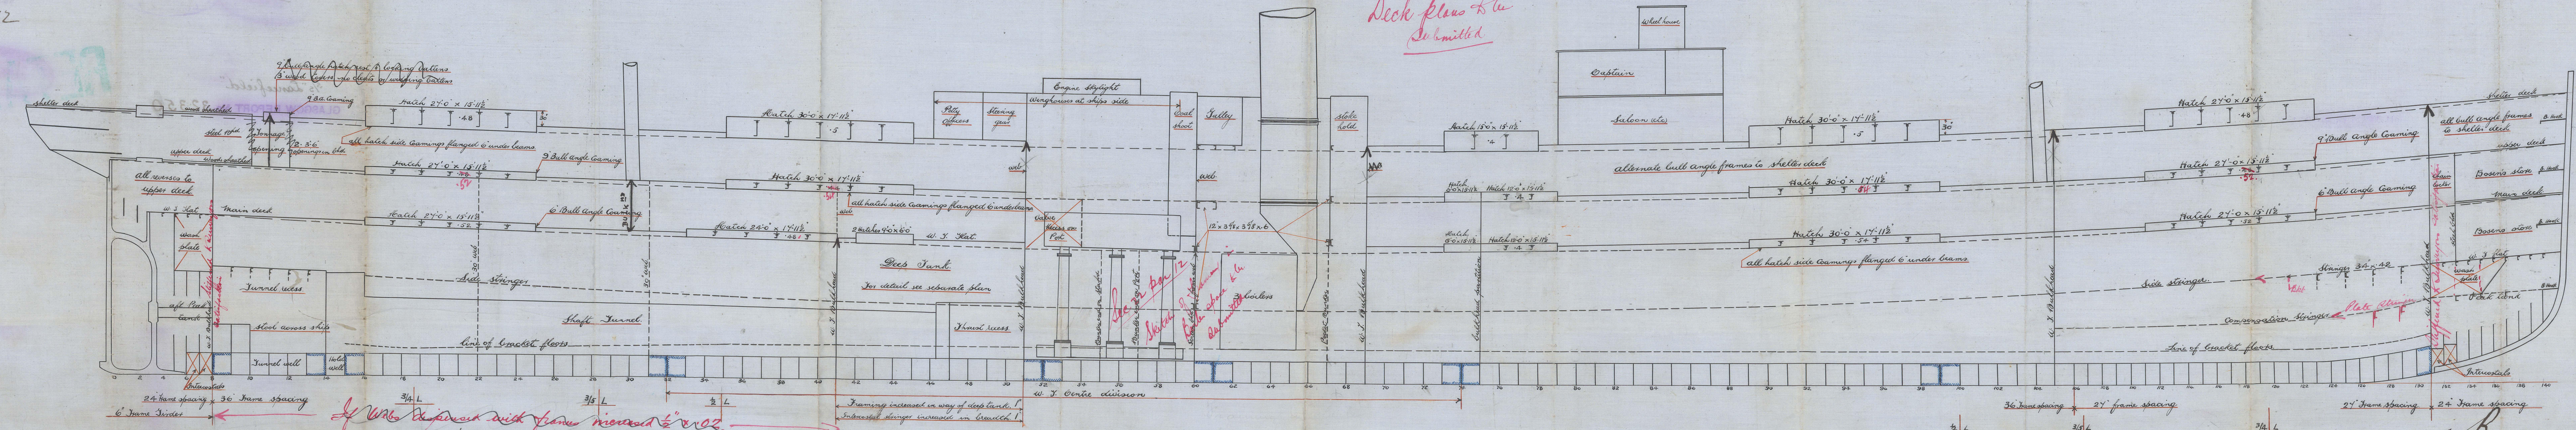

Handwritten notes:
If webs adjacent with frame increased 1/2" x 102
Webs fitted

Handwritten notes:
Bottom forward strengthened as per Rule
to Surveyors satisfaction

C.B.
17.1.12

C. Council & Co

Profile

EX^o 350 $\frac{5}{8}$

17 FEB. 1913

$\frac{5}{8}$ " "Lancefield"

GLASGOW REPORT No. 32350



© 2021

Lloyd's Register
Foundation

W1441-0085