





HORIZONTAL MULTITUBULAR STEEL BOILER 10'-0" DIA X 9'-6" LONG 180 LBS W.P. LLOYDS SURVEY

SCALE 1" = 1 FOOT

No 6380

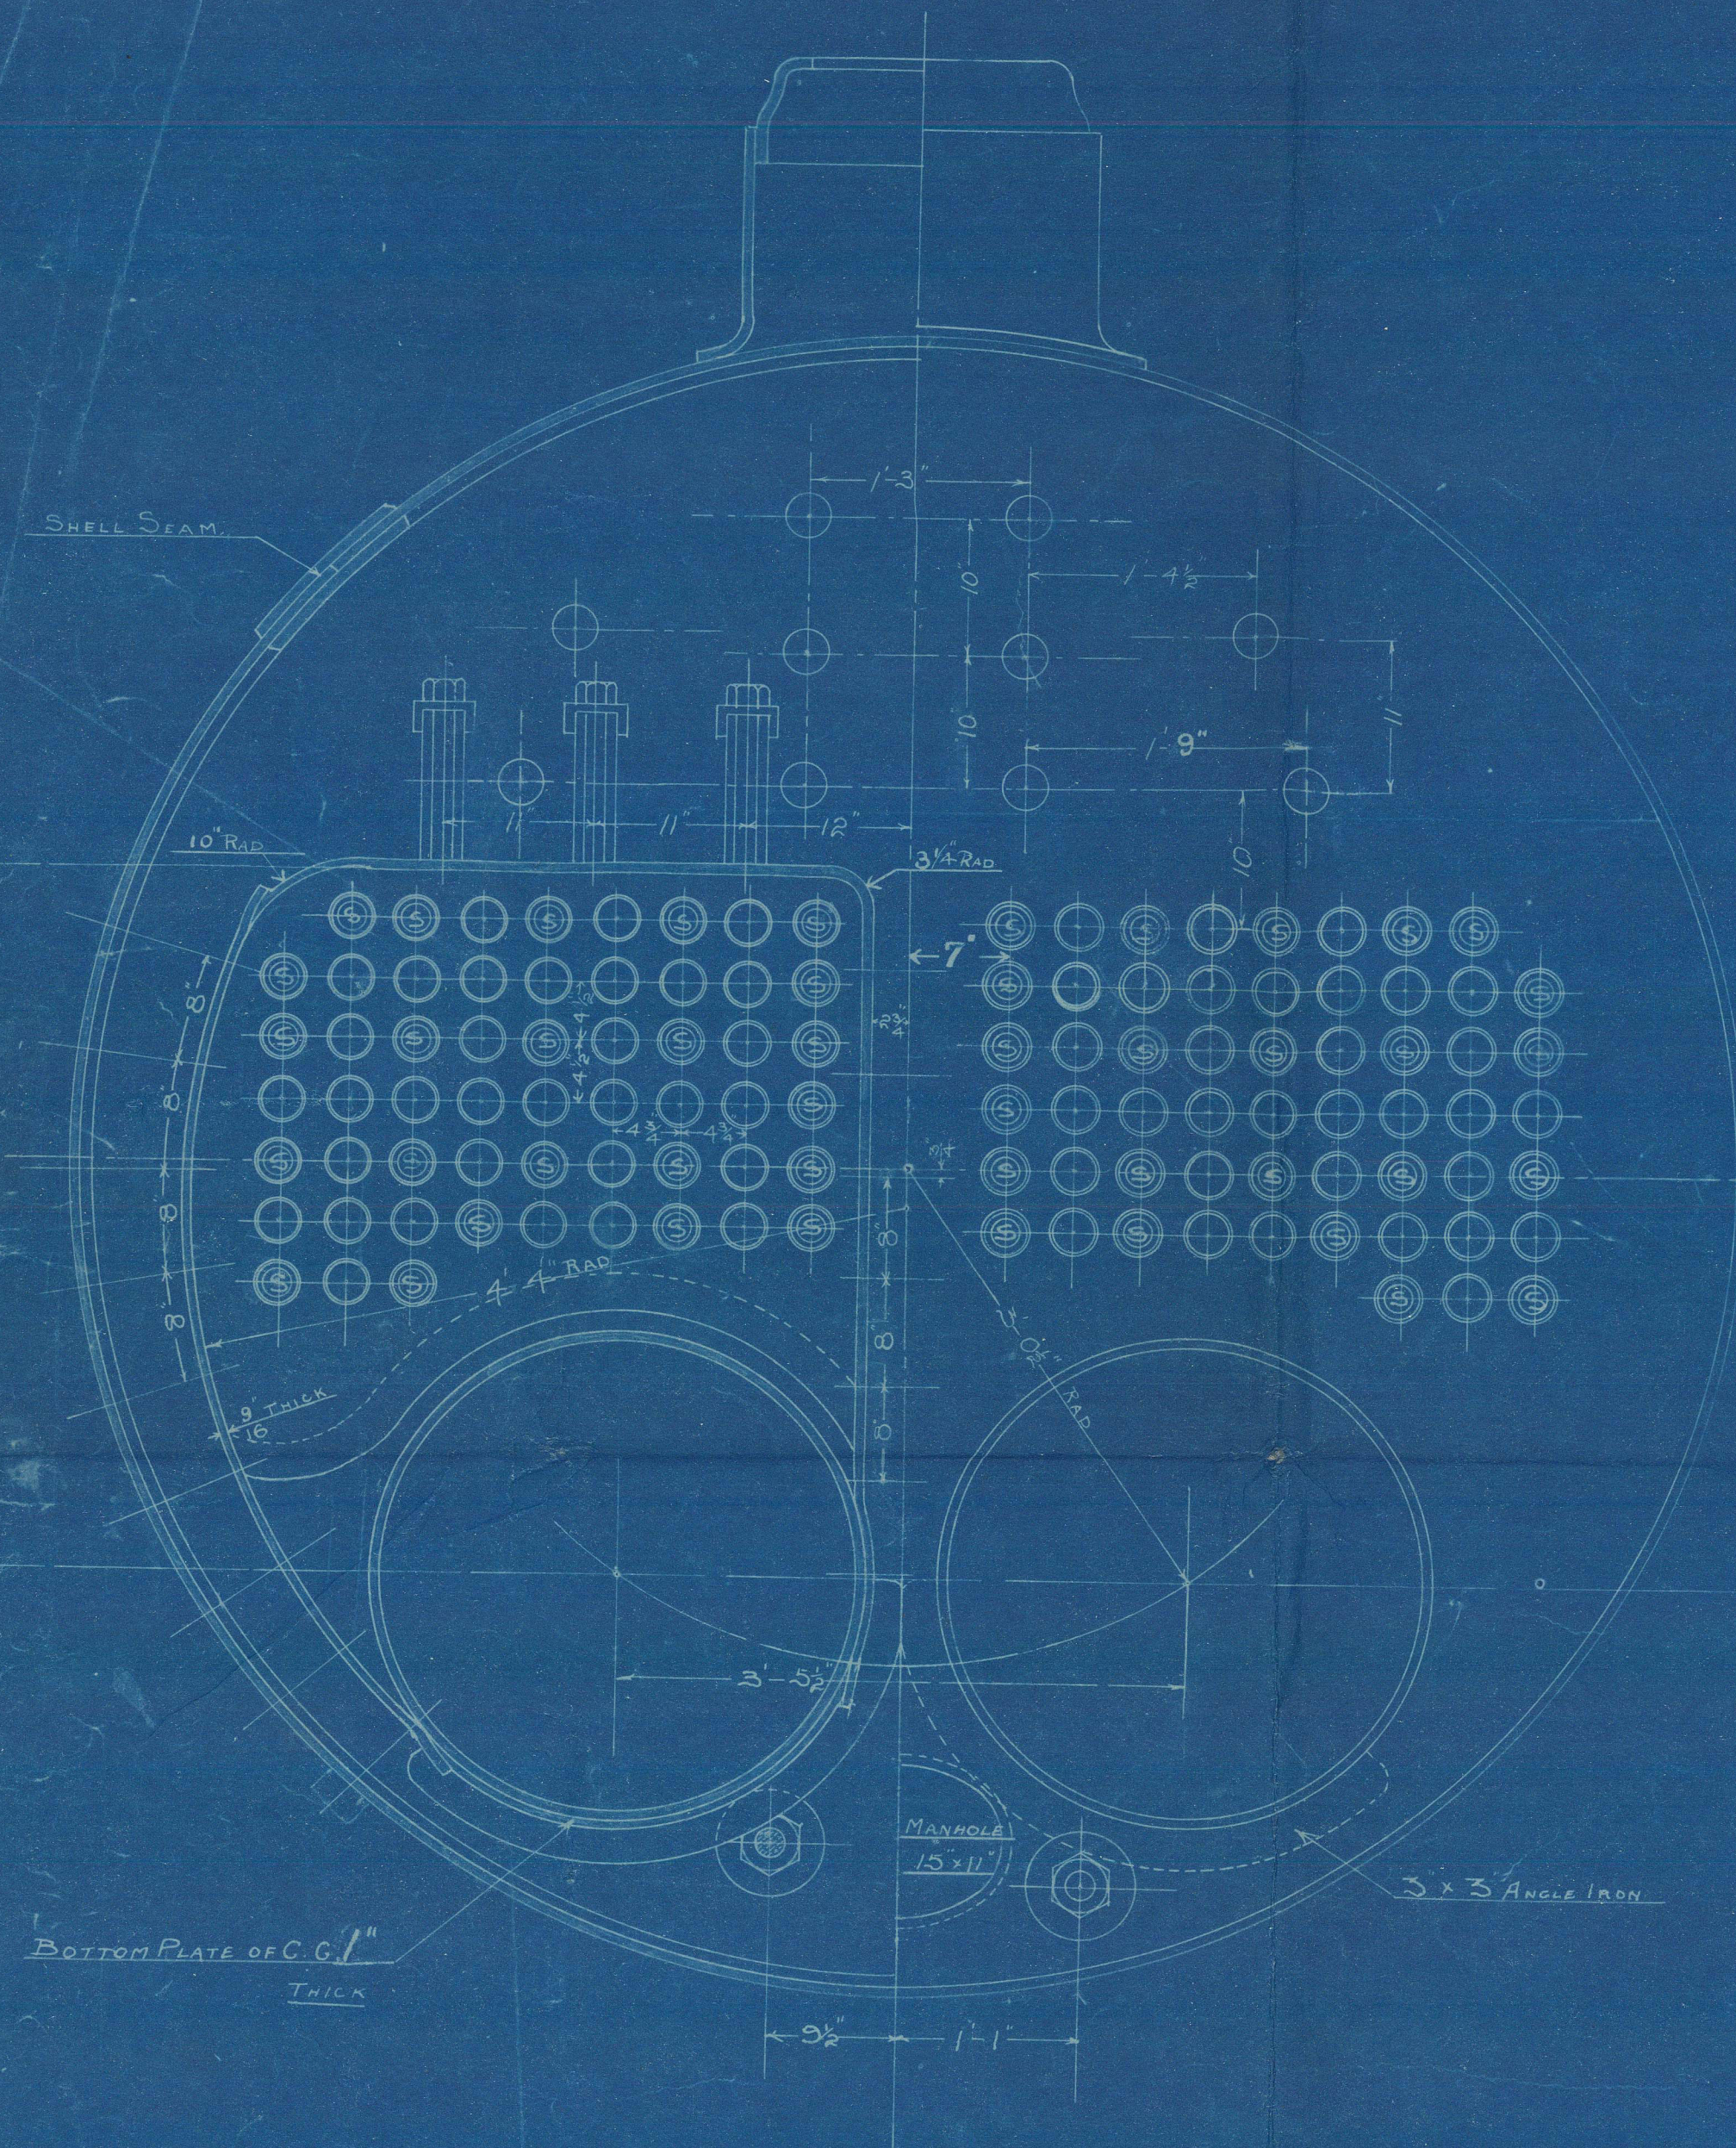

HEATING SURFACE 805.120
GRATE AREA 31.816

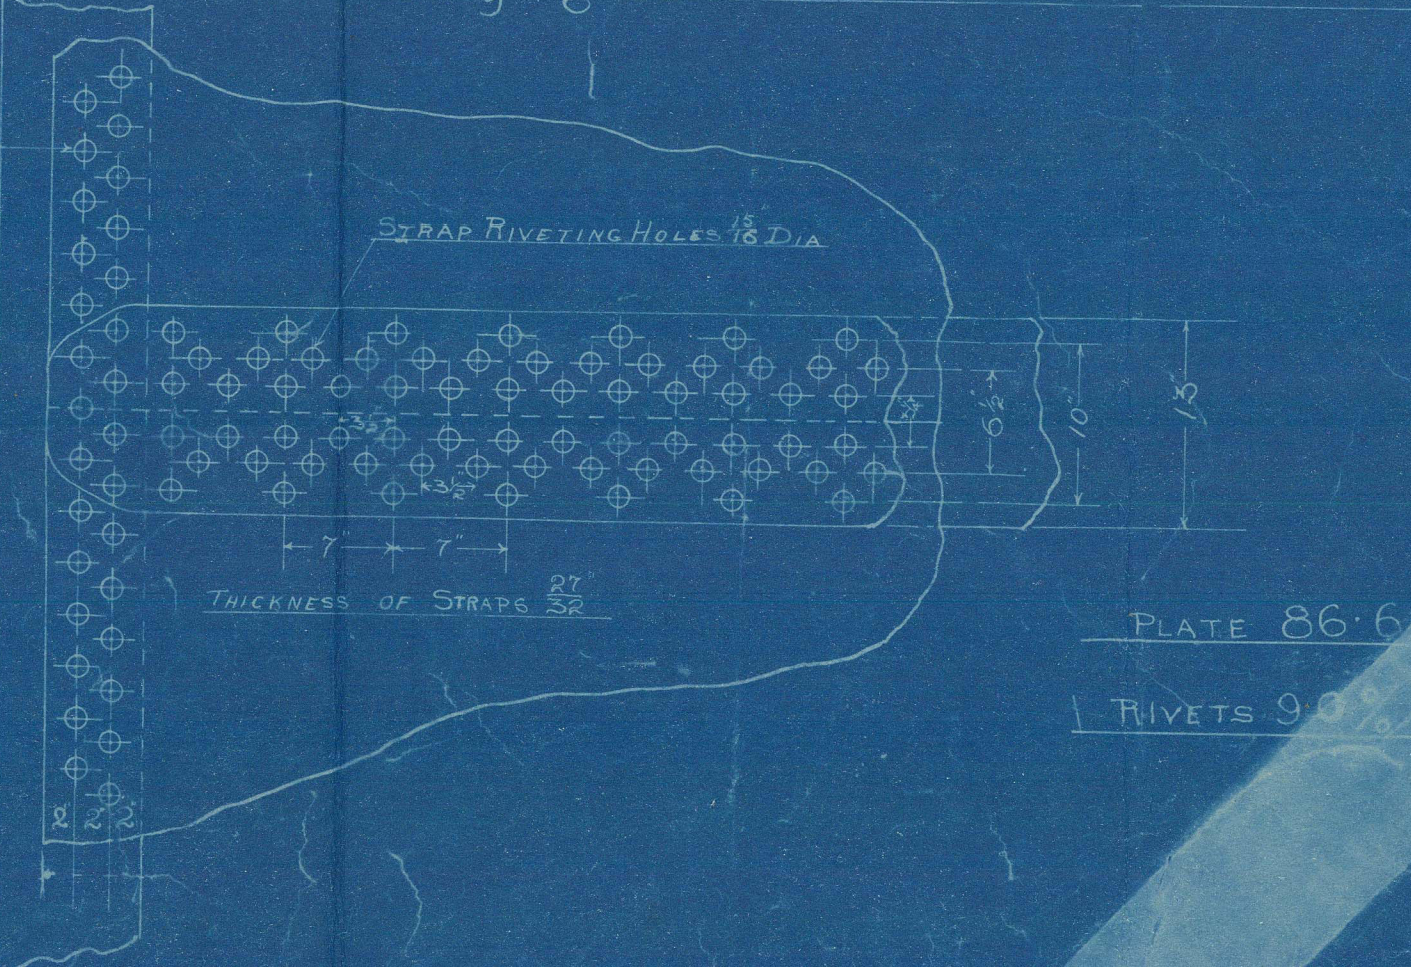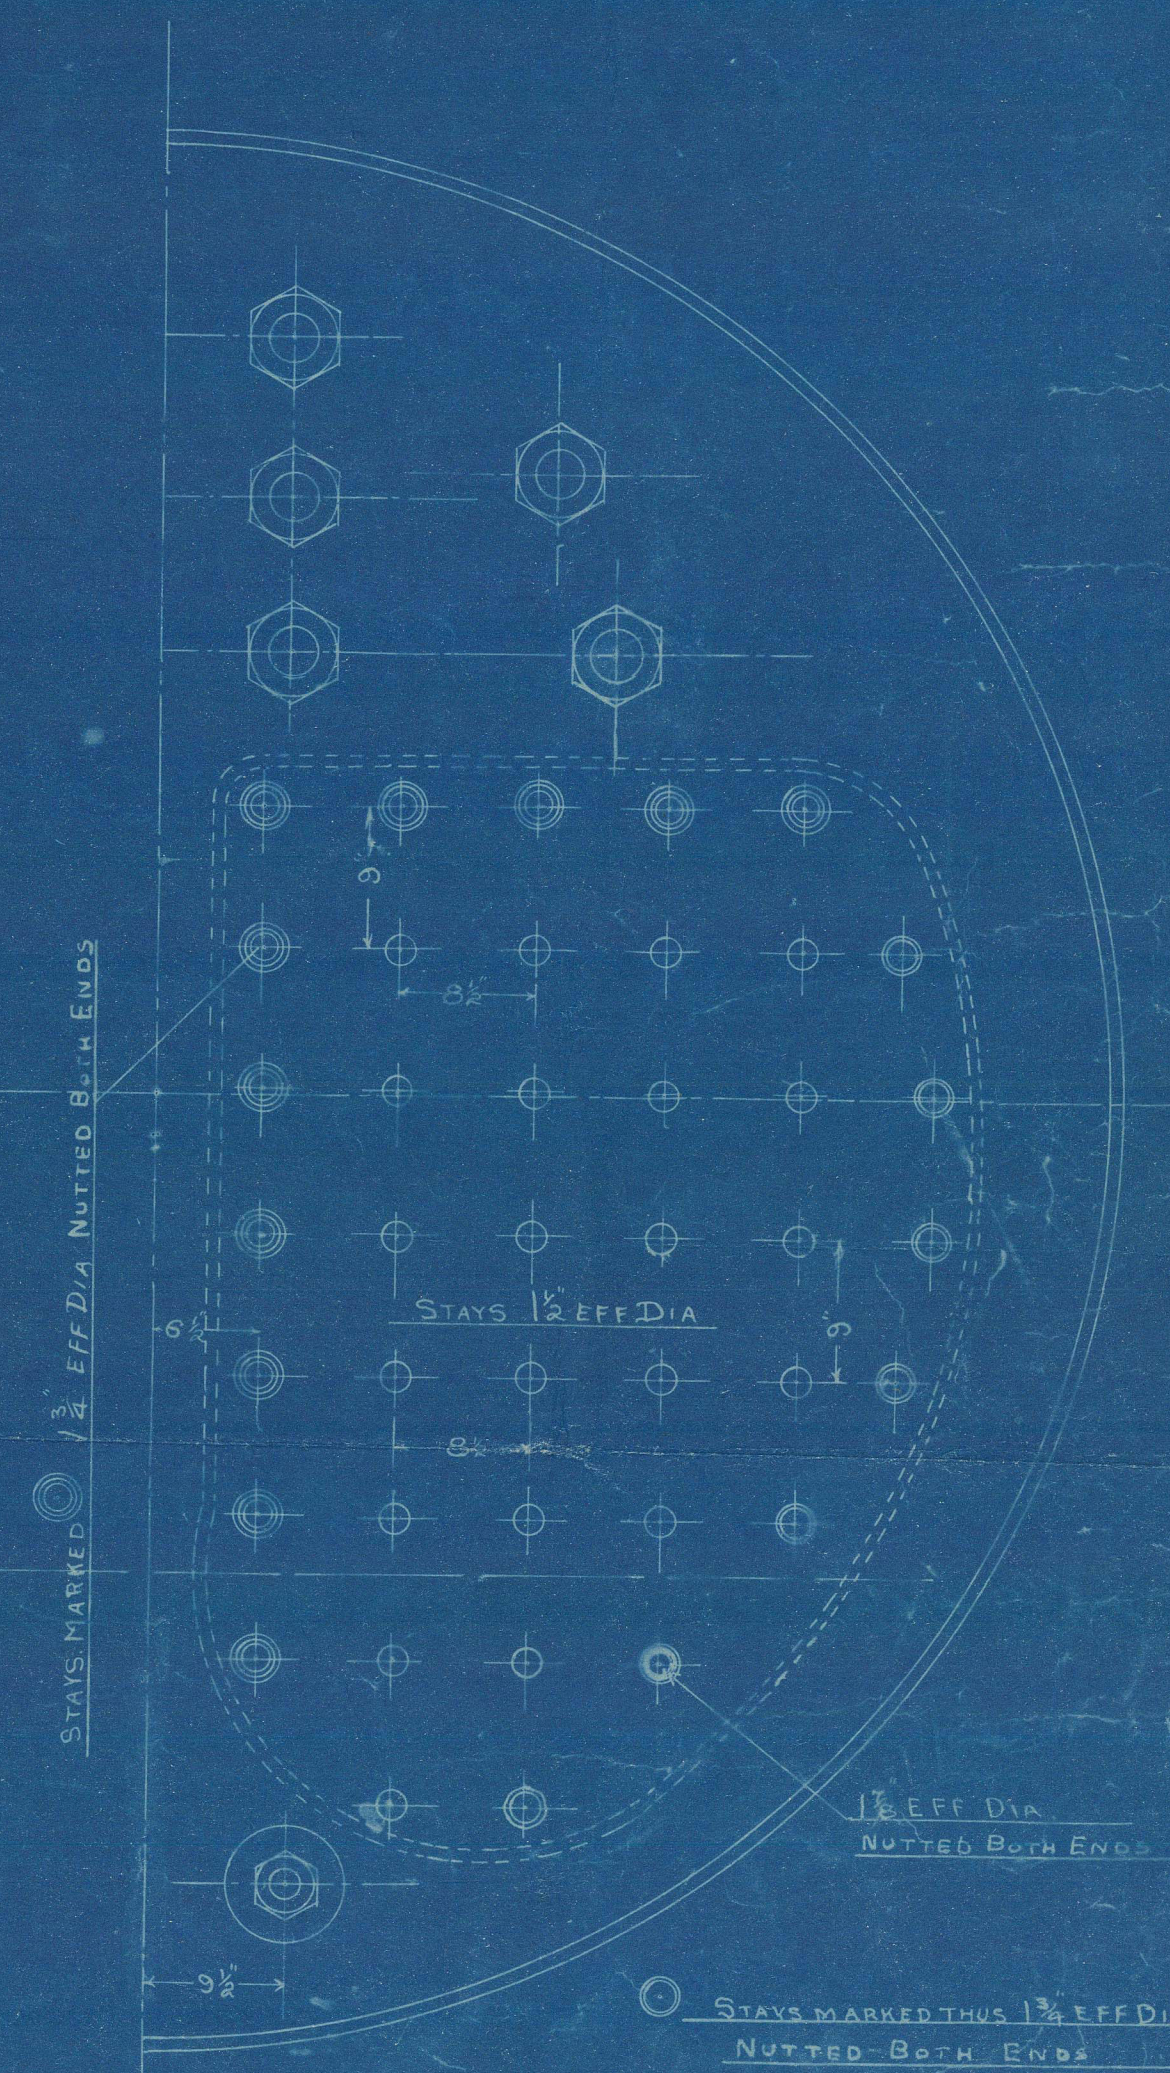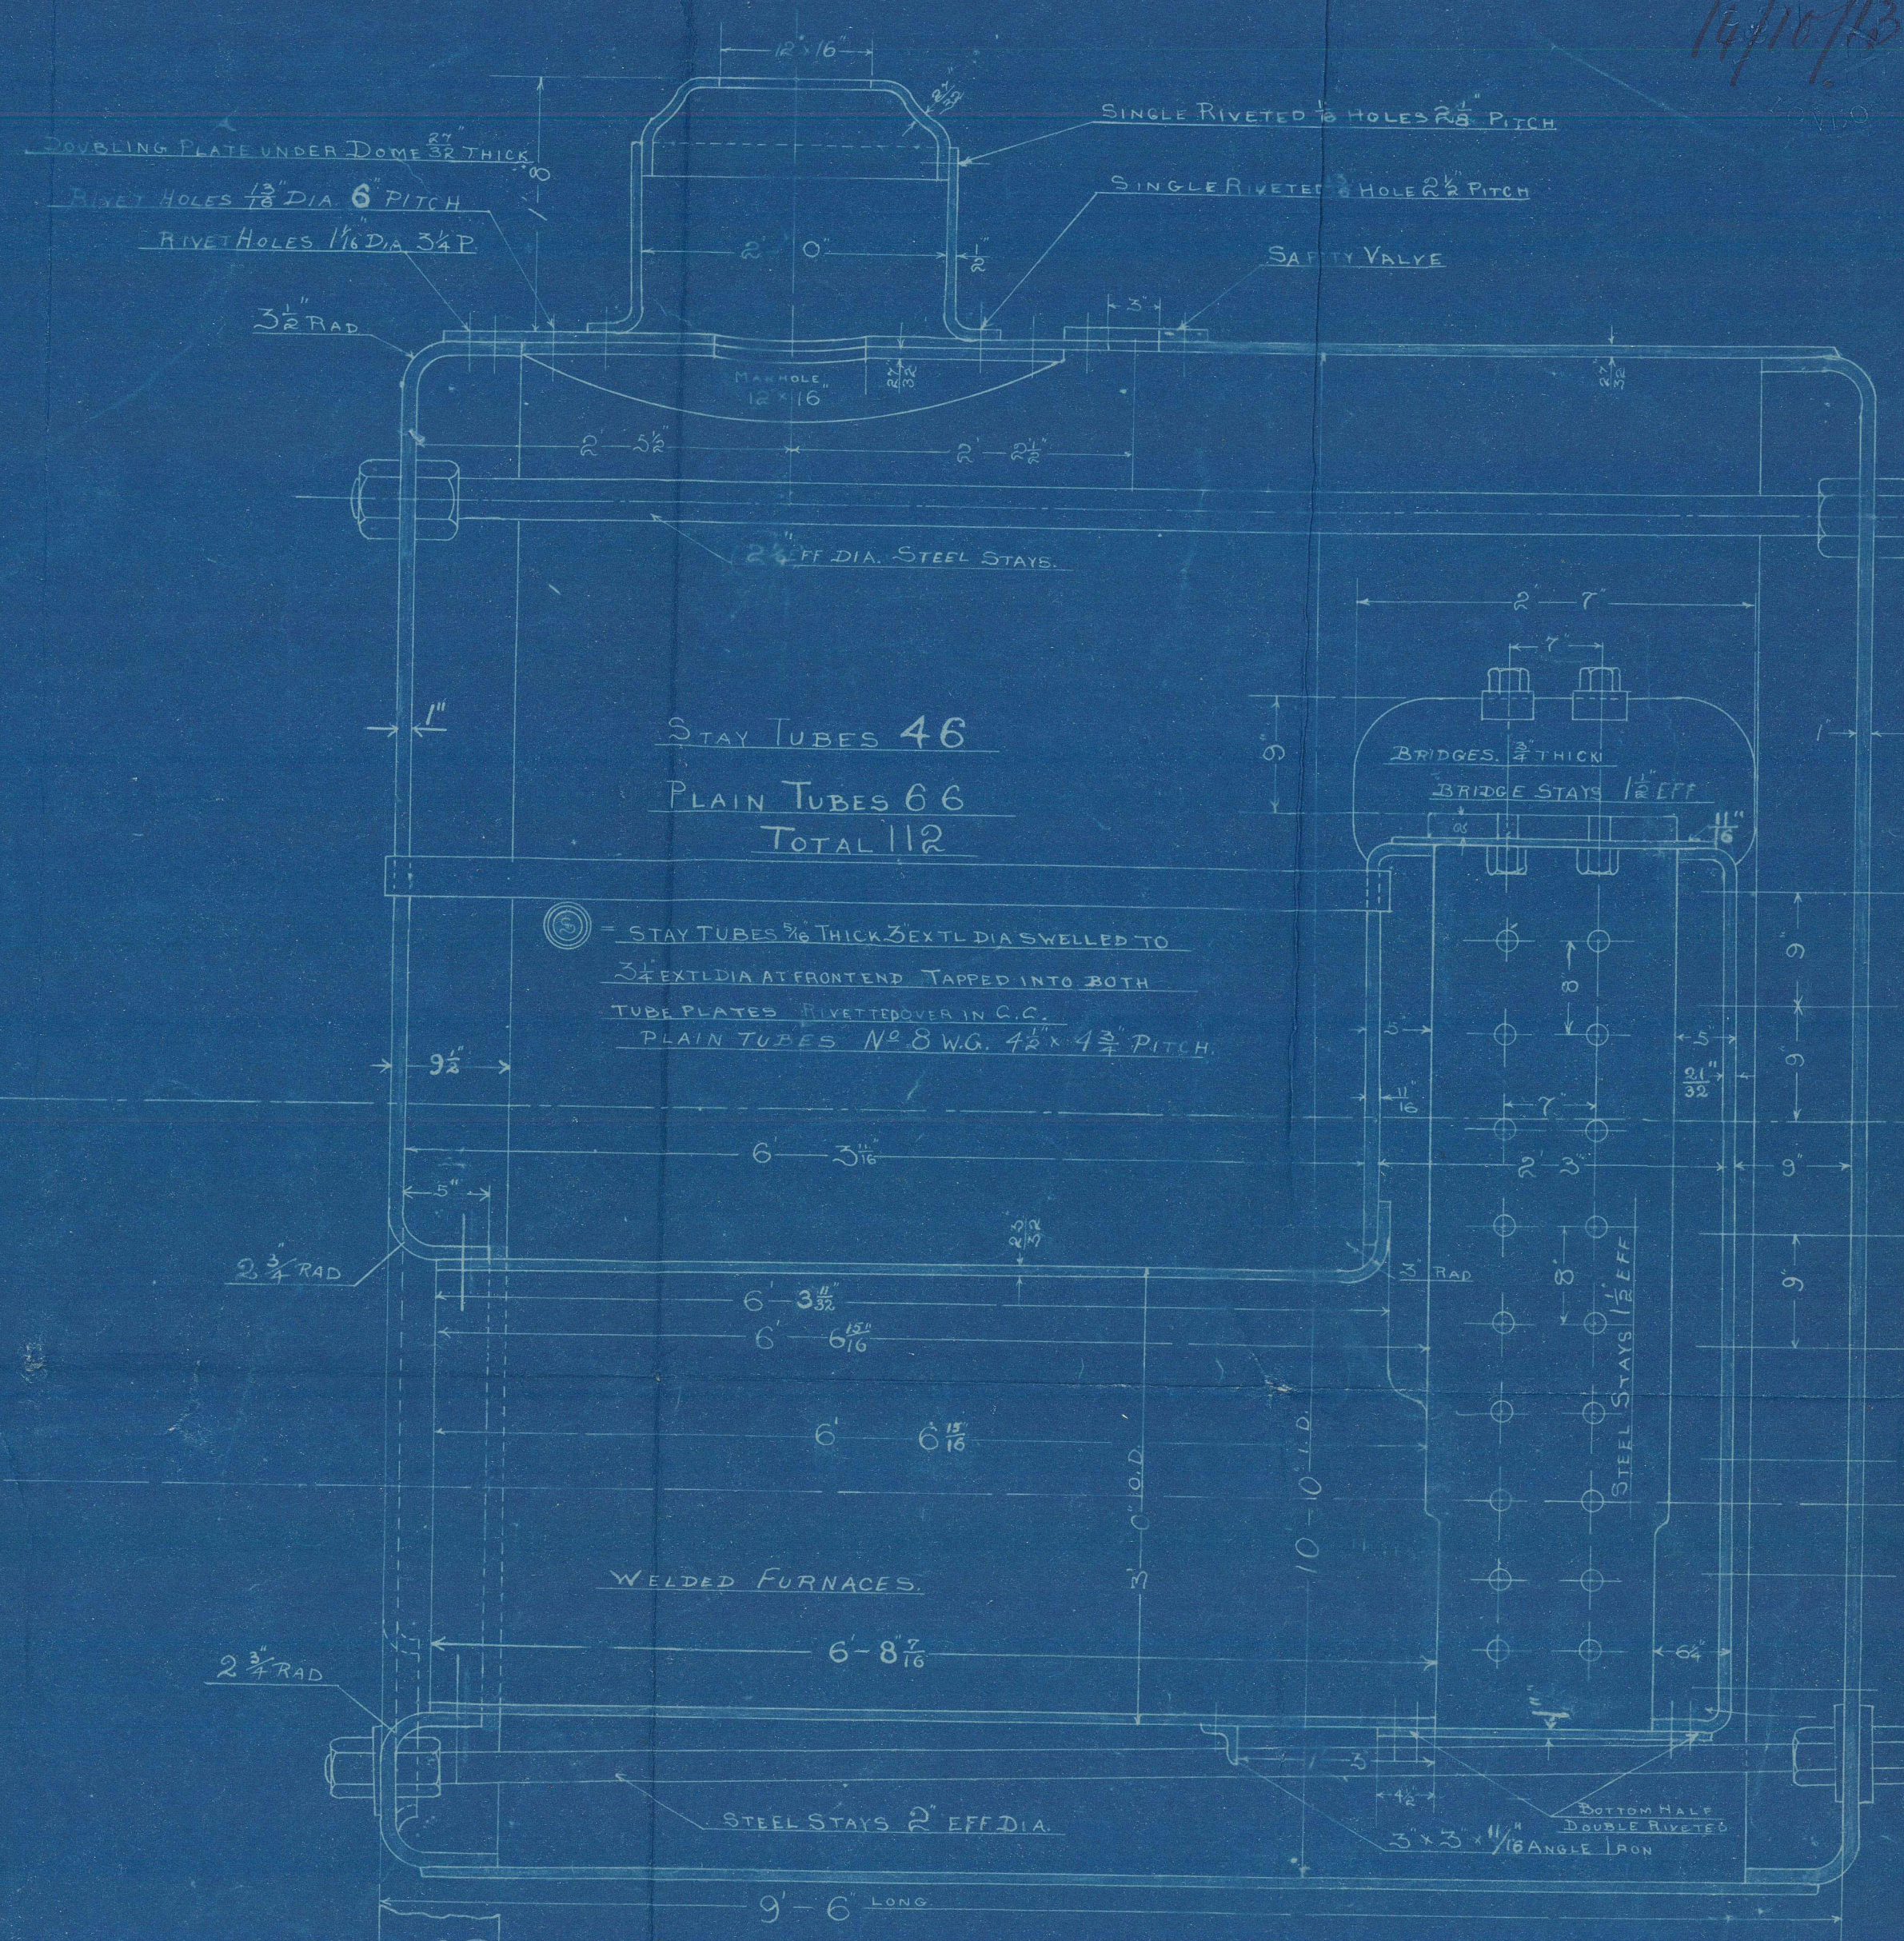


APR 14 1913



W1448-0030

150B

Boiler 6380
Elliott & Garrod. f.
s. i. English Rose
Hull 27564.
Nov. Rpt. 76726.

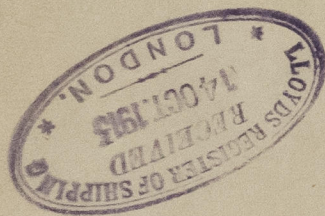

W1445-0030



© 2021

Lloyd's Register
Foundation