

27.10.13.
5.11.13

MIDSHIP SECTION STEEL SCREW DRIFTER

Nº 593

115.0 B.P. x 21.6 MLD. x 12.0 MLD.

SCALE 1/2 IN = 1 FT.

PLAN No. 3504
FOR ENCLOSURE TO
Messrs Lloyd's Surveyors
Hull FROM
COOPER & SONS, LTD
SHIPBUILDERS, GELBY.
DATE 21/10/13 *ESW*


NUMERALS

B + D = 21.50 + 12.00 = 33.50 = T.N.
L 115.00 + 33.50 = 3852.50 = L.N.

EQUIPMENT

1ST BOWER ANCHOR 5 CWTs EX STOCK ✓
2ND DO DO 4 1/2 " " " ✓
KEDGE DO 2 1/2 " " " ✓
90 FMS 1" DIA STUD CHAIN CABLE ✓
60 " 5 1/2" HAWSER ✓
60 " 4" WARP ✓

L/D 9.58
L/B 5.38

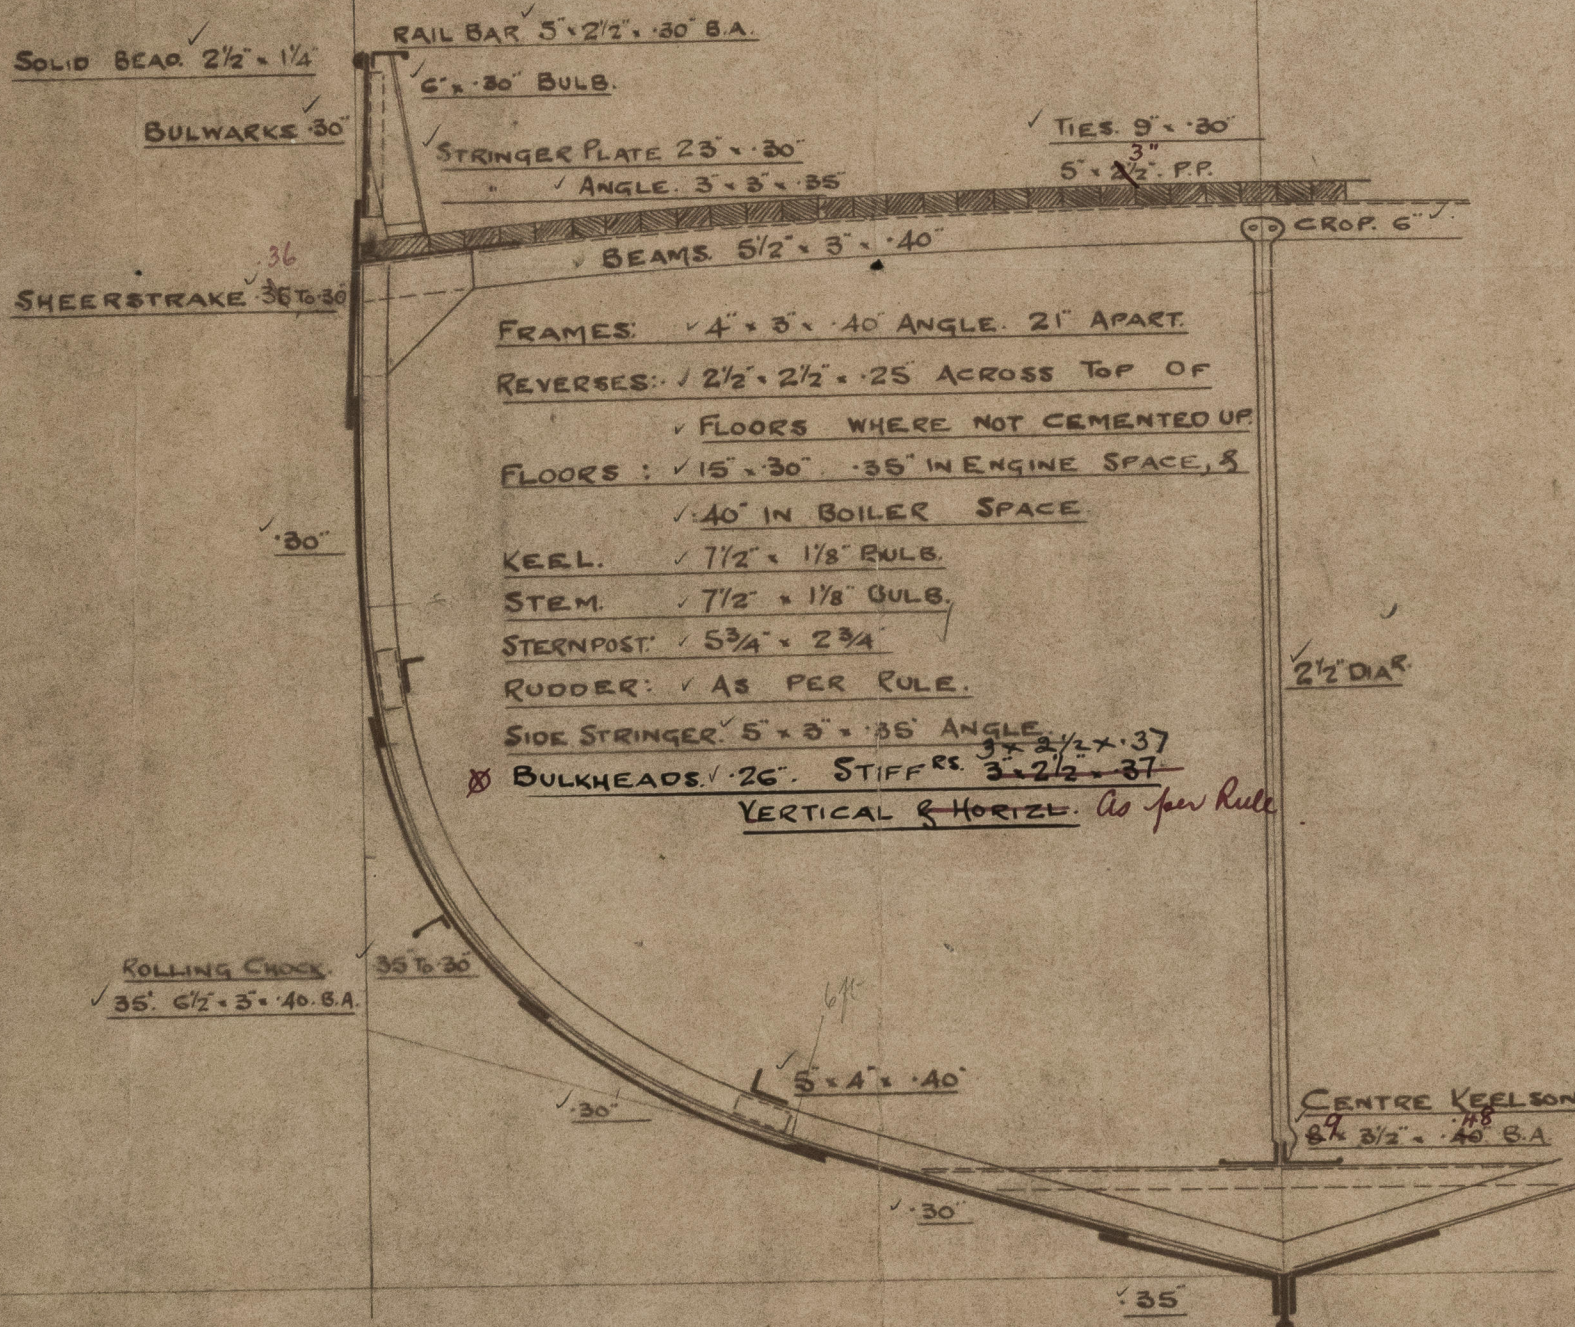

ESW
27.10.13.

W1445-0031

Cochrane & Sons

Nº-593


Midship Section

Dimensions


115-0 x 21-5 x 12-0

As "English Rose"

Hull Rph. No. 27364

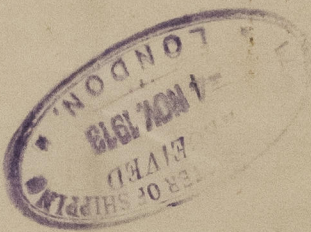


3 41
11/18

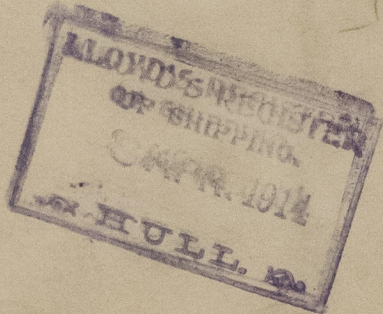

W1445-0031

RETAIN

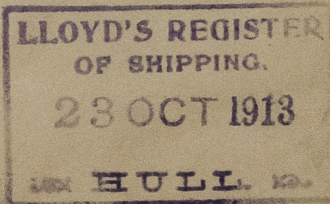

W1445-0031



© 2021

Lloyd's Register
Foundation