

# STEEL BOILER

SCALE 1" = 1 FOOT

W.P. = 120 LBS (TO PASS LLOYDS)




FOR MESSRS The Grangemouth & Greenock Dockyard Co. N° 263<sup>5</sup>/<sub>5</sub>

ORDER N° 1937.

Heating Surface 291<sup>3</sup>/<sub>4</sub>  
Grate 11<sup>1</sup>/<sub>2</sub>

Circle 16" dia. 16" pitch. 16" rivets

Plate 80.45% Shell 12"  
Rivets 87.45%

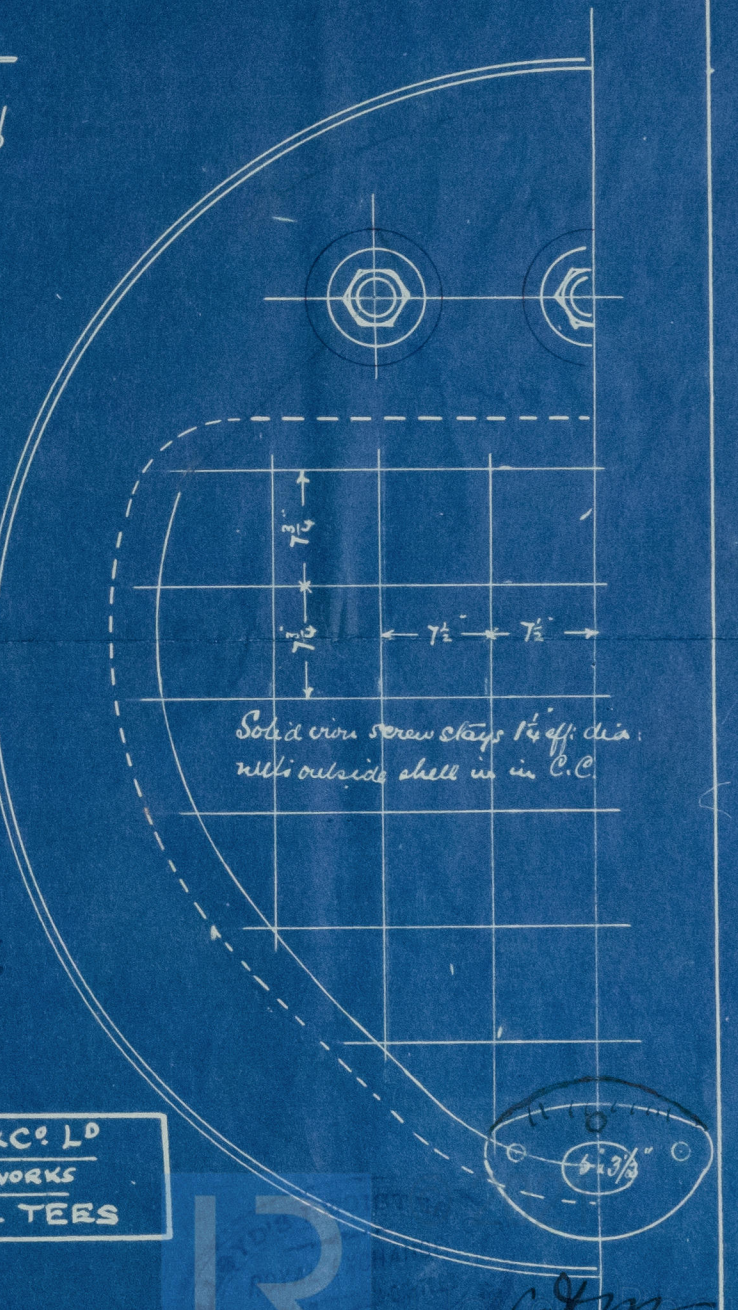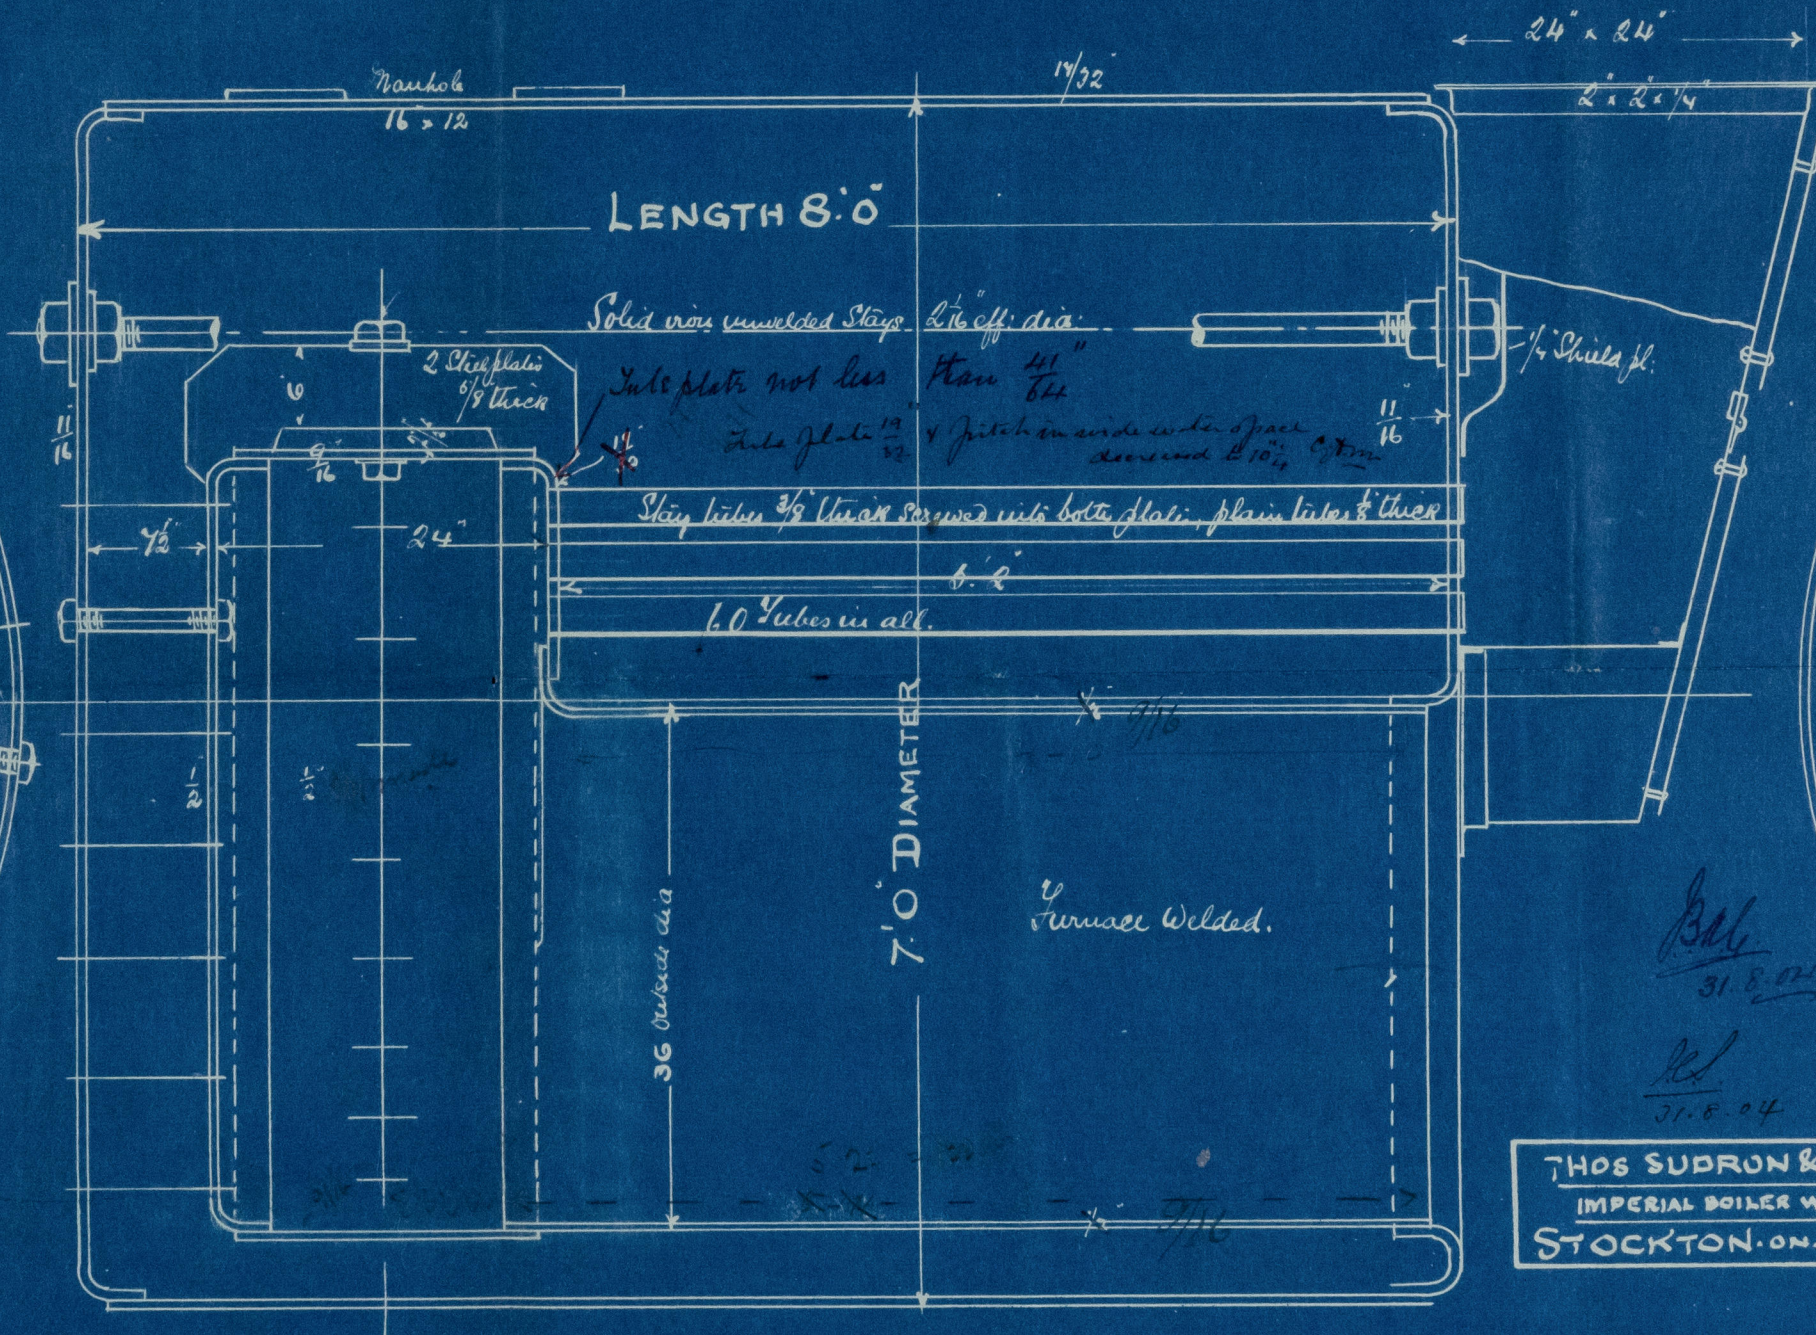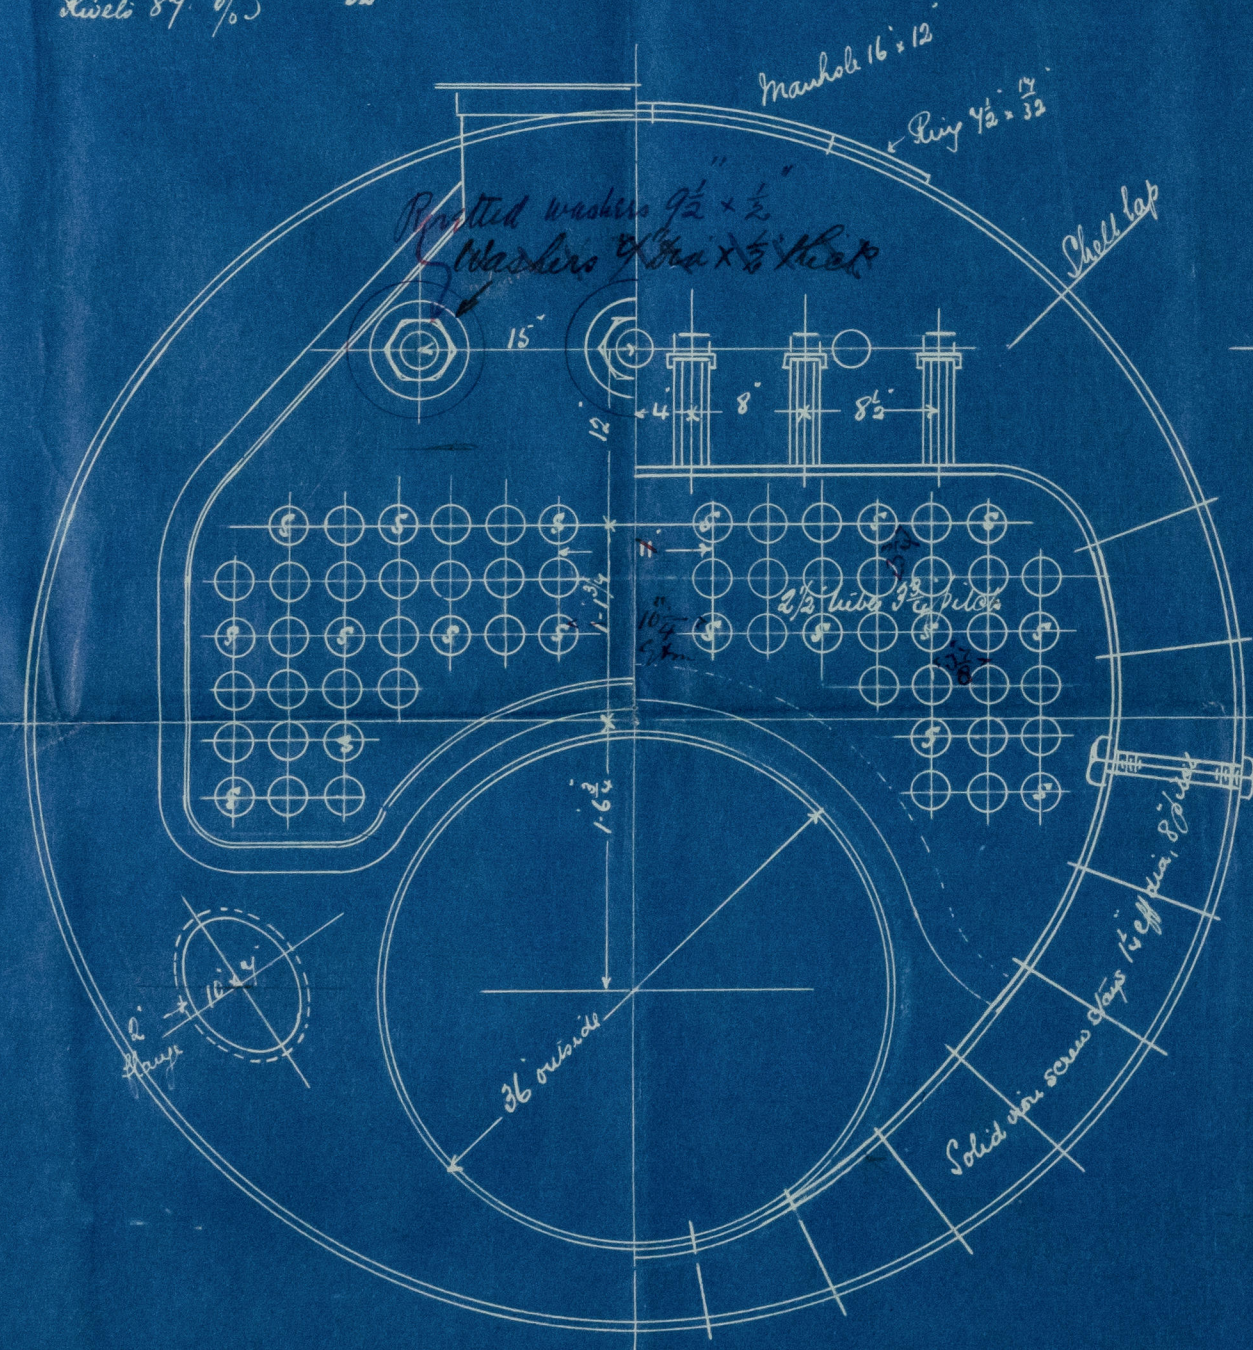

THOS SUPRON & CO. LD  
IMPERIAL BOILER WORKS  
STOCKTON-ON-TEES

31.8.04

30/8/04

6/8/04.





J Sudron & Co. Ltd  
No 1937

Grangemouth & Greenock  
8 x gal. No 263 5/8

120 lb. W.P.

Lith Report.  
N: 10926.



Lettered 4th 1904  
"of Range"  
Forester 6

© 2021

Lloyd's Register  
Foundation  
W1449-0032

