

15-1-11




N^os 143 & 144.

ELEVATION

DIMS: 110'-0" x 21'-6" x 12'-11" M.L.O.


SCALE 1/4" = 1 FOOT

23/1/11

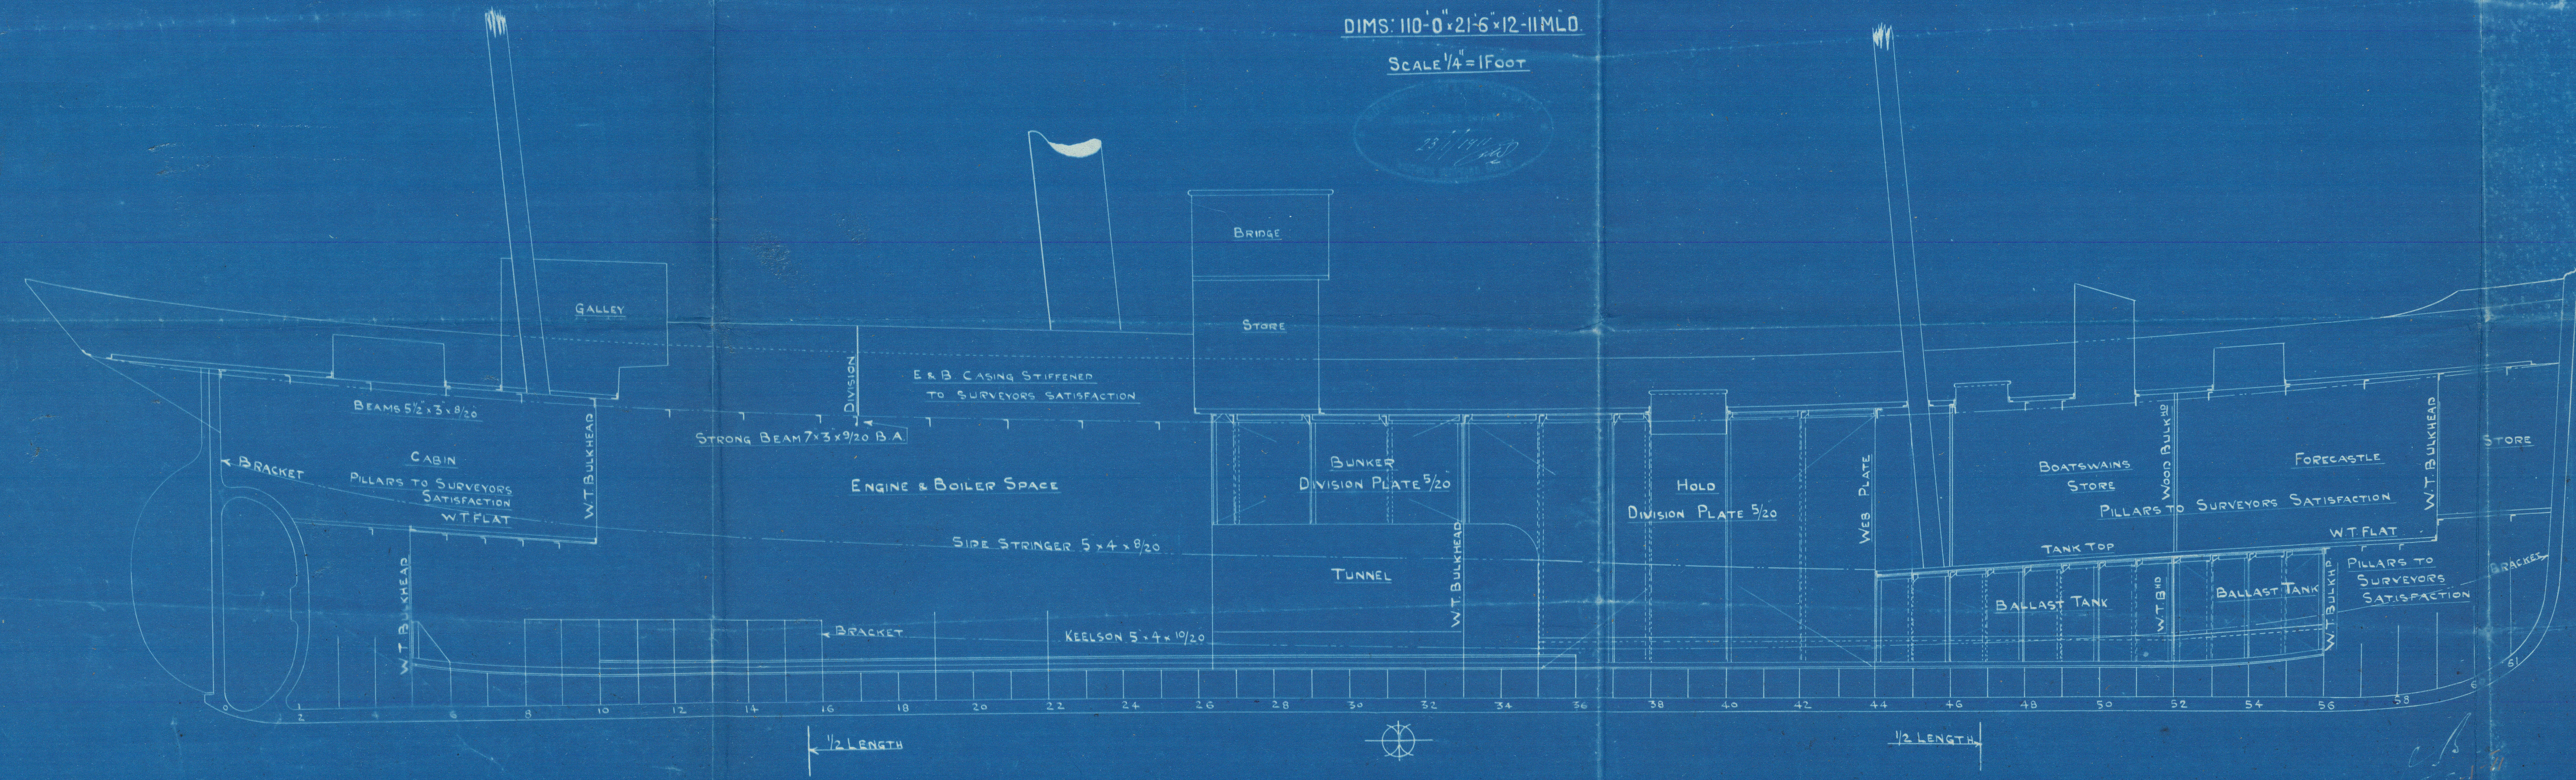

SECTION THROUGH
BALLAST TANK

SCALE 1/2" = 1 FOOT

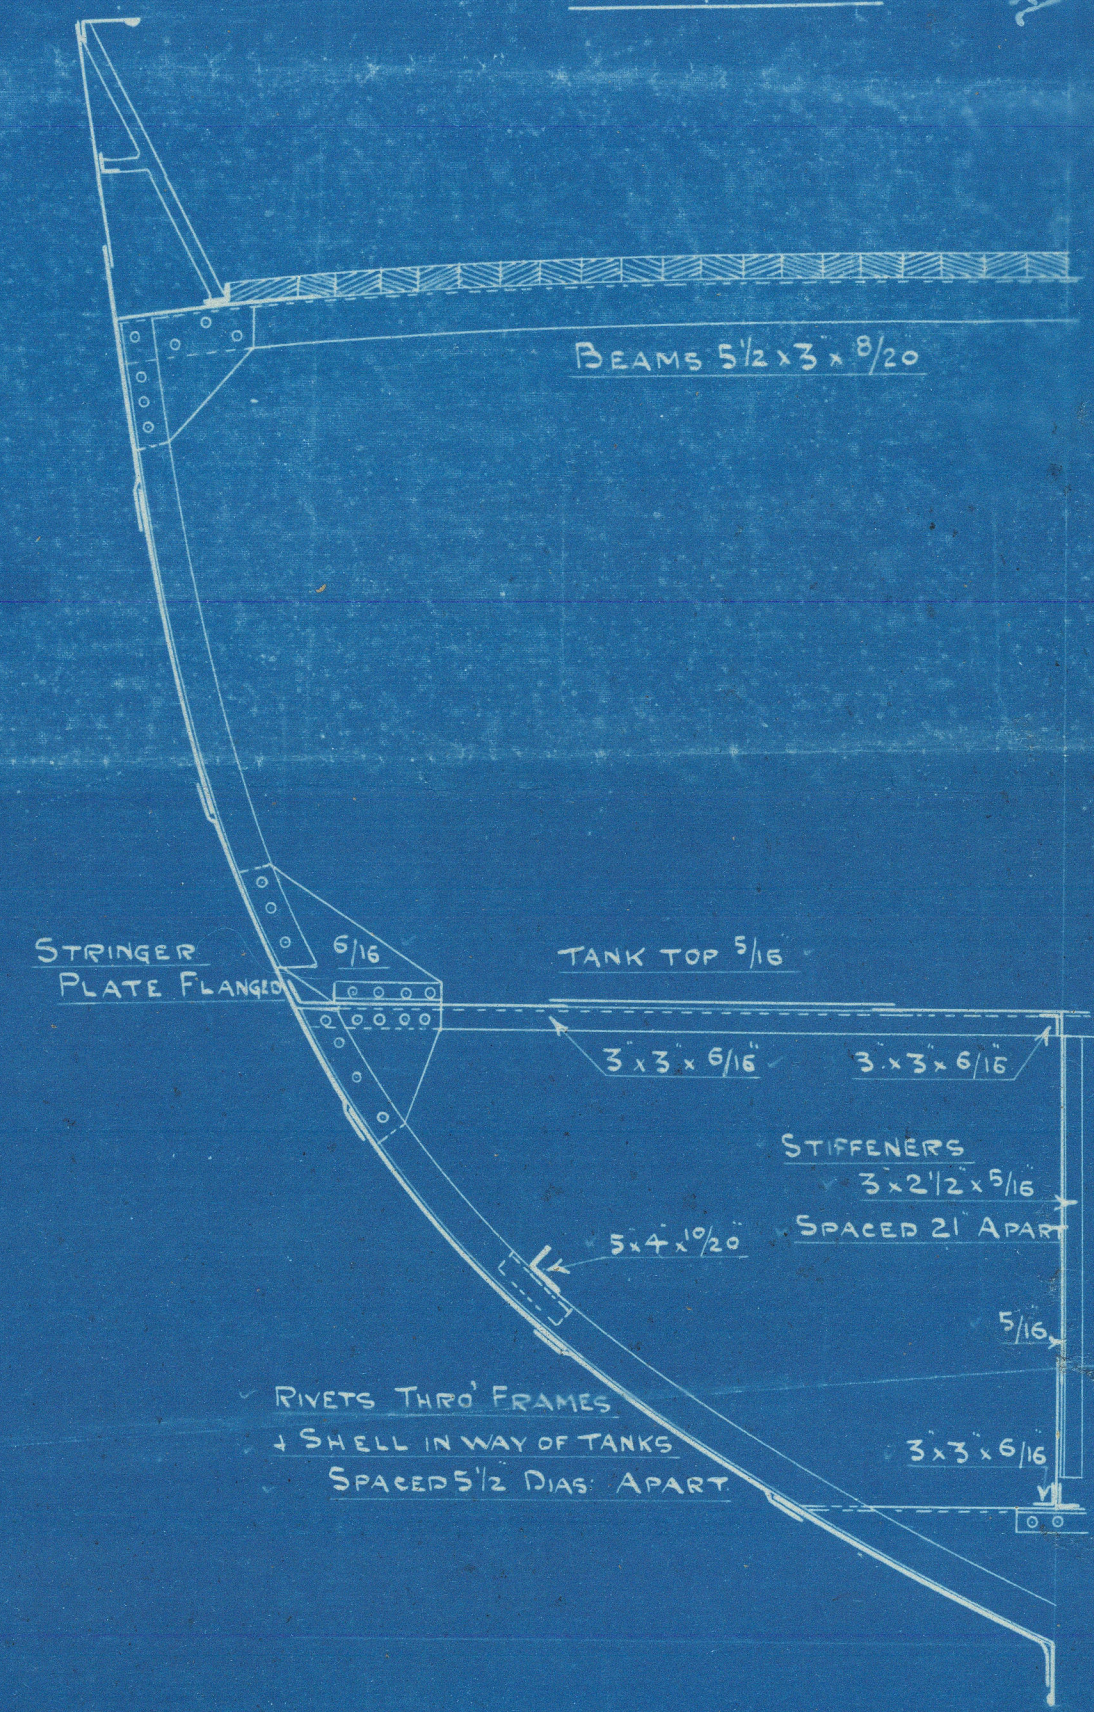

Isobel S. + R.C.

Nos 143 + 144

Duplicate
Profile.

of Flicker

Hull Rpt n 24352

TELLAIN



© 2021

Lloyd's Register
Foundation

W1449-0175