


3 JUN 1937

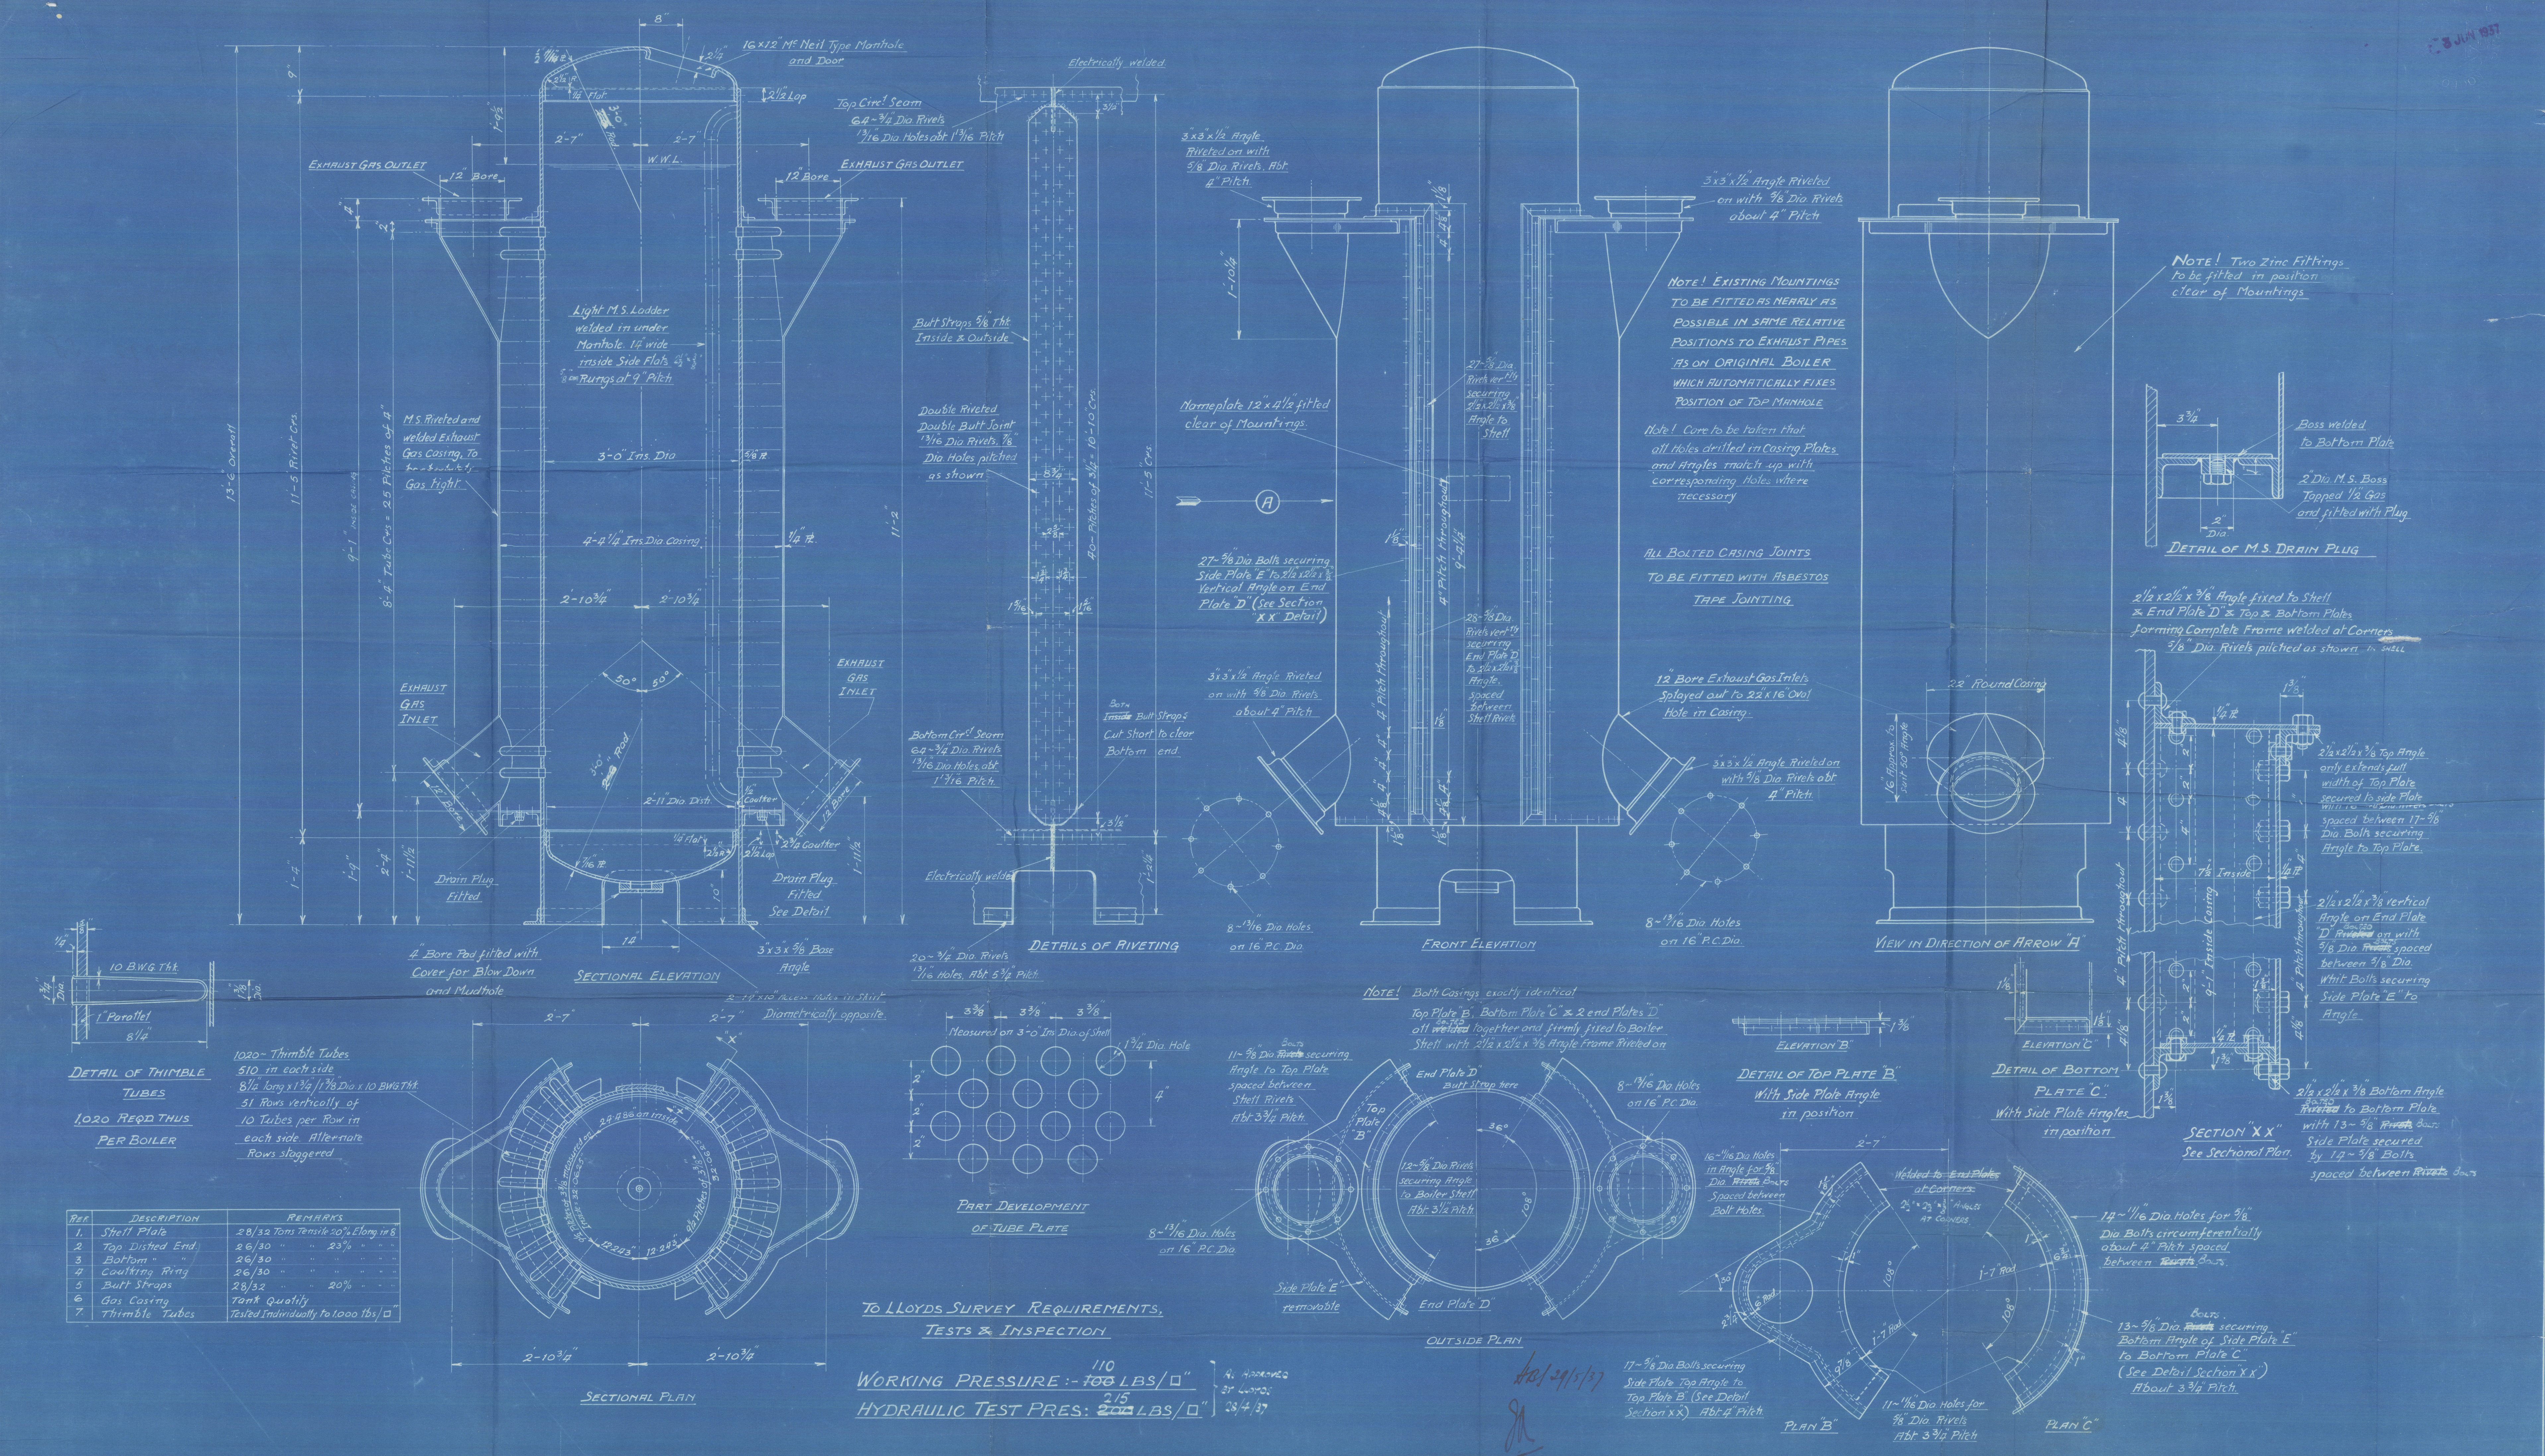

S.S. Athelchief. Shp rept.

No 485,

(attached ^{to} 110716)

X1145-0132



© 2020

Lloyd's Register
Foundation