


WORKING PRESSURE = 120 LBS/IN<sup>2</sup>

SCALE 1" = ONE FOOT

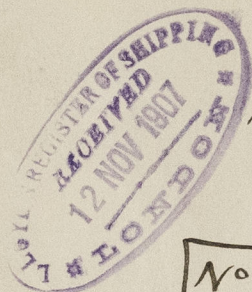

A. Bodman & Co  
King's Lynn



Boiler No 1184


No 786  
Lugs tot  
240lb  
30.3.08 FLS



for W. H. Warren  
S/s No 63

S/s Gazelle  
Hull No. 20.222  
ton - 70.583.

RECEIVED

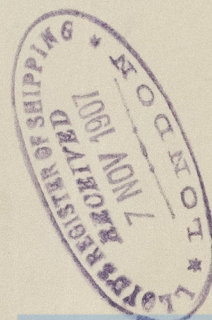

© 2021

Lloyd's Register  
Foundation

W1450-0130





0130



© 2021

Lloyd's Register  
Foundation