
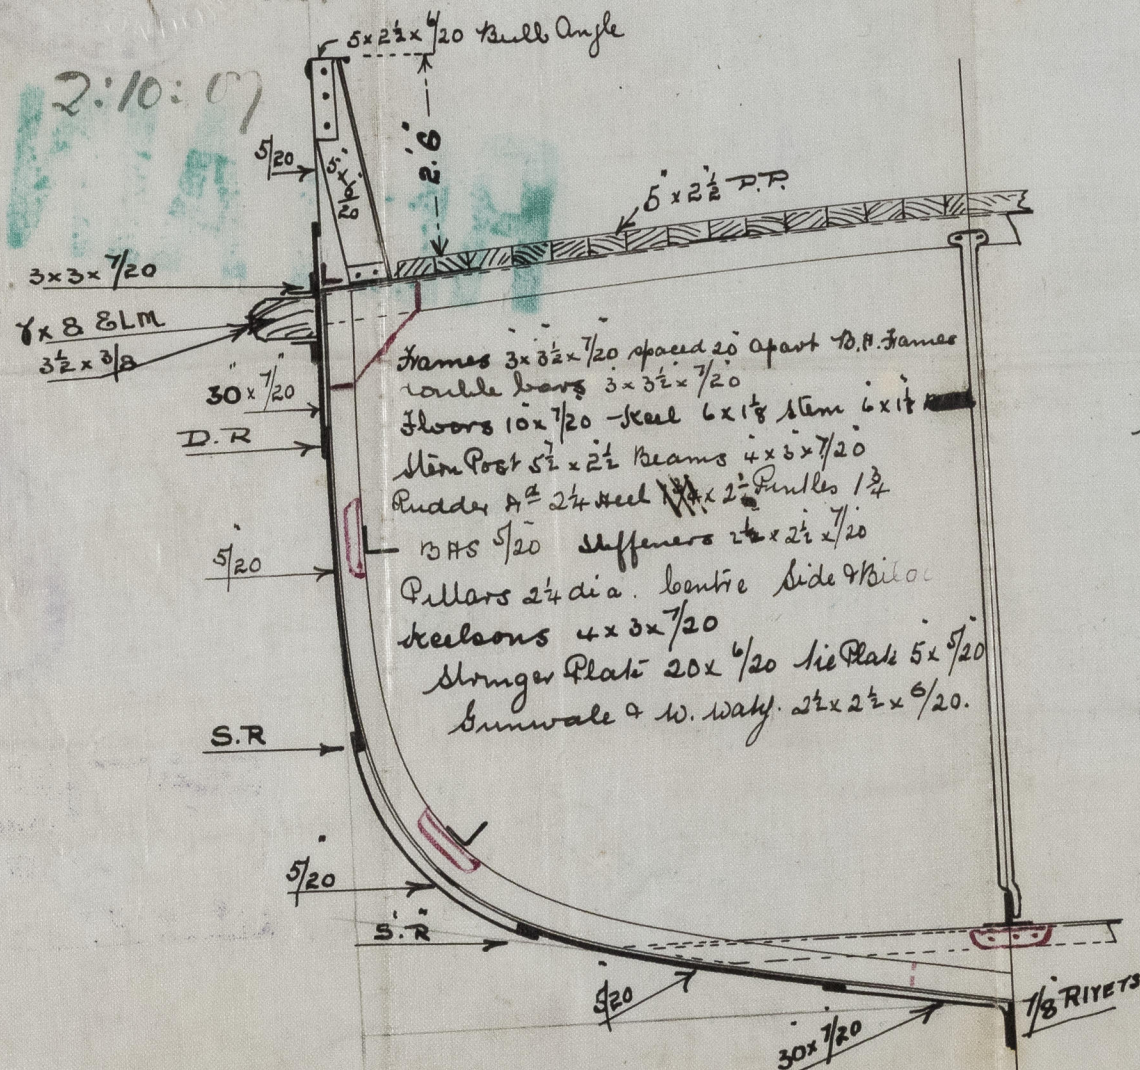


N° 83
60.0" x 14.0" x 8.0 MLD



58 Rivets
Bulls of 13 b & D lapped & double
riveted 9 & 6 straps 1/20 thicker
than plates they connect &
double Rivets, tin edge of sheer
strake - double Rivets rest S. rivets

W. T. WARREN
SHIPBUILDER
NEW HOLLAND

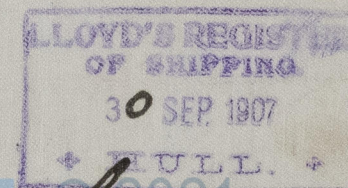

2. 10. 07. Lloyd's Register
Foundation W1450-0131

W. A. Warren
No 63.

amended.
Midship Section.

1/2 Gazelle
Hull Report No. 20.222

APPROVED
MIDSHIP SECTION

80.0 x 14.0 x 8.0 MLD
N. 63






W. A. WARREN
SHIPBUILDER
NEW HOLLAND

W. A. WARREN
SHIPBUILDER
NEW HOLLAND

© 2021
Lloyd's Register
Foundation
W1450-0131