

over 4 masted 2nd mst
 81 ft 2 in
 100 ft 2 in
 100 ft 2 in

16.2.07

PROFILE & DECK PLAN.



STEEL SCREW DRIFTER.

Nº 413.


DIMENS. 82'-0" x 18'-3" x 9'-0" MOULDED.

TO CLASS 100.A.1 FOR FISHING PURPOSES.

SCALE 1/4" = ONE FOOT.

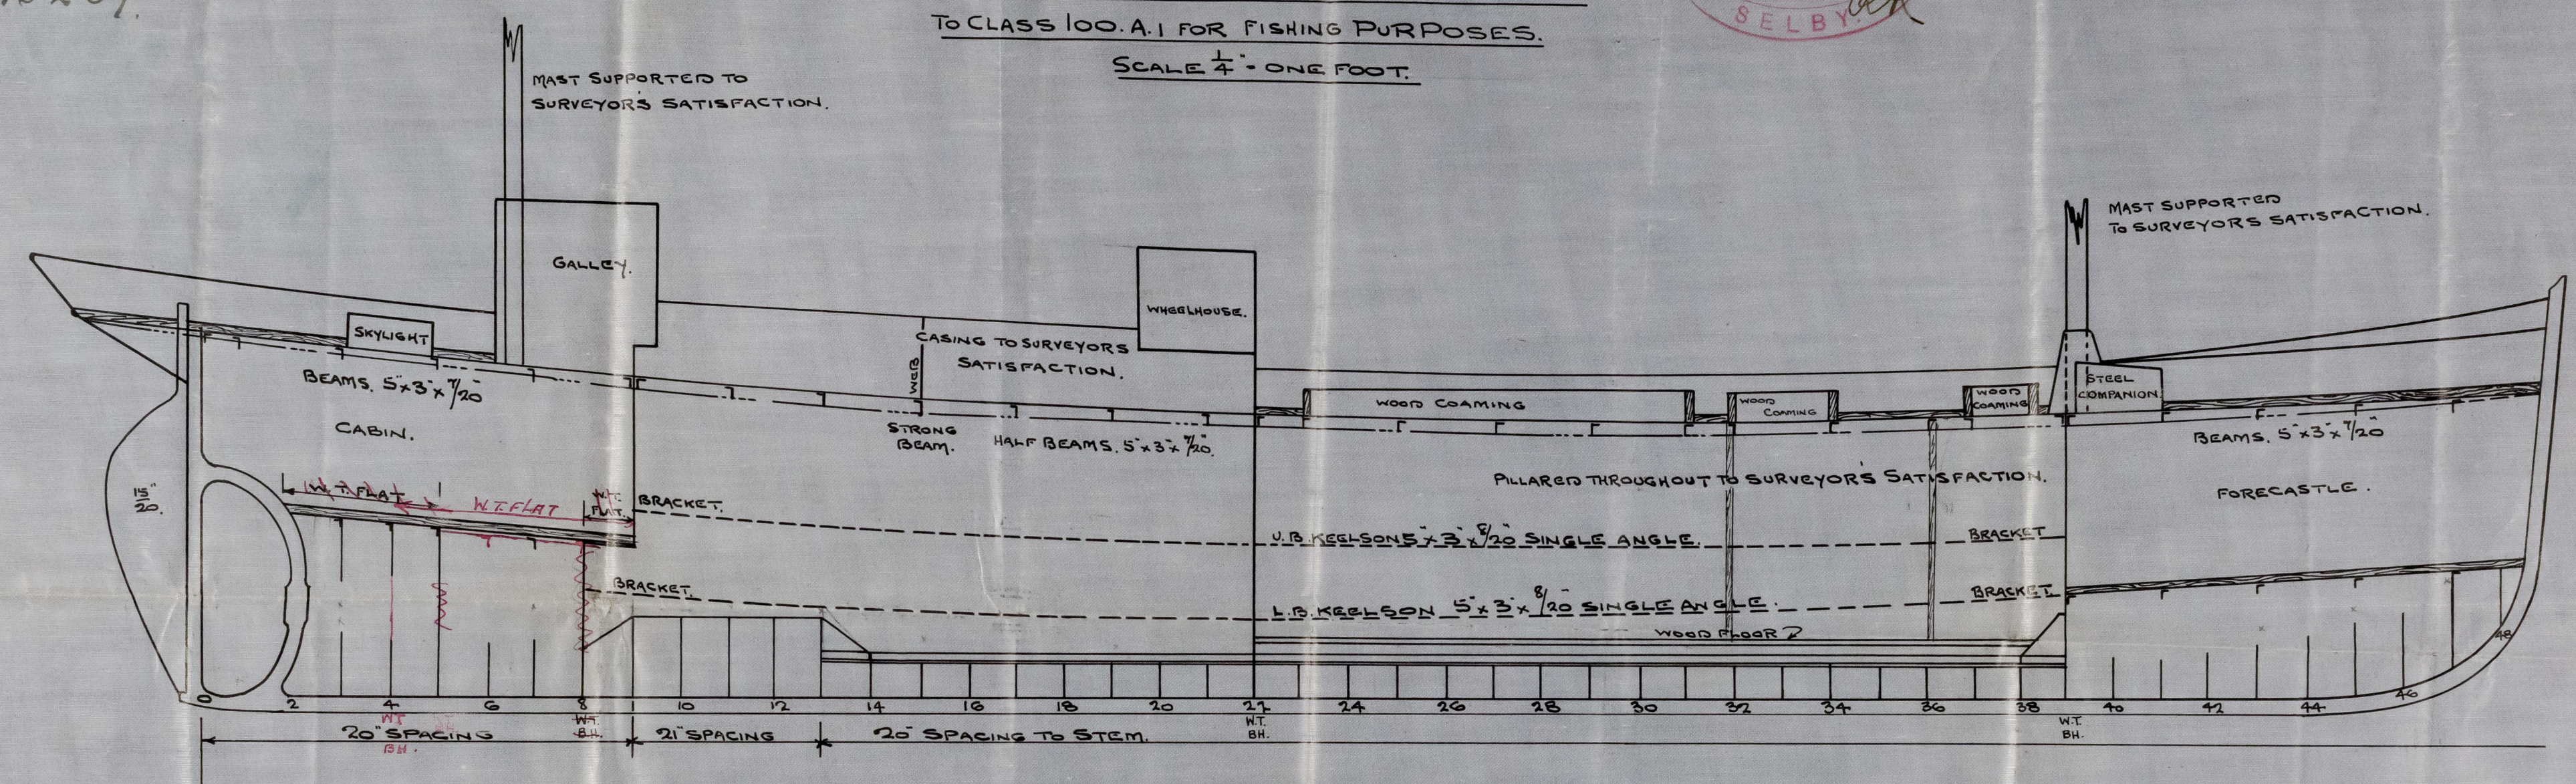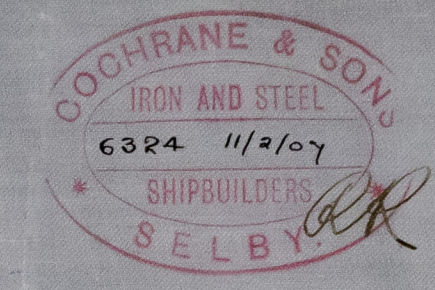

- DECK PLAN -

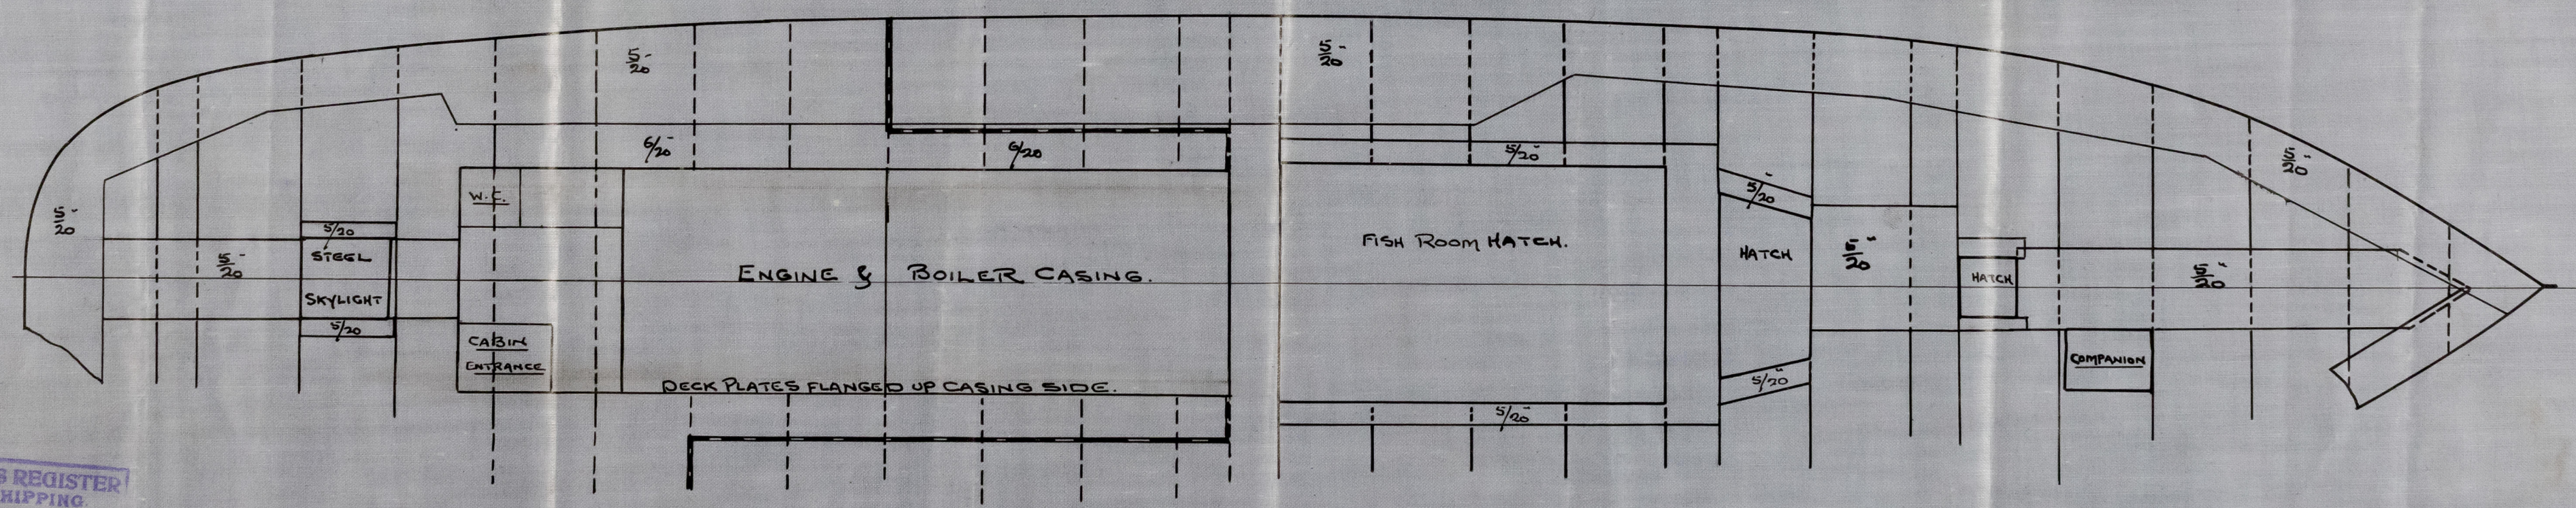


LLOYD'S REGISTER
 OF SHIPPING
 14 FEB. 1907
 + HULL +

16/2/07

Meys-Cochrane & Sons
No 413

Profiled Deck Plan
s/s. Fraserburg
Hull Report No. 19285

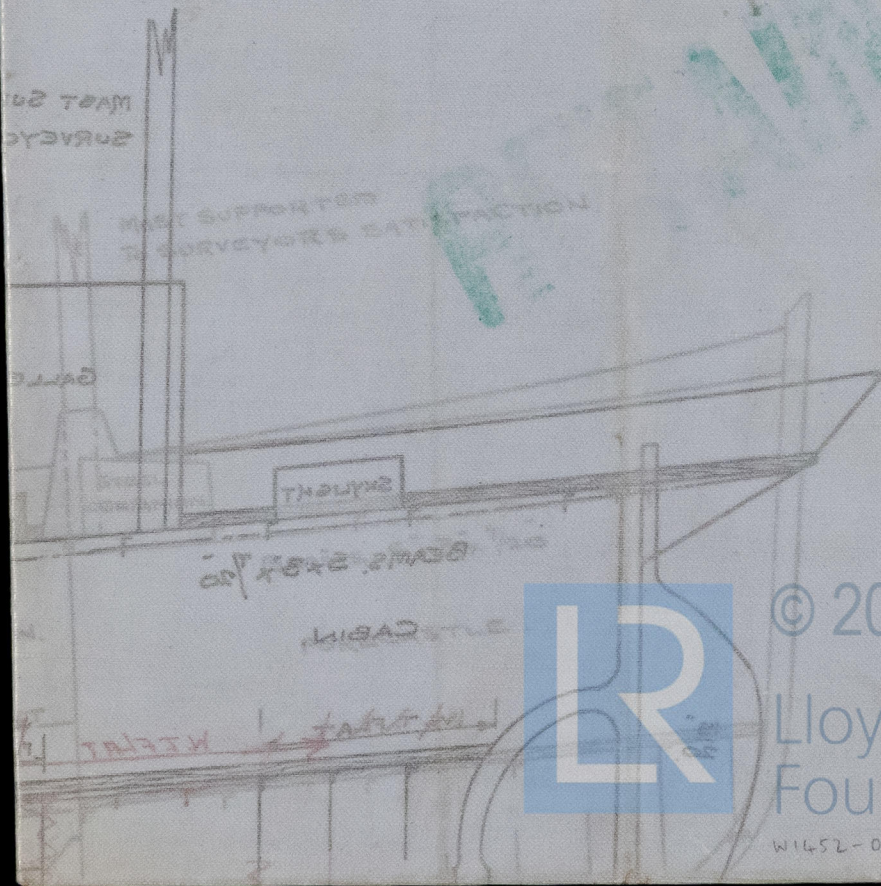

© 2021

Lloyd's Register
Foundation

W1452-0062