


9.11.01
6.12.01
4.1.02

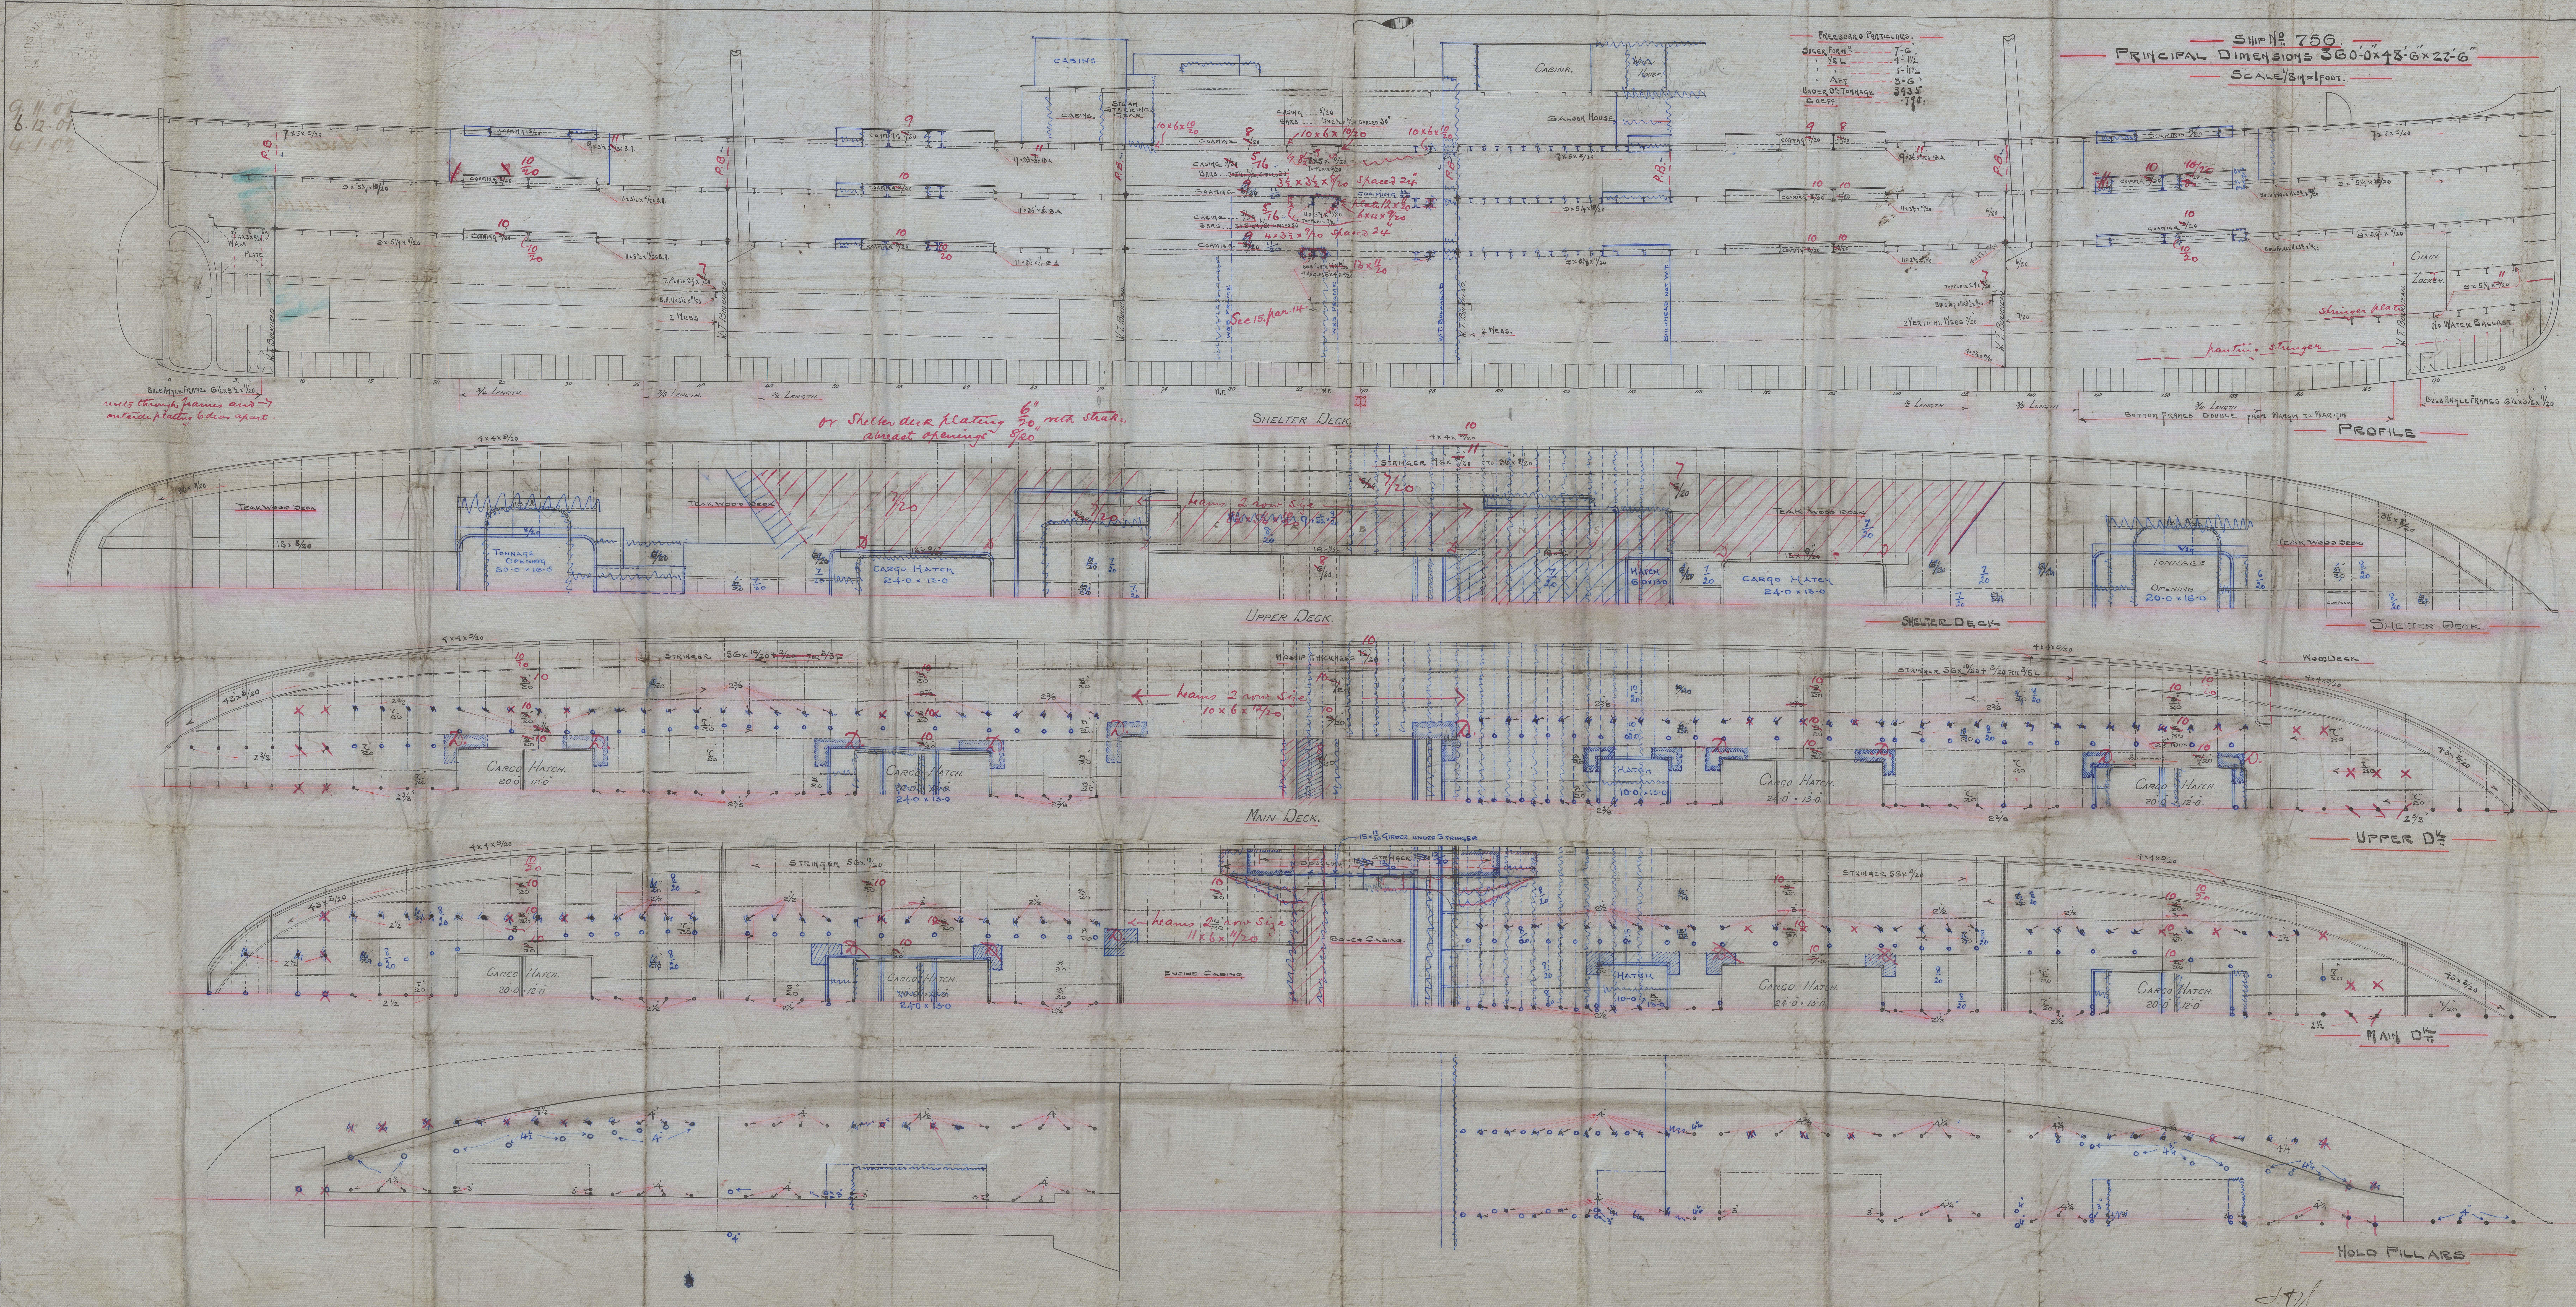

SHIP No 756
PRINCIPAL DIMENSIONS 360-0x48'-6x27'-6"
SCALE/SH=1 FOOT.

8th November 1901

Palmer's S. B. Co.

S. S. No 756.

3600" x 48'6" x 27'6" M.L.

S. S. Gracchus

Newcastle Report

No. 44168



© 2021

Lloyd's Register
Foundation