



29.3.00 (R 377)
26.4.00 (R 380)
18.6.00
26.6.00

SECTIONAL ELEVATION
DIMENSIONS - 350' 0" x 49' 0" x 29' 9" TO SPAR DECK, 21' 9 1/2" TO MAIN DECK.
TO CLASS 100 A.1 STEEL SPAR DECK.
SCALE 1/4" INCH = ONE FOOT.

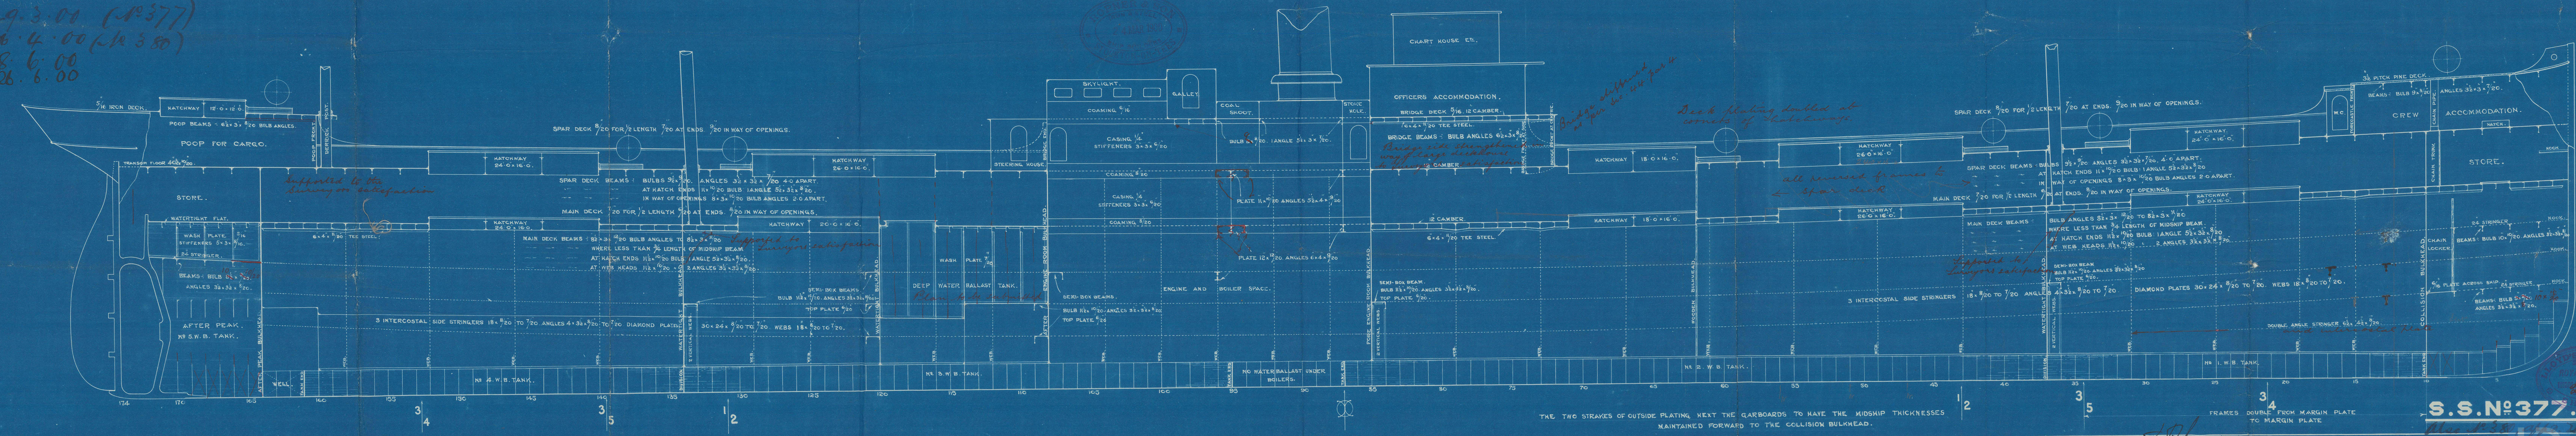

THE TWO STRAKES OF OUTSIDE PLATING NEXT THE GARBOARDS TO HAVE THE MIDSHIP THICKNESSES MAINTAINED FORWARD TO THE COLLISION BULKHEAD.

FRAMES DOUBLE FROM MARGIN PLATE TO MARGIN PLATE

S.S. N° 377

20/11/00
26.4.00

29-3-00
26-4-00

MIDDLESBROUGH-ON-TEES.

Sent with freeboard report
please return when done with.


W1459-0114 1/2

RETAIN

Profile
Ropner Hon's
No 344 1380

S. S. Germanicus' (377)
Mbro' Report No 3025.

S. S. Elba (388)
Nat 3081.

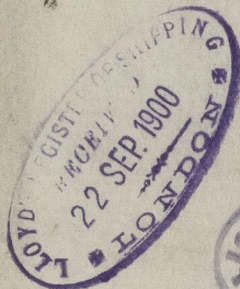

W1459-0114



Lloyd's Register
Foundation