


was p marked
1 E.C.M.
New P. P. 1912

6.2.12
12.2.12
14.2.12


20122-11 1/2 ft 11 1/2 ft
20122-11 1/2 ft 11 1/2 ft

N^o 531
PROFILE & DECK PLAN
DIMENSIONS: 68'-6" B.P. x 17'-6" M.L.D. x 6'-10" M.L.D.
SCALE 1/4" = 1 FT.

PLAN No. 1198
FOR ENCLOSURE TO
Messrs Lloyd's Surveyors
Hull FROM
COCHRANE & SONS,
SHIPBUILDERS, SELBY.
DATE Feb 2nd 1912 RK

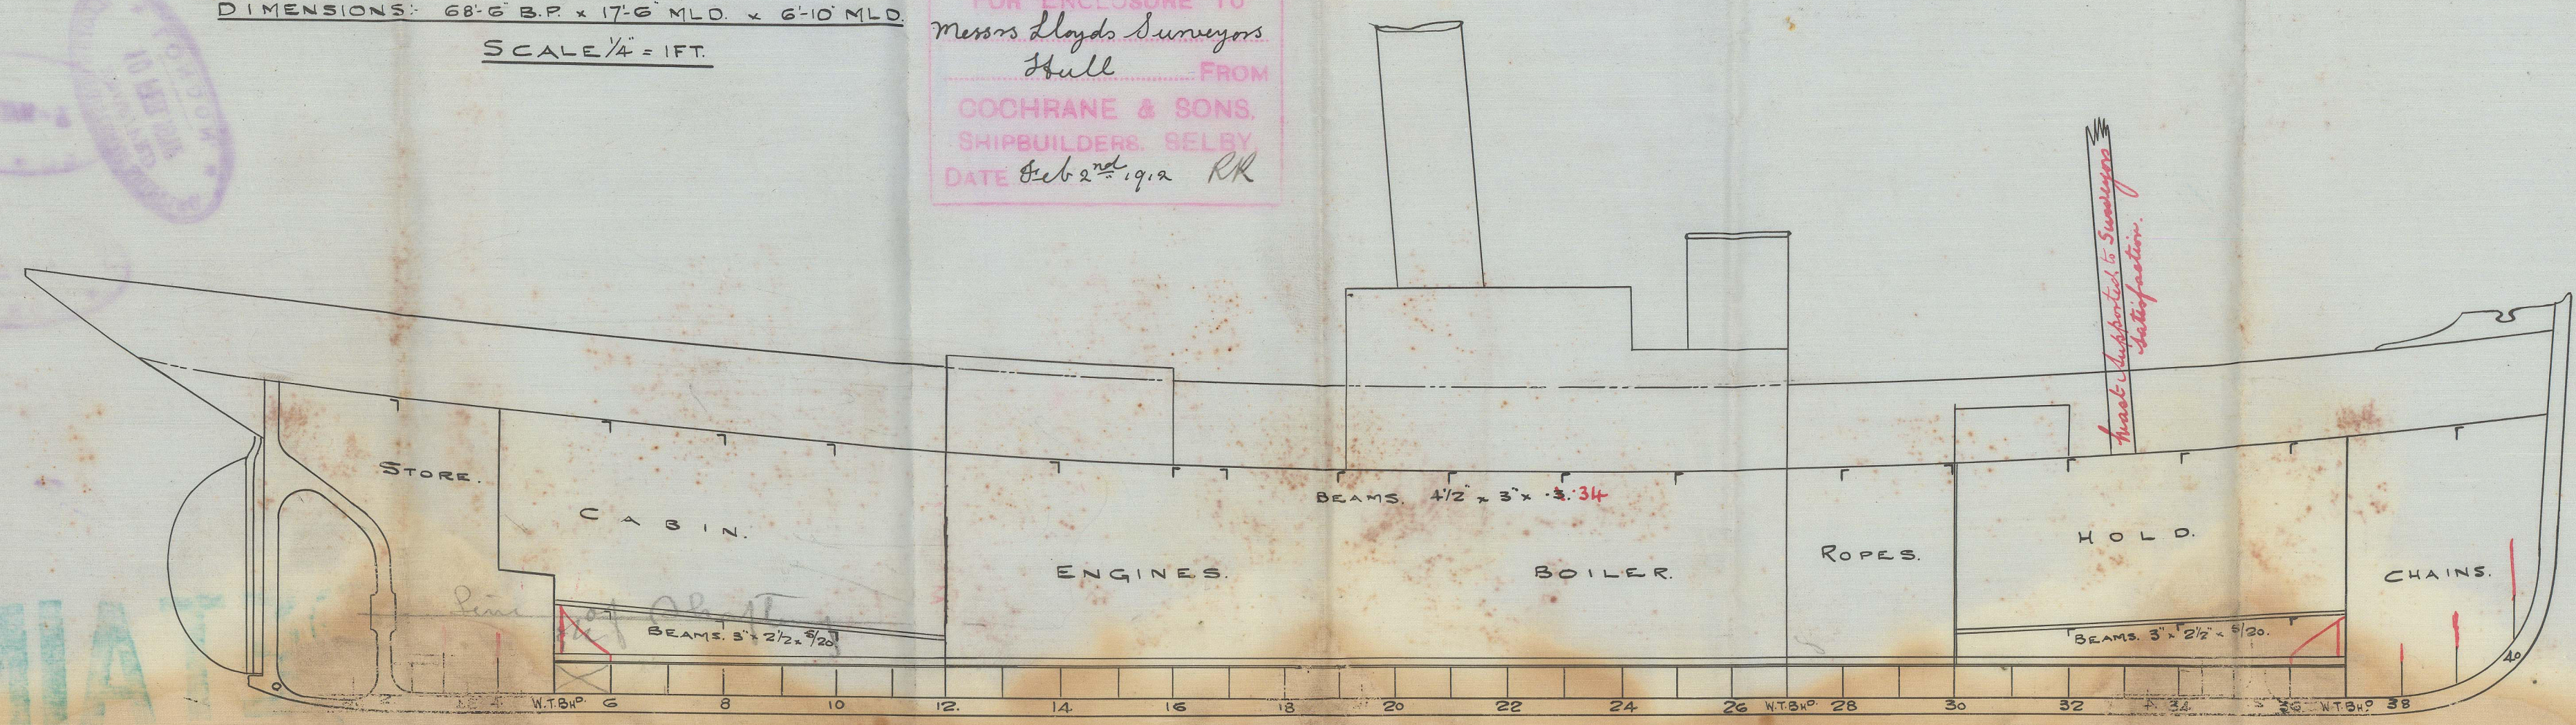

Pillaring throughout to Surveyors Satisfaction

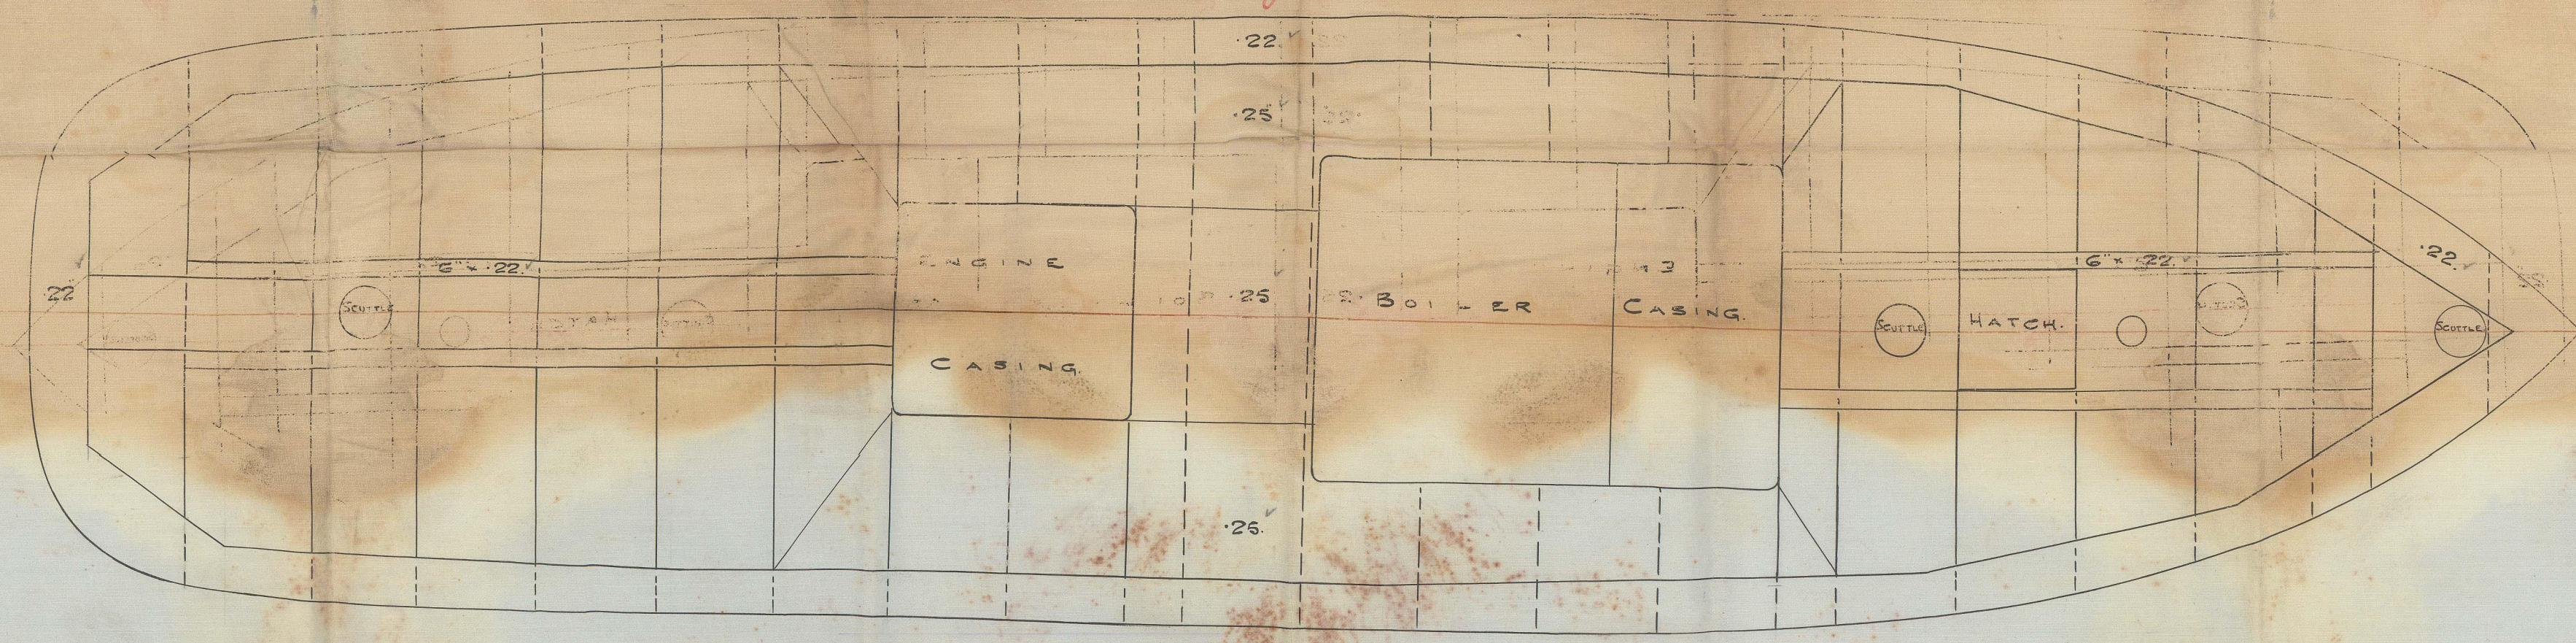

C.B.
6.2.12

RECEIVED
LLOYD'S REGISTER
5 FEB 1912

LLOYD'S REGISTER
OF SHIPPING
5 - FEB 1912
HULL, N.

Cochrane & Sons
No. 531

Profile & Deck.

$\frac{1}{2}$ Germano 3°

Shall Rpt No: 25165

W1459-0149



© 2021

Lloyd's Register
Foundation