

6.2.12  
12.2.12  
14.2.12

# MIDSHIP SECTION

STEEL HULL FISHING VESSEL


166N9531

SCALE 3/4" = 1 FOOT

CLASS 100. A. FOR FISHING PURPOSES.

DIMENSIONS: 38' 6" B.P. x 17' 6" M.L.D. x 6' 10" HULDED.

PLAN No. 1196  
FOR ENCLOSURE TO  
Messrs. Lloyd's Surveyors  
Hull FROM  
COCHRANE & SONS  
SHIPBUILDERS, 351 BY  
DATE Feb 2nd 1912 R.R.

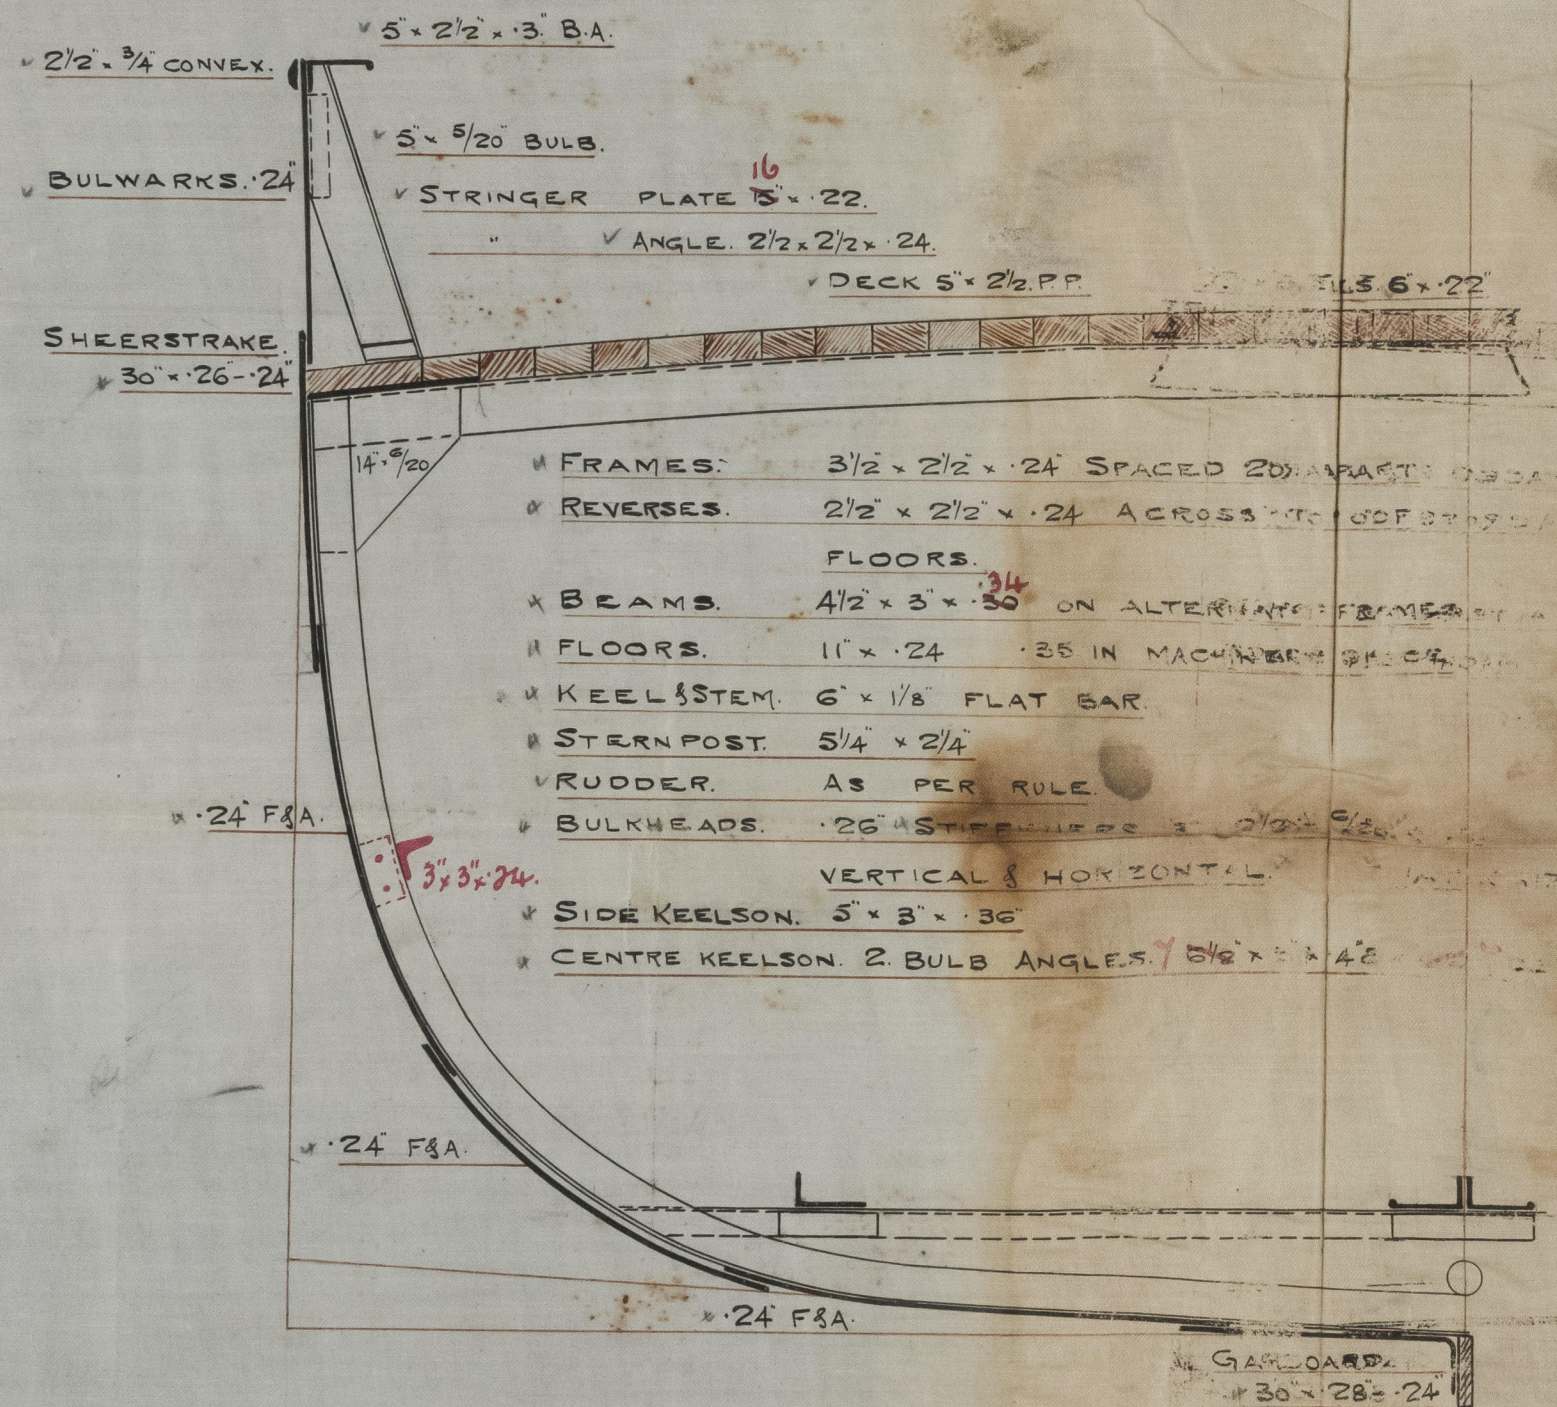

## NUMERALS.

B+D 24.33  
Lx(B+D) 1666.6

## PROPORTIONS.

L/D = 10.02. L/B = 3.92.

## EQUIPMENT.

2 ANCHORS. 2 1/2 CWTs EX STOCK.  
1 " 1/2 " " "  
60 FATHOMS. 1 1/8" STUDLINK CABLE.  
60 " 4 1/2" HAWSER.  
60 " 2 1/2" WARP.

## RIVETING.

BUTTS OF SHELL PLATING LAPPED & DOUBLE RIVETED EXCEPT GARBOARD & SHEERSTRAKE WHICH ARE TO BE STRAPPED & DOUBLE RIVETED LANDING EDGES TO BE DOUBLE RIVETED EXCEPT TOP EDGE OF SHEERSTRAKE WHICH IS SINGLE RIV. BUTTS OF STRINGER & TIE PLATES LAPPED & DOUBLE RIV.

C.B.  
6.2.12.

asw  
5.2.12

10 FEB 1912

LLOYD'S REGISTER OF SHIPPING  
5 FEB 1912  
HULL


W1459-D150



Cochran & Sons,  
No 531  
Midship Section.

$\frac{4}{5}$  Germano 3°

Hull Report No: 25/65.

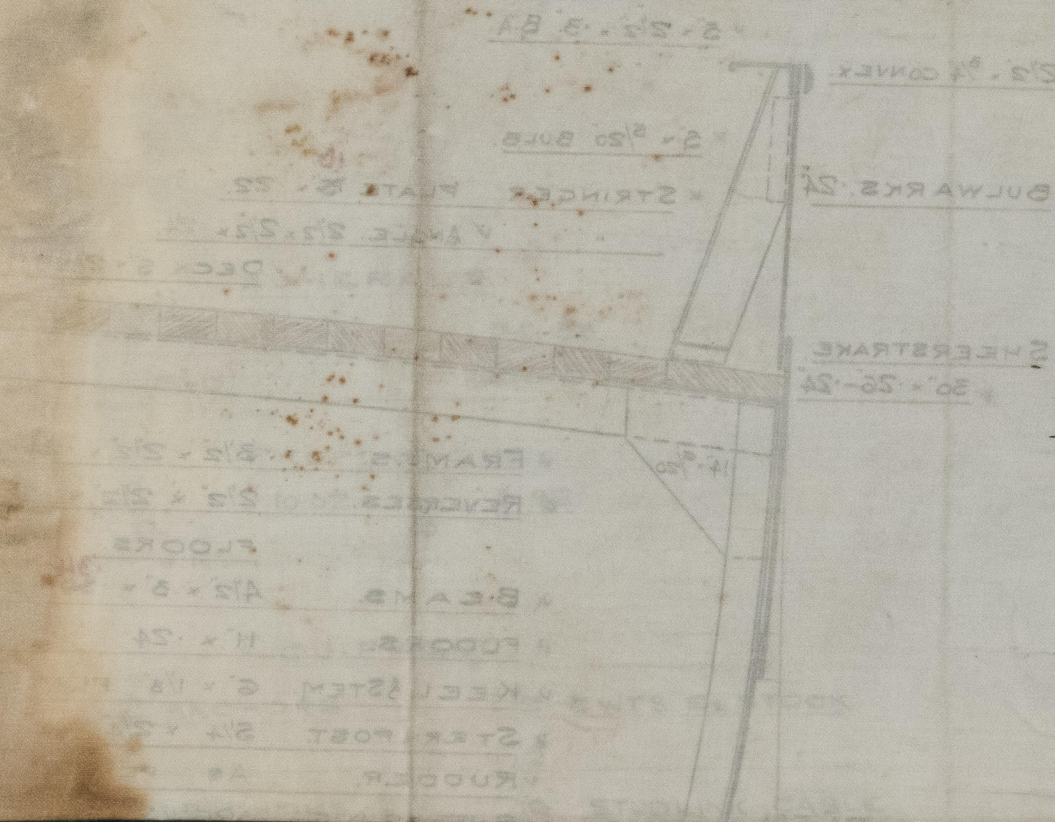

© 2021

Lloyd's Register  
Foundation

W1459-0150