

SSN 88-9 & 92-3

# MIDSHIP SECTION

EQUIPMENT N° 4509

## NUMERALS

1/2 GIRTH	18 416
DEPTH	12 5
1/2 BREADTH	10 3
1ST N°	41416
LENGTH	108 875
2ND N°	4509 167

## STEEL SCREW TRAWLERS

DIMS 110-0-21-0 x 12-0 MLD

SCALE 1/2" = 1 FOOT

TO CLASS 100A1 AT LLOYDS

1 ANCHOR 4 3/4 CWTs EX STOCK

1 4 1/4 " " "

1 2 1/2 " " "


90 FATHOMS 1 1/2" STUD LINK CHAIN

60 5 1/2 HAWSER

60 4 WARP

$$\frac{L}{B} = 5.18$$

$$\frac{L}{D} = 8.71$$

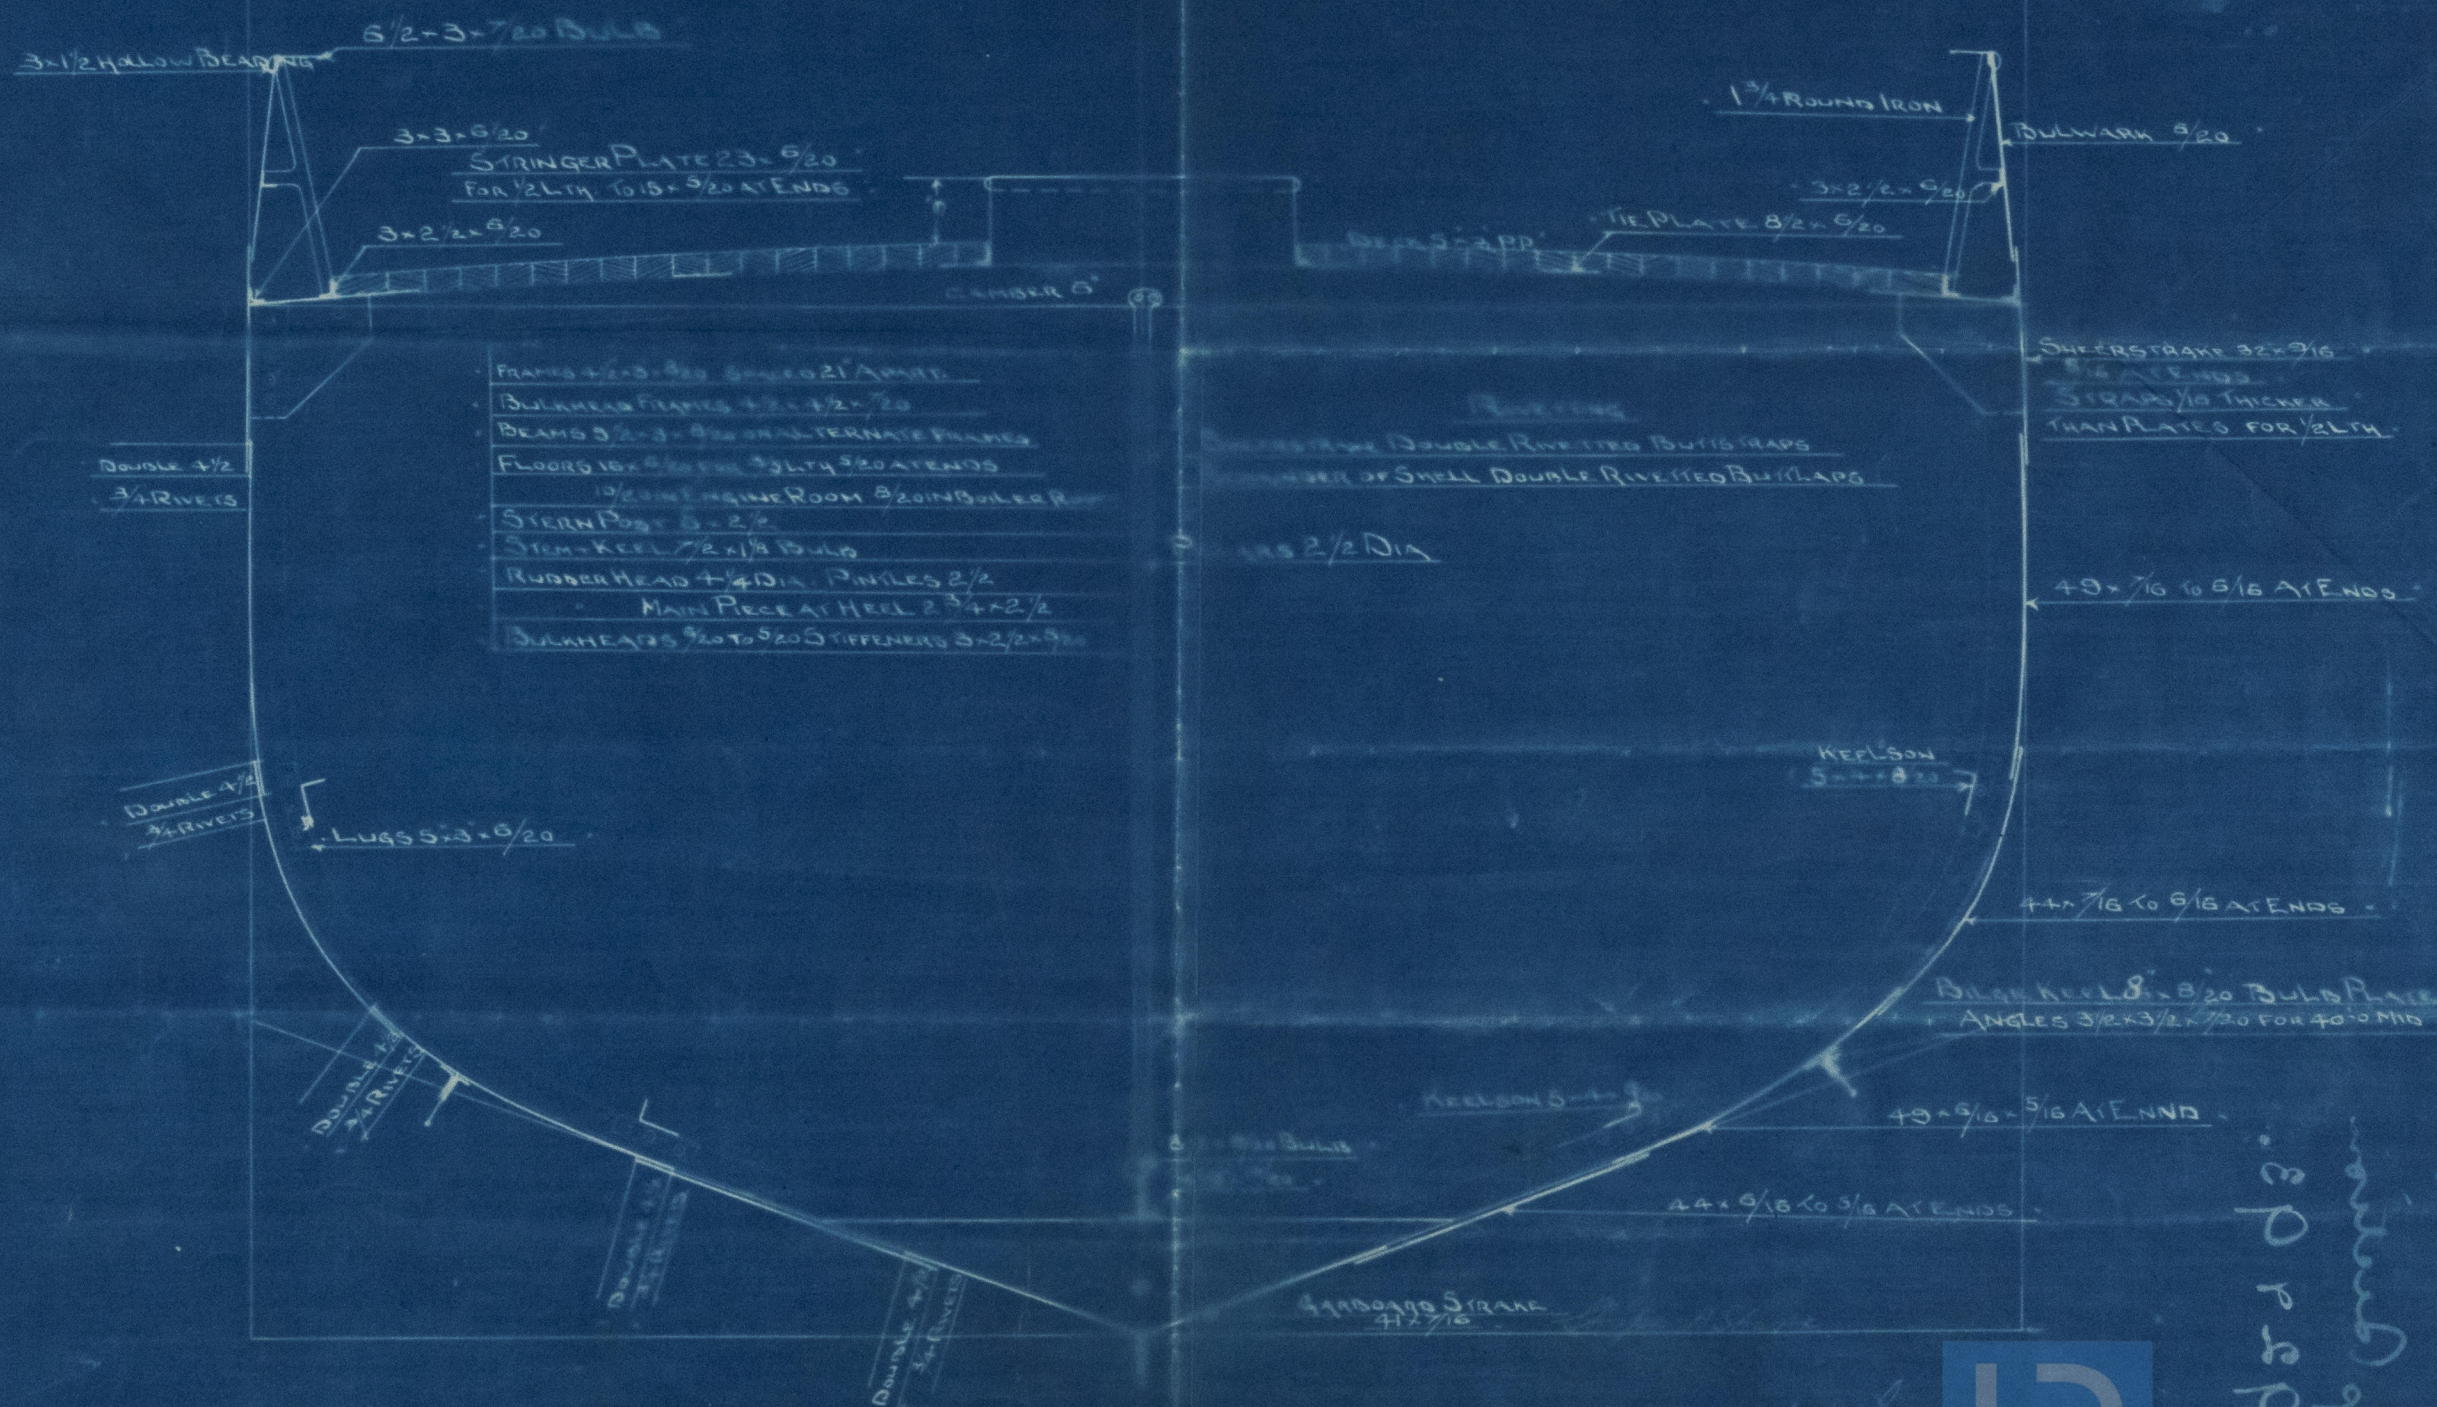

- FRAMES 4-2-3-5/20 5-10-21' APART
- BULKHEAD FRAMES 4-2-1-1/2-7/20
- BEAMS 5/2-3-5/20 ON ALTERNATE FRAMES
- FLOORS 15-8-20 3/4 LTH 5/20 AT ENDS
- 10' LONG HAWSE ROOM 5/20 IN BULKHEAD
- STERN POST 5-2-2
- STEM KEEL 7/2-1-1/4 BULB
- RUBBER HEAD 1-1/4 DIA. PINNLES 2-1/2
- MAIN PIECE AT HEEL 2-3/4-2-1/2
- BULKHEADS 5/20 TO 5/20 STIFFENERS 3-2-2-5/20



16 28 + 80  
108 + 22 91  
108 + 22 91  
108 + 22 91

12/4/06  
25/4/06

W1461-0116



Nos 88-89, 92 & 93.  
Duplicate.  
Midship Section

MIDSHIP  
N<sup>o</sup> 92-3.

N<sup>o</sup> 89. ~~East~~ "Guelu".  
Hull Report No 18424

RETAIN

W1461-0116



© 2021

Lloyd's Register  
Foundation