

SS 16629
Midship Section

Dimensions 365'0" x 51'3 1/2" x 29'6" Mid upper Wk

Class 100 A Lloyd's 3 Week Rule




1.8.07
24.9.07
5.10.07
11.10.07
21.1.08

Materials	Equipment General	3959.0
5 Batts 62.65'	104.24'	363.14
3 Beam 29.64'	Rep 29.14	
104.24'	Bridge 33.33	
109.04'	Forecastle 40.00	
102.01'	102.00' x 4.15	1001
102.04'		41.91



Midship Section
Sir J. Laing & Son
No 629

sp. "Lutetian"
See report
No 23862

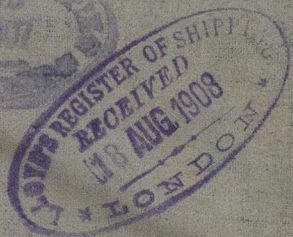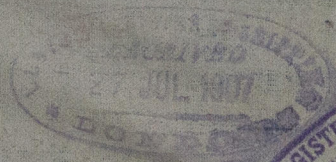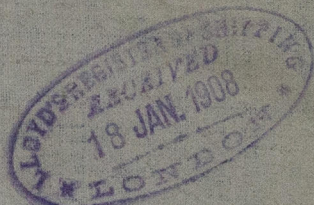

© 2021

W147-0170

Lloyd's Register
Foundation