




110-1014

SHIP No.	623
PLAN	6
SUB	3
DATE	24-7-07

1-8-07
24-9-07
5-10-07
11-10-07
21-1-08

5510629
Profile and Deck Plans
Dimensions 360 x 51-35 x 29-6. Old Upper Deck
Class 100 A1 Lloyd's 3 Deck Rule
Scale 1 inch = 1 foot

arrangement of thick plating in way of Bridge end

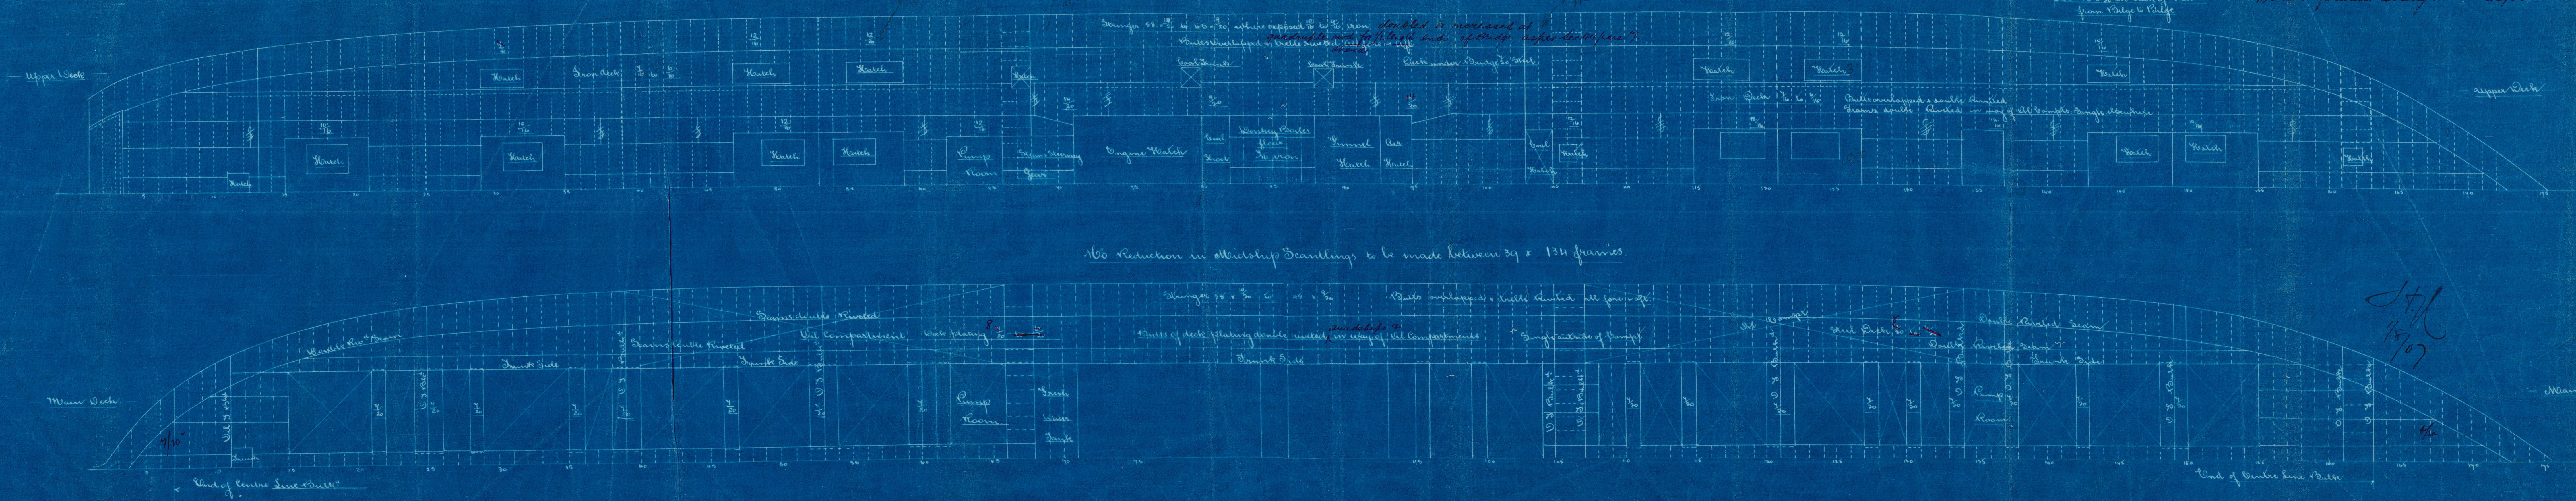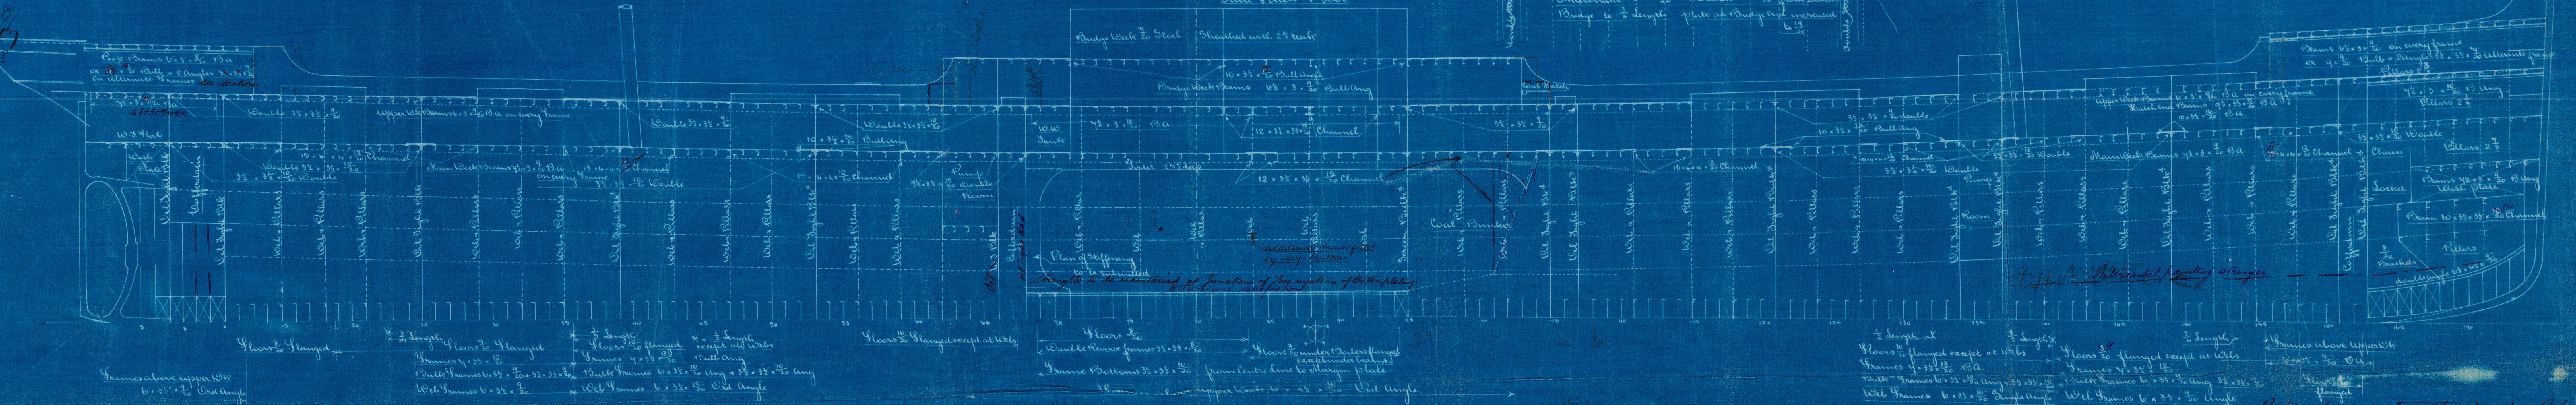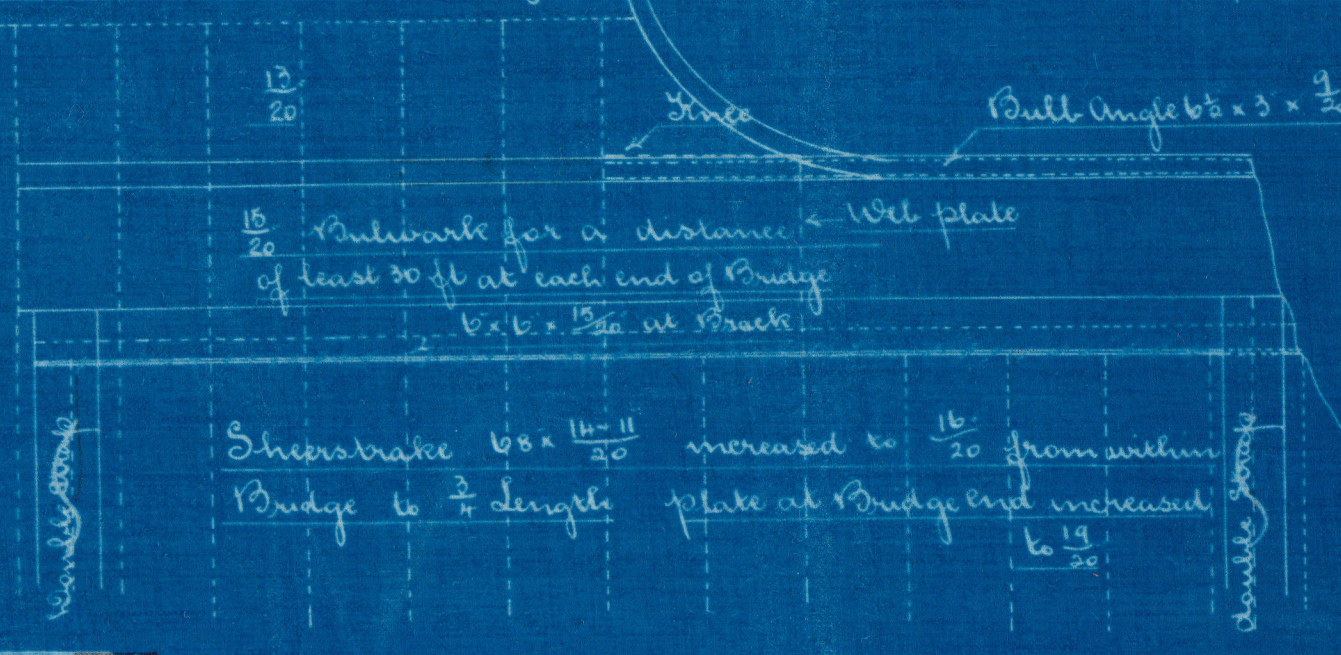

Bottom forward strengthened as per Rule




160 Reduction in Meshship Scantlings to be made between 29 x 134 frames

24/1
18/07

25/07
2562

Profile
Sir J. Laing & Sons
No 629

"¹⁰Autetian"
Storeport No 25802

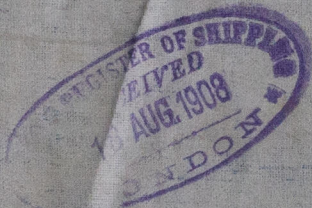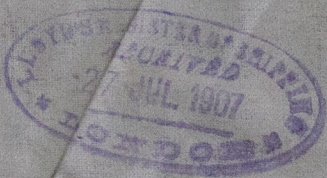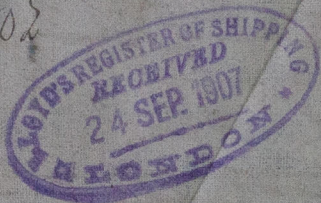

W147-0171

0-1-17
0-1-11
0-1-5
0-6-17
0-8-1

W147-0171



© 2021
Lloyd's Register
Foundation