

and 1 maul  
0221  
water 6 gals  
150 lbs. 200 lbs.

31. 10. 11

# MIDSHIP SECTION

STEEL SCREW TRAWLER

No 520

DIMS 119'-0" x 22'-0" EX x 12'-3" MD


SCALE  $\frac{1}{2}$ " = ONE FOOT.

PLAN No. 841  
FOR ENCLOSURE TO  
Messrs Lloyd's Surveyors  
Hull FROM  
GOCHANE & SONS,  
SHIPBUILDERS, SELBY.  
DATE October 27<sup>th</sup> 1911. PK

TO CLASS 100 R.I. FOR FISHING PURPOSES

DECK PLATED OVER IN WAY OF MACHINERY. ✓

E + B. CASING AS PREVIOUSLY APPROVED. ✓

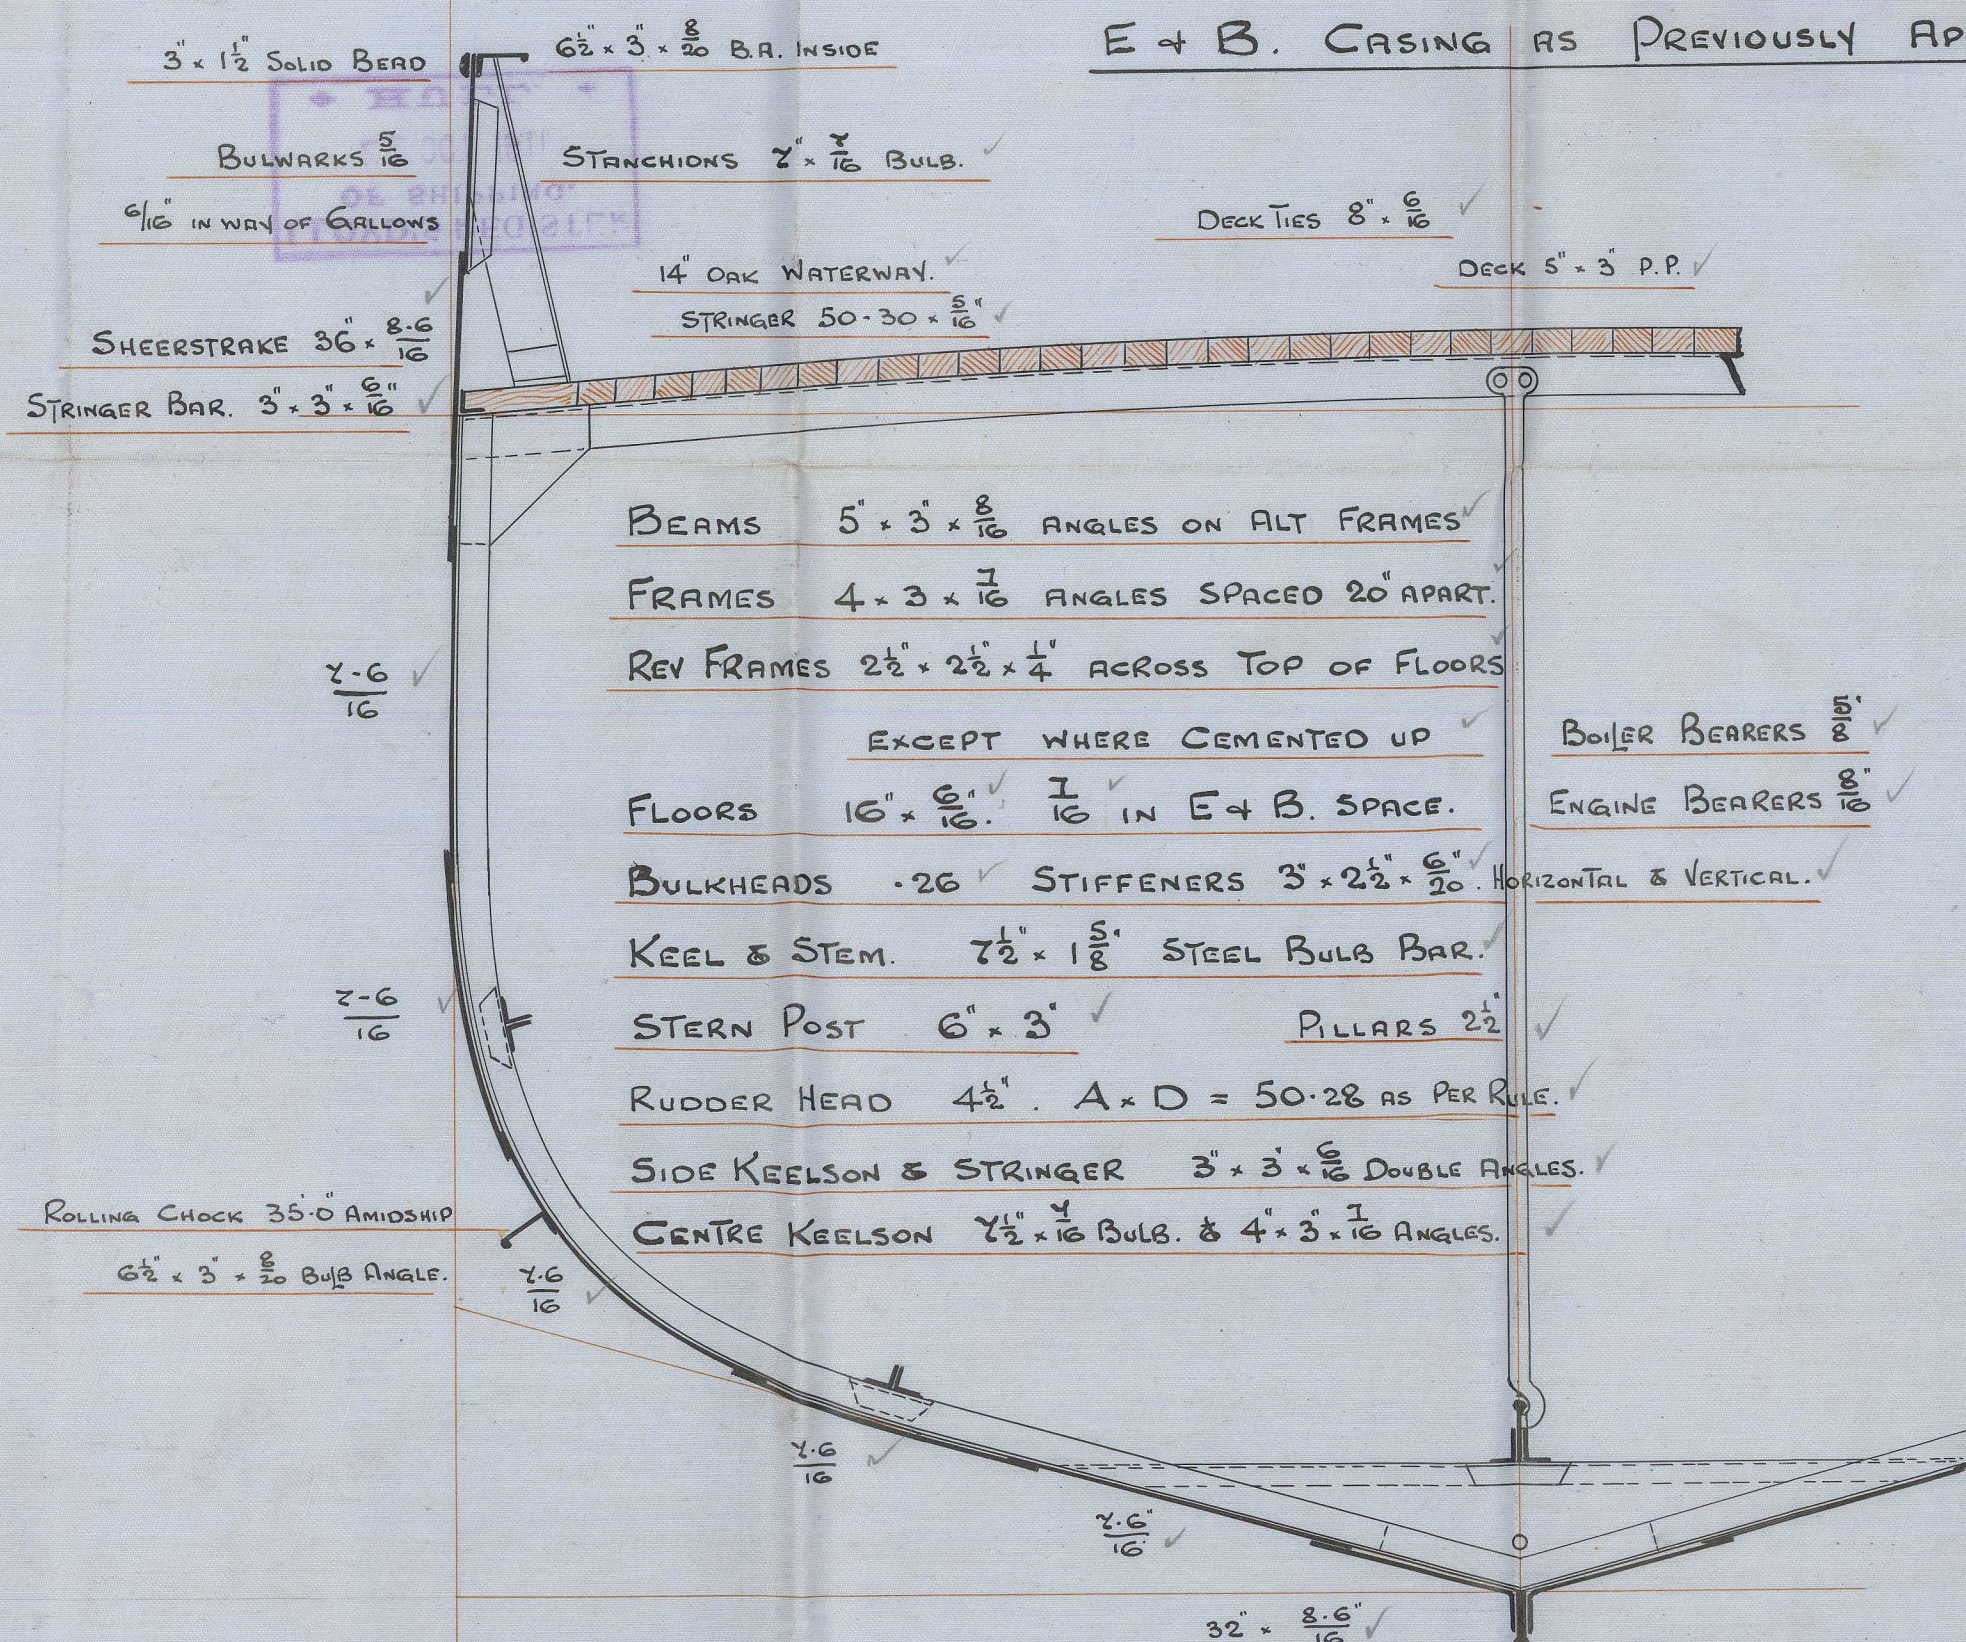

## EQUIPMENT

1ST BOWER ANCHOR	5 1/4 CWTs EX STOCK. OR 6 1/2 CWT STOCKLESS ✓
2ND " "	4 3/4 " " " OR 6 CWT. " ✓
KEDGE	2 1/2 " " " ✓
90 FATHOMS	1" STUD LINK CABLE
60 "	6" HAWSER.
60 "	4 1/2" WARP.

## NUMERALS

$$B + D = 34.15. ✓$$

$$L \times (B + D) = 4063.85. ✓$$

## PROPORTIONS

$$\frac{D}{L} = 9.71 ✓$$

$$\frac{B}{L} = 5.43 ✓$$

## RIVETING

BUTTS OF GARBOARD & SHEERSTRAKE STRAPPED AND DOUBLE RIVETED. REMAINDER OF SHELL OVERLAPPED & DOUBLE RIVETED. BULWARKS SINGLE RW<sup>2</sup> LANDINGS DOUBLE RIVETED EXCEPT TOP EDGE OF SHEERSTRAKE. WHICH IS TO BE SINGLE. ✓

C.B.  
31. 10. 11.



Cochran & Sons  
No. 520  
Midship Section  
Duplicate of No. 477.

2 Hondo  
Hull Rpt No. 24990

MIDSHIP SECTION

STEEL SCREW TRAWLER

No 520


Dim 119'0" x 22'0" ex x 12'3" mo

Scale 1" = ONE FOOT.

To Class 100 A.1. for Fishing Purposes

Deck Plated over in Way of Machinery

E + B. Casings as previously approved.

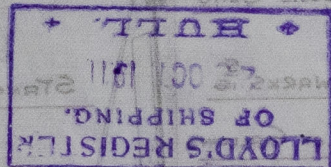

RETAIN

EQUIPMENT

1st Bower Anchor

W1470-0098



© 2021

Lloyd's Register  
Foundation